F.A.S.
172B(1) 1942 B 83

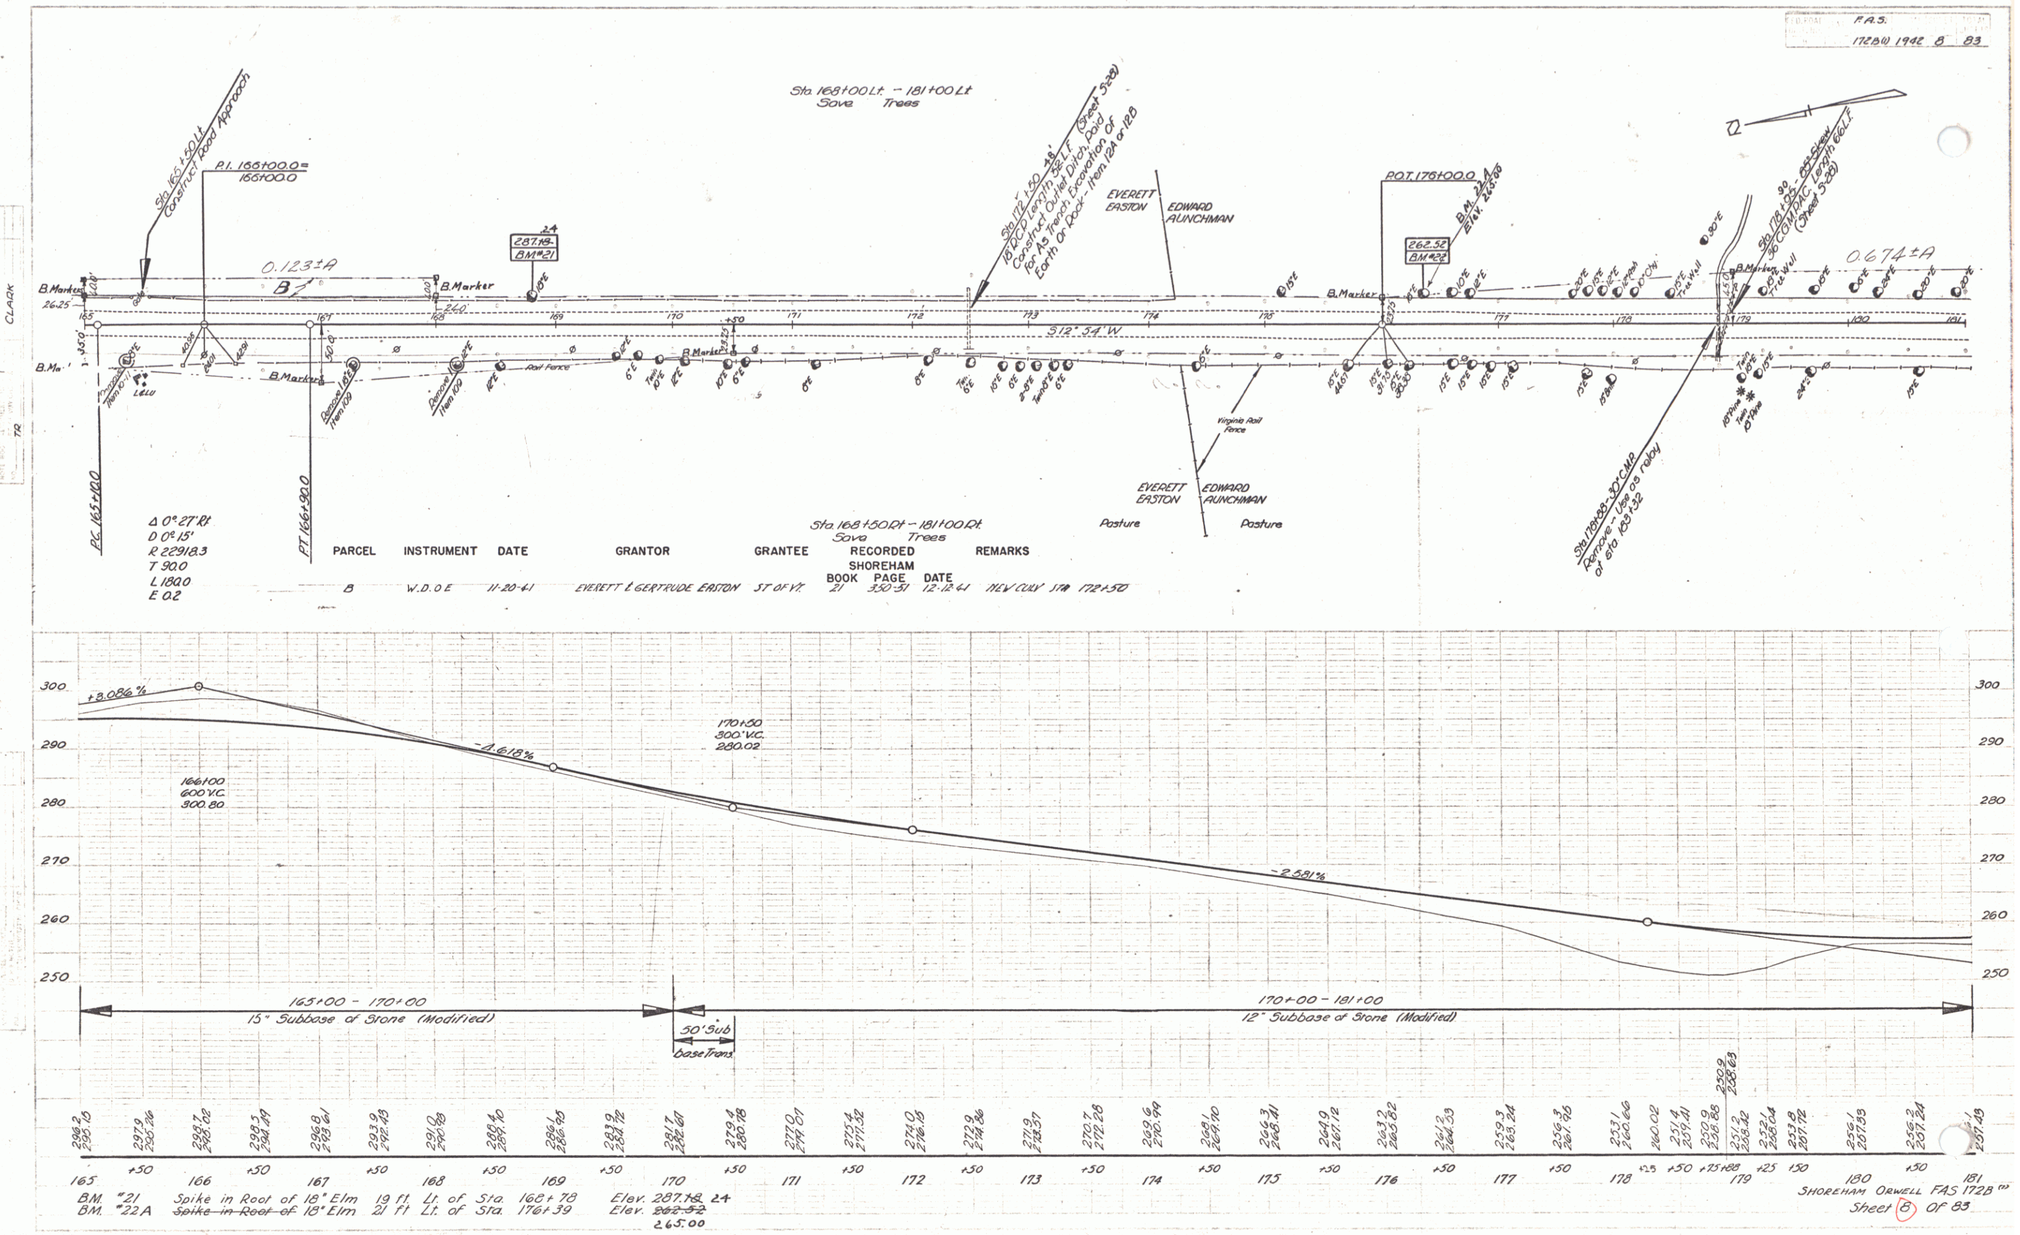

PARCEL	INSTRUMENT	DATE	GRANTOR	GRANTEE	RECORDED SHOREHAM BOOK	PAGE	DATE	REMARKS
B	W.D.O.E	11-20-41	EVERETT & GERTRUDE EASTON	ST. OF VT.	21	330-31	12-12-41	NEW COUN. STA. 172+50

Station	Elevation
165	296.2 / 295.15
+50	297.9 / 295.86
166	298.7 / 296.02
	257.49

B.M. #21 Spike in Root of 18" Elm 19 ft. Lt. of Sta. 168+78 Elev. 287.18 24
B.M. #22A ~~Spike in Root of~~ 18" Elm 21 ft. Lt. of Sta. 176+39 Elev. ~~282.52~~ 265.00

SHOREHAM ORWELL FAS 172B(1)
Sheet 8 of 83

6