


PLAN  
 SURVEYED BY: *Fantoni*  
 DATE: *11/68*  
 NOTE BOOK: *11/68*  
 REVISIONS:  
 NO. BY DATE

PROFILE  
 SURVEYED BY: *Fantoni*  
 DATE: *6/68*  
 NOTE BOOK: *11/68*  
 REVISIONS:  
 NO. BY DATE

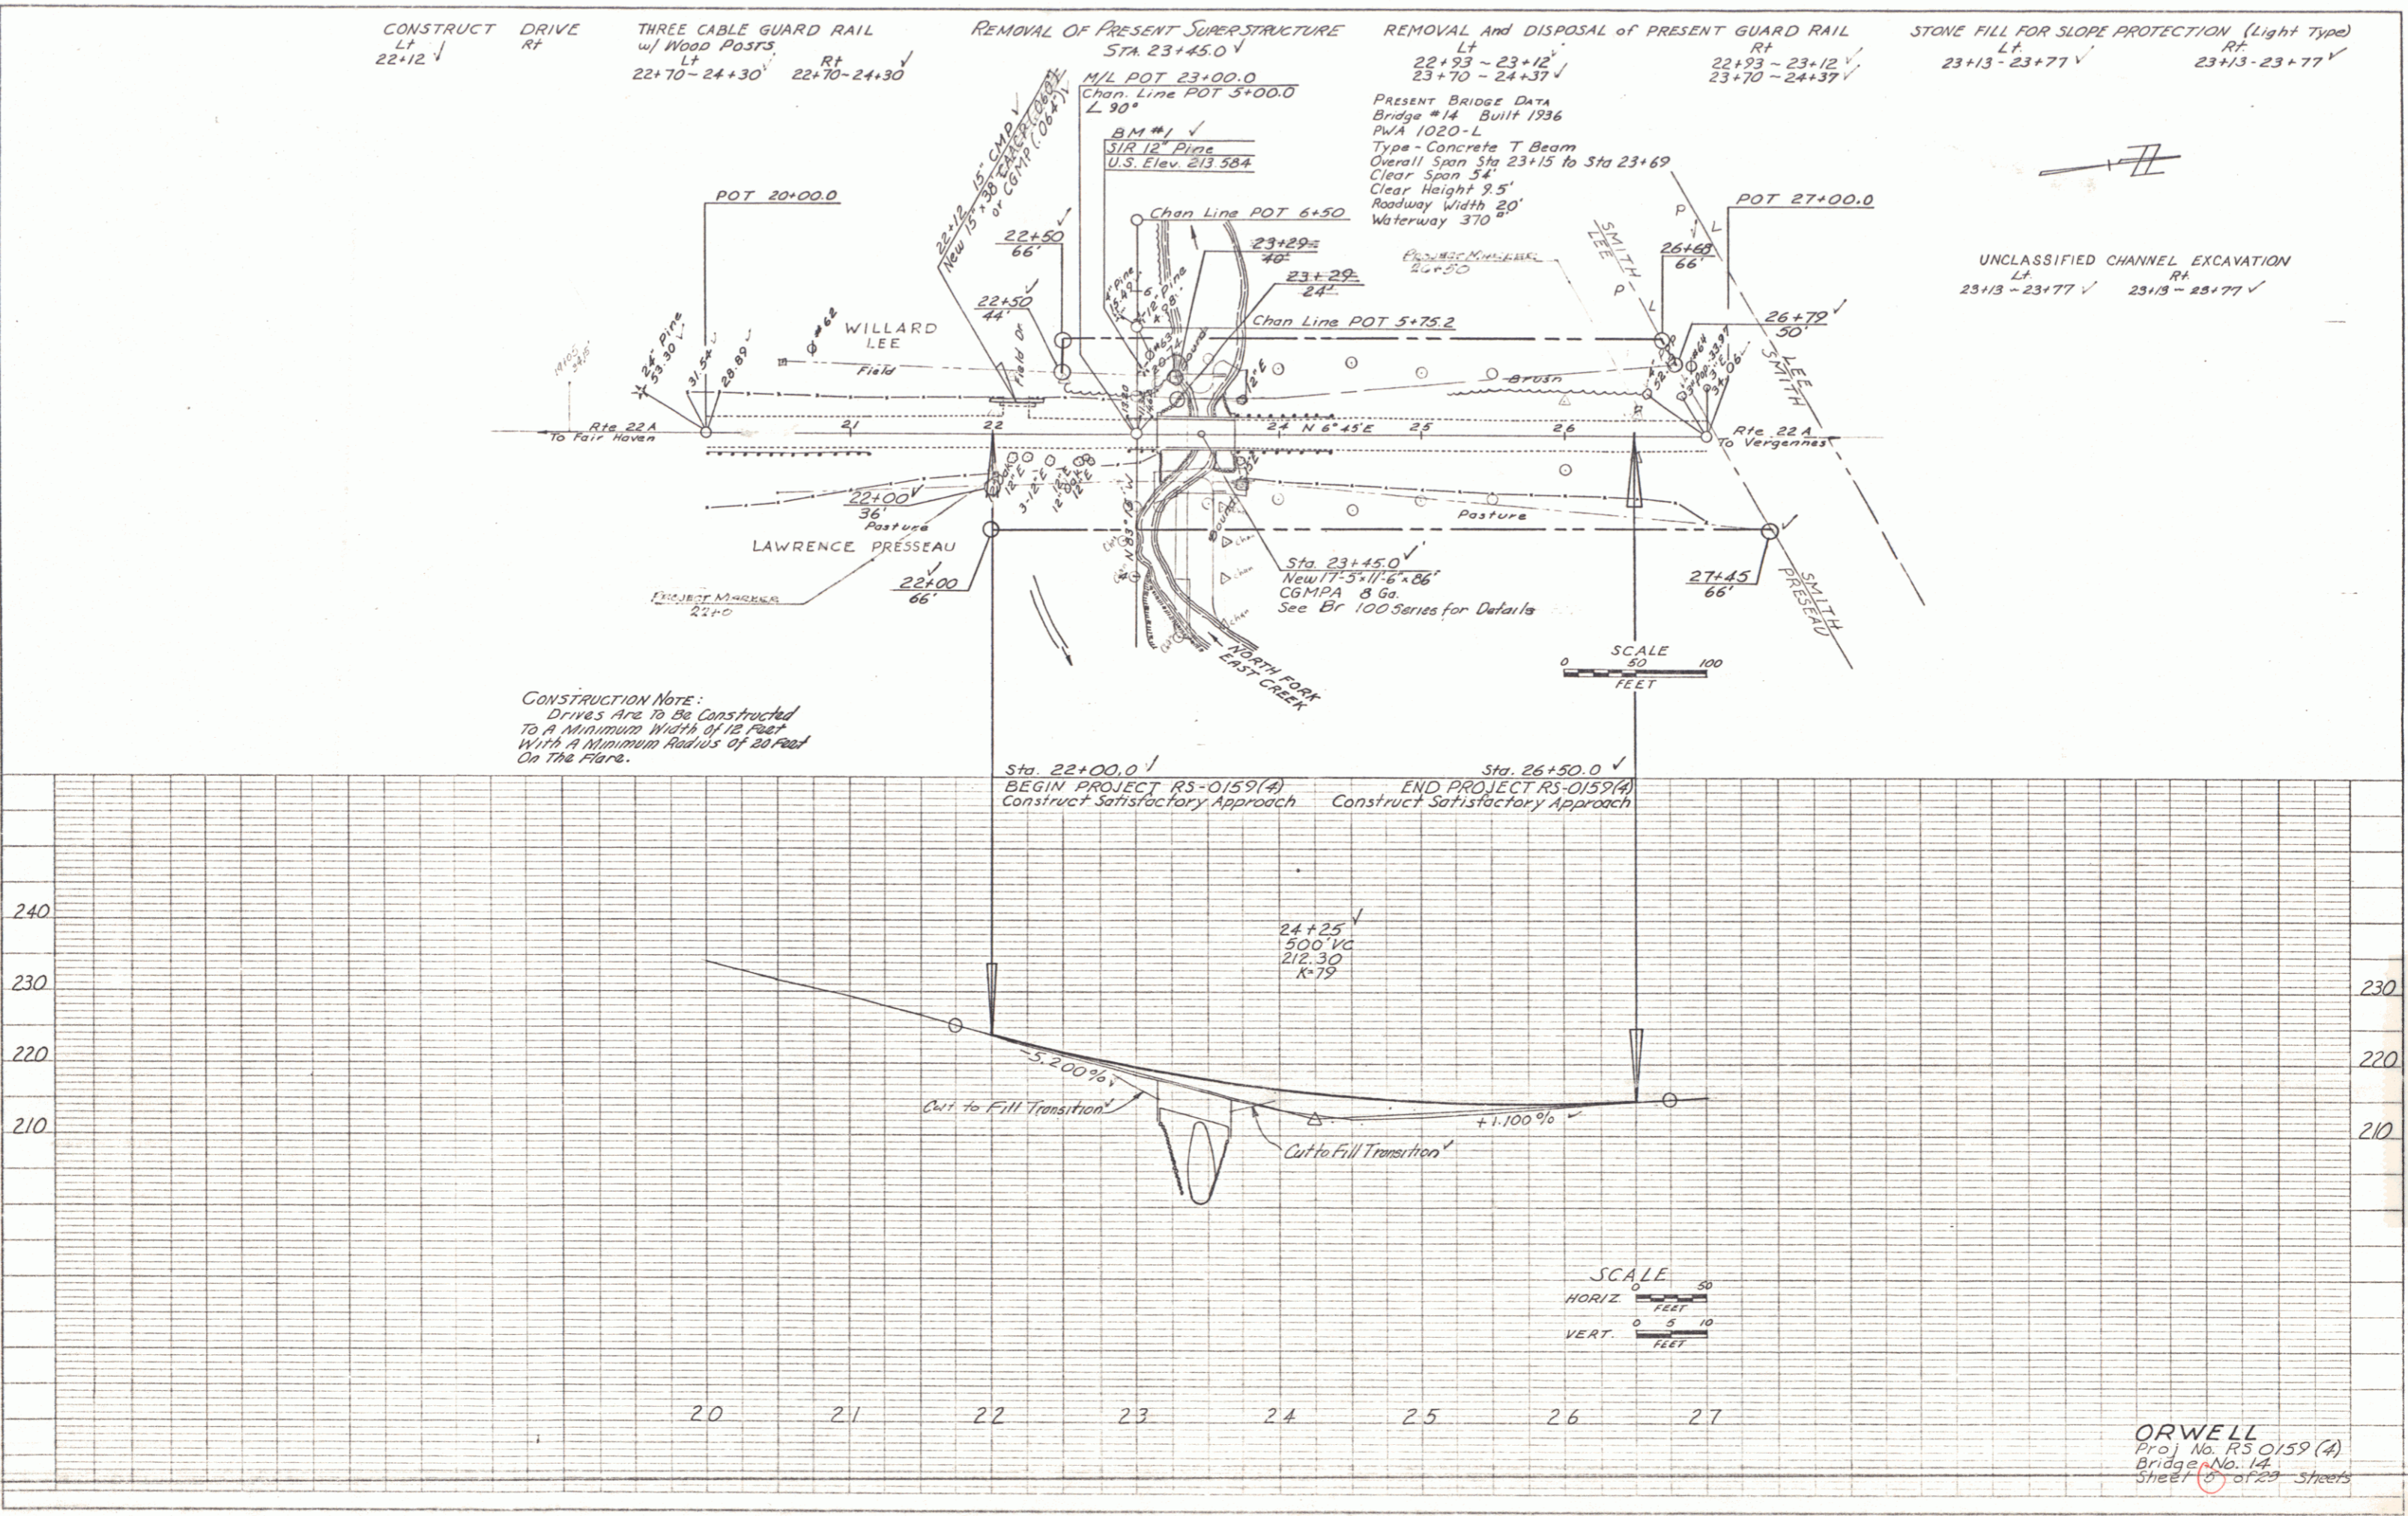

ORWELL  
 Proj No. RS-0159 (A)  
 Bridge No. 14  
