FED. ROAD DIST. NO.	STATE	F.A.S.	FISCAL YEAR	SHEET NO.	TOTAL SHEETS
		172 (1939)	1939	5	24

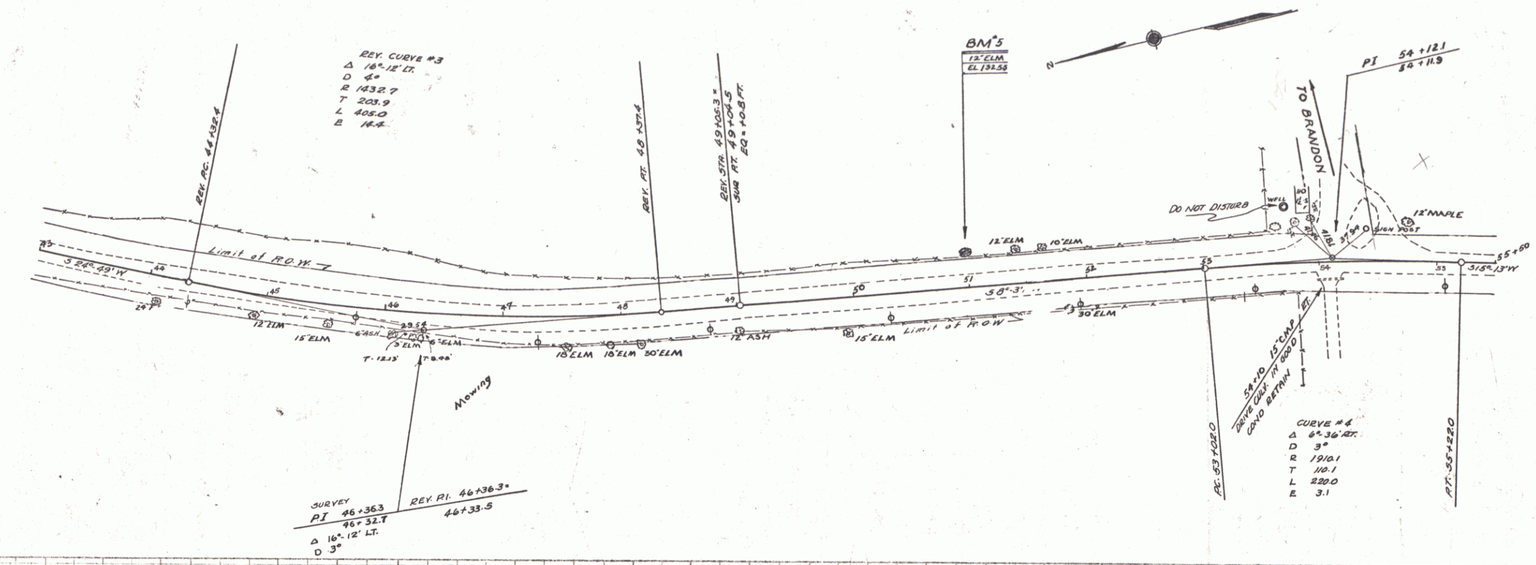

PLAN
PROFILE
NOTES
ROAD MASTER
CHECKED
ESTIMATES CHECKED
ALL OF WTT DISCUSSED
BY

EARLINGTON
EARLINGTON