FED. RD. DIST. NO.	STATE	F.A.P. NO.	FISCAL YEAR	SHEET NO.	TOTAL SHEETS
		N.R.S. 172(4)(5)	1935	6	24

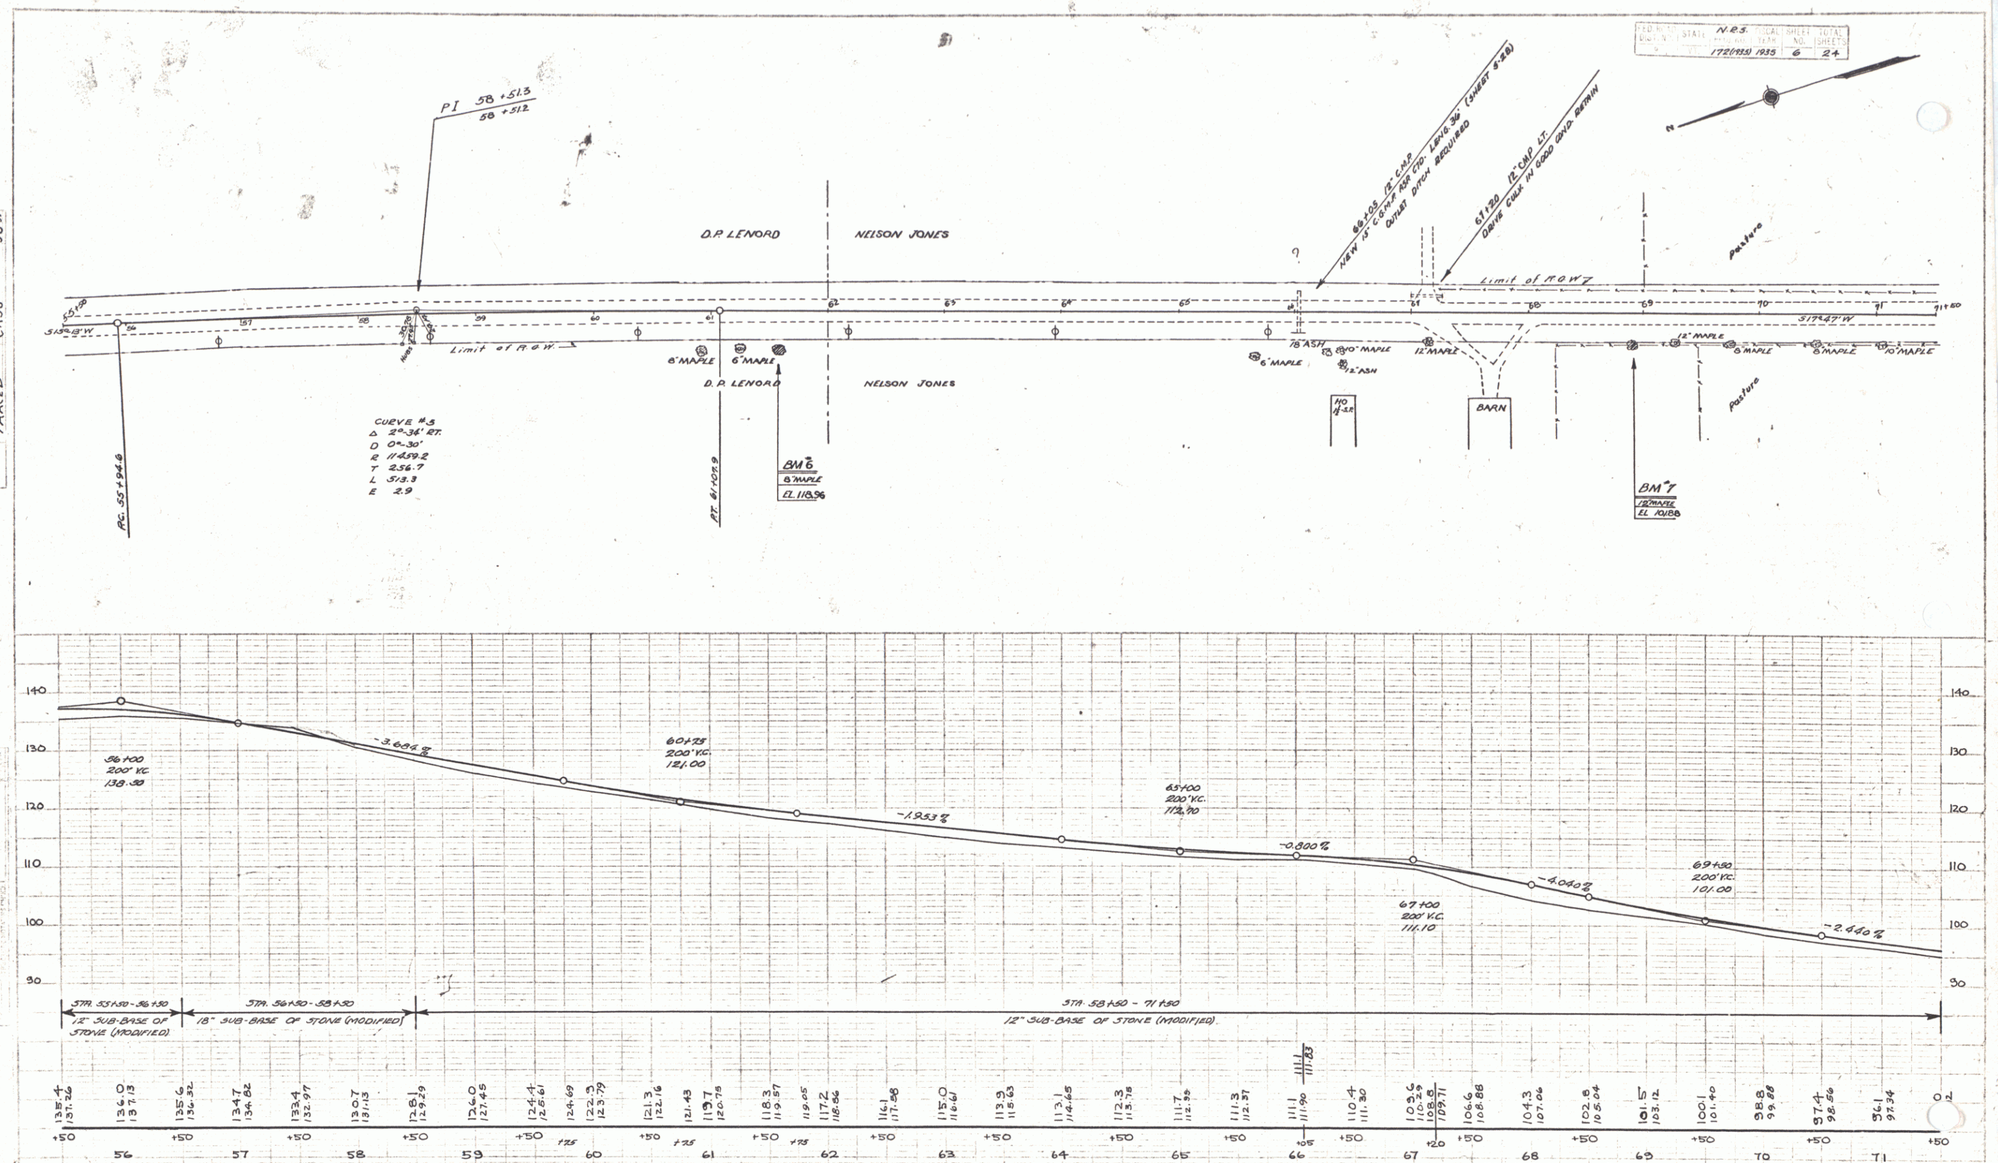

B.M. #6 SPIKE IN ROOT OF 8" MAPLE RT. 23' STA. 61+58 EL. 118.96
B.M. #7 " " " " " 12" " " RT. 24' STA. 68+51 EL. 101.88

SERIES N.R.S. NO. 172 (1934)
SHEET 6 OF 24

EARRINGTON 8/34
EMRICH 9/34

PLAN
PROFILE
CROSS SECTION
NOTE BOOK
NO.
EARRINGTON 8-8-34
EMRICH 9-8-34
CASS 9-6-34
TRACED

4