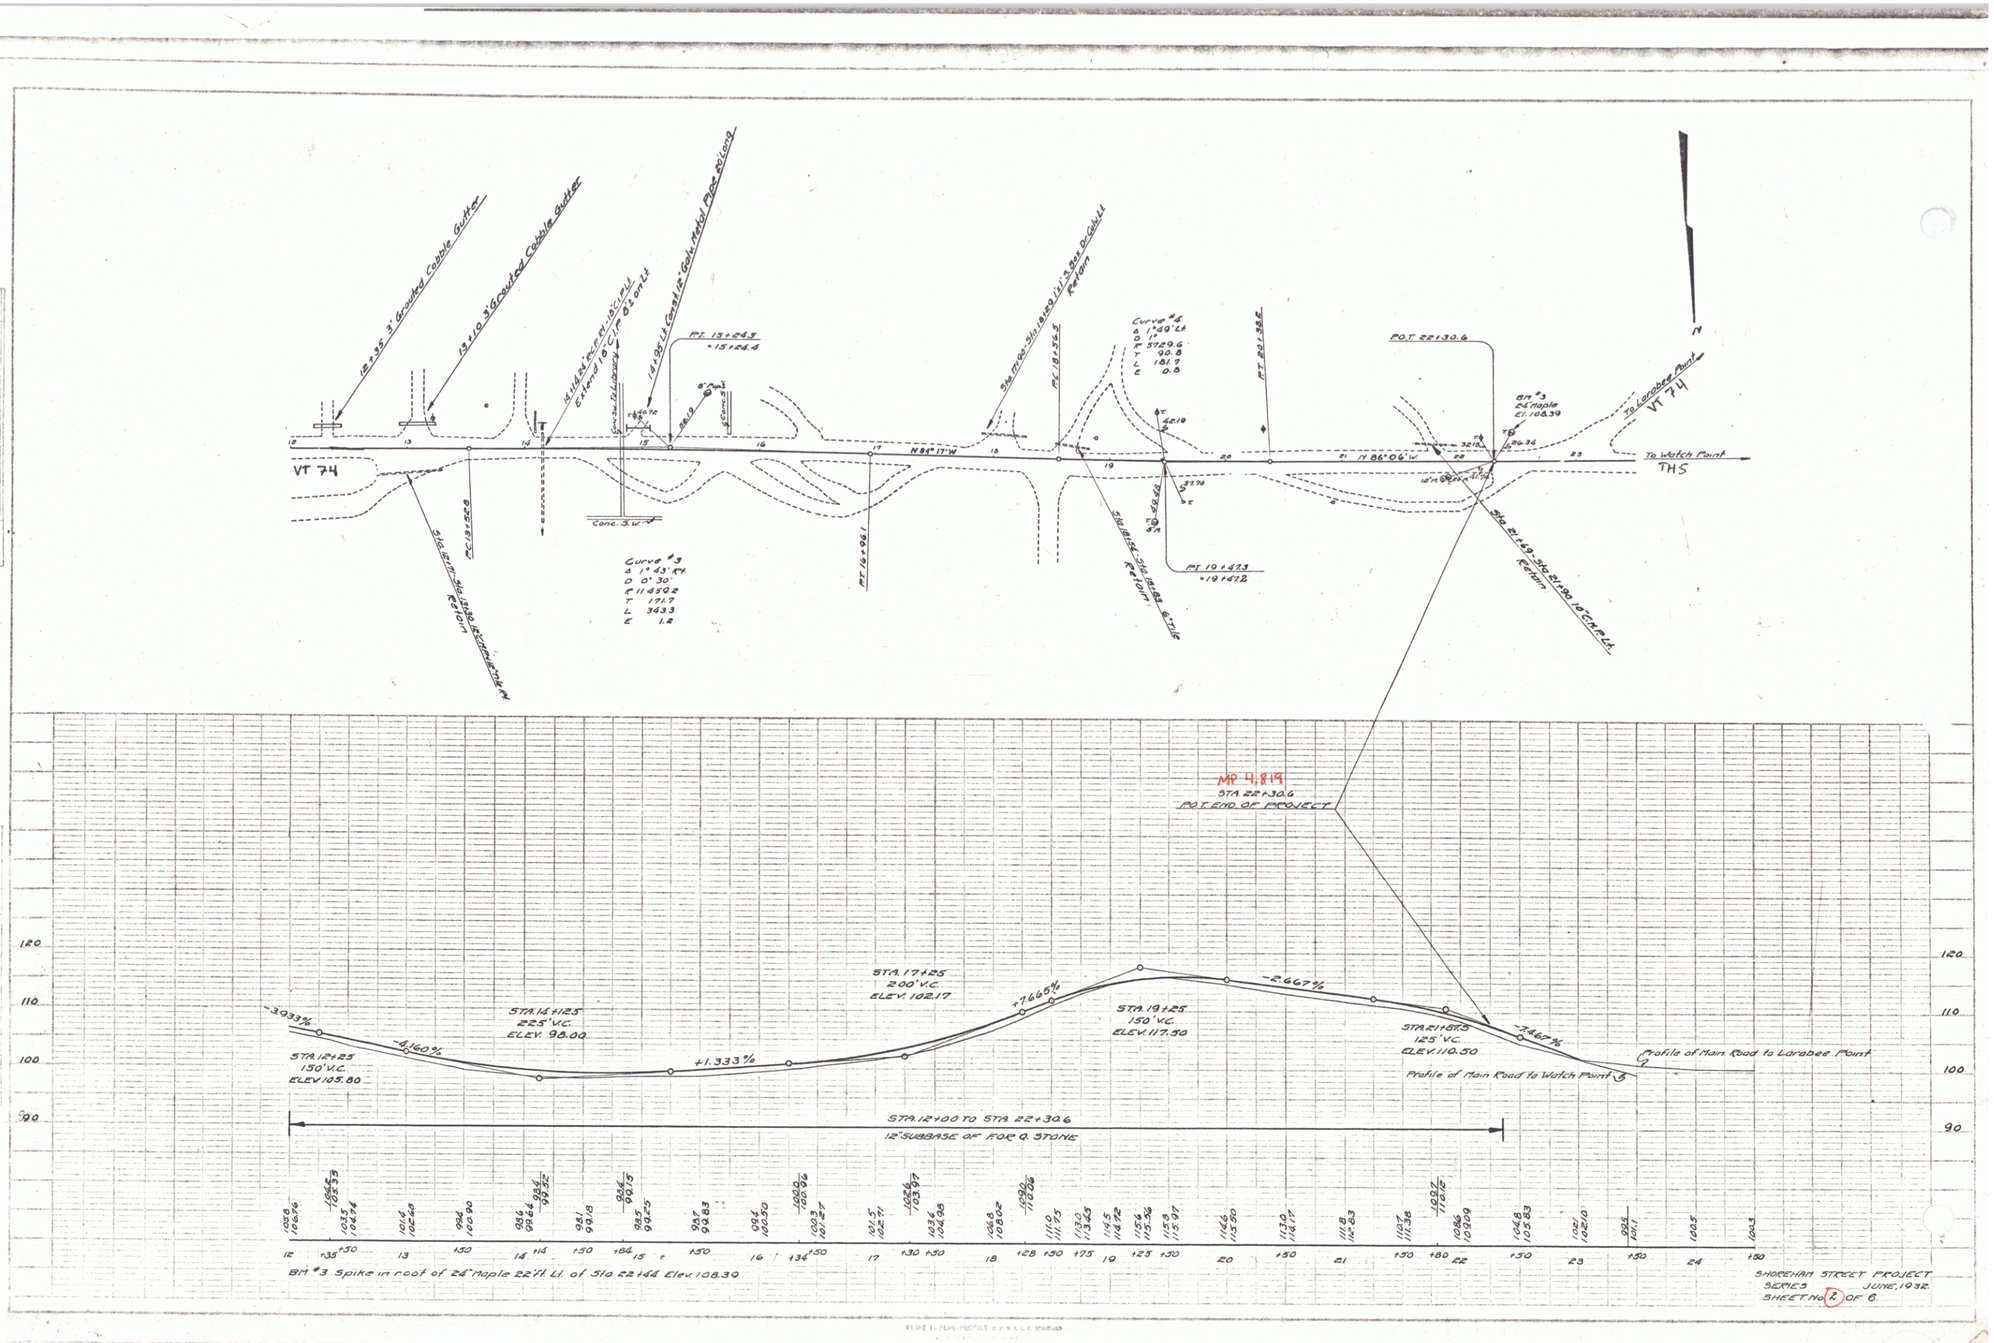
VT 74
To Watch Point
TH5
To Larabee Point
VT 74
N
N 86°0'6" W
N 86°17'W
Curve #3
Δ 1°43' Rt
D 10°30'
R 1145.92
T 17.7
L 34.33
E 1.2
Curve #4
Δ 1°40' Lt
D 1°
R 5729.6
T 90.8
L 181.7
E 0.8
P.O.T. 22+30.6
MP 4.819
STA 22+30.6
P.O.T. END OF PROJECT
STA. 17+25
200' V.C.
ELEV. 102.17
STA. 19+25
150' V.C.
ELEV. 117.50
STA. 14+125
225' V.C.
ELEV. 98.00
STA. 12+25
150' V.C.
ELEV. 105.80
STA. 21+85.5
125' V.C.
ELEV. 110.50
-3.933%
-4.160%
+1.333%
+7.667%
-2.667%
-7.467%
Profile of Main Road to Larabee Point
Profile of Main Road to Watch Point
STA. 12+00 TO STA. 22+30.6
12" SUBBASE OF FOR Q. STONE
BM #3 Spike in root of 26" Maple 22'11 Lt. of Sta 22+44 Elev. 108.30
SHOREHAM STREET PROJECT
SERIES JUNE, 1932
SHEET No 2 OF 8