FED. ROAD DIST. NO.	STATE	FAS PROJ. NO.	FISCAL YEAR	SHEET NO.	TOTAL SHEETS
1	VT.	18-A	1939	9	47

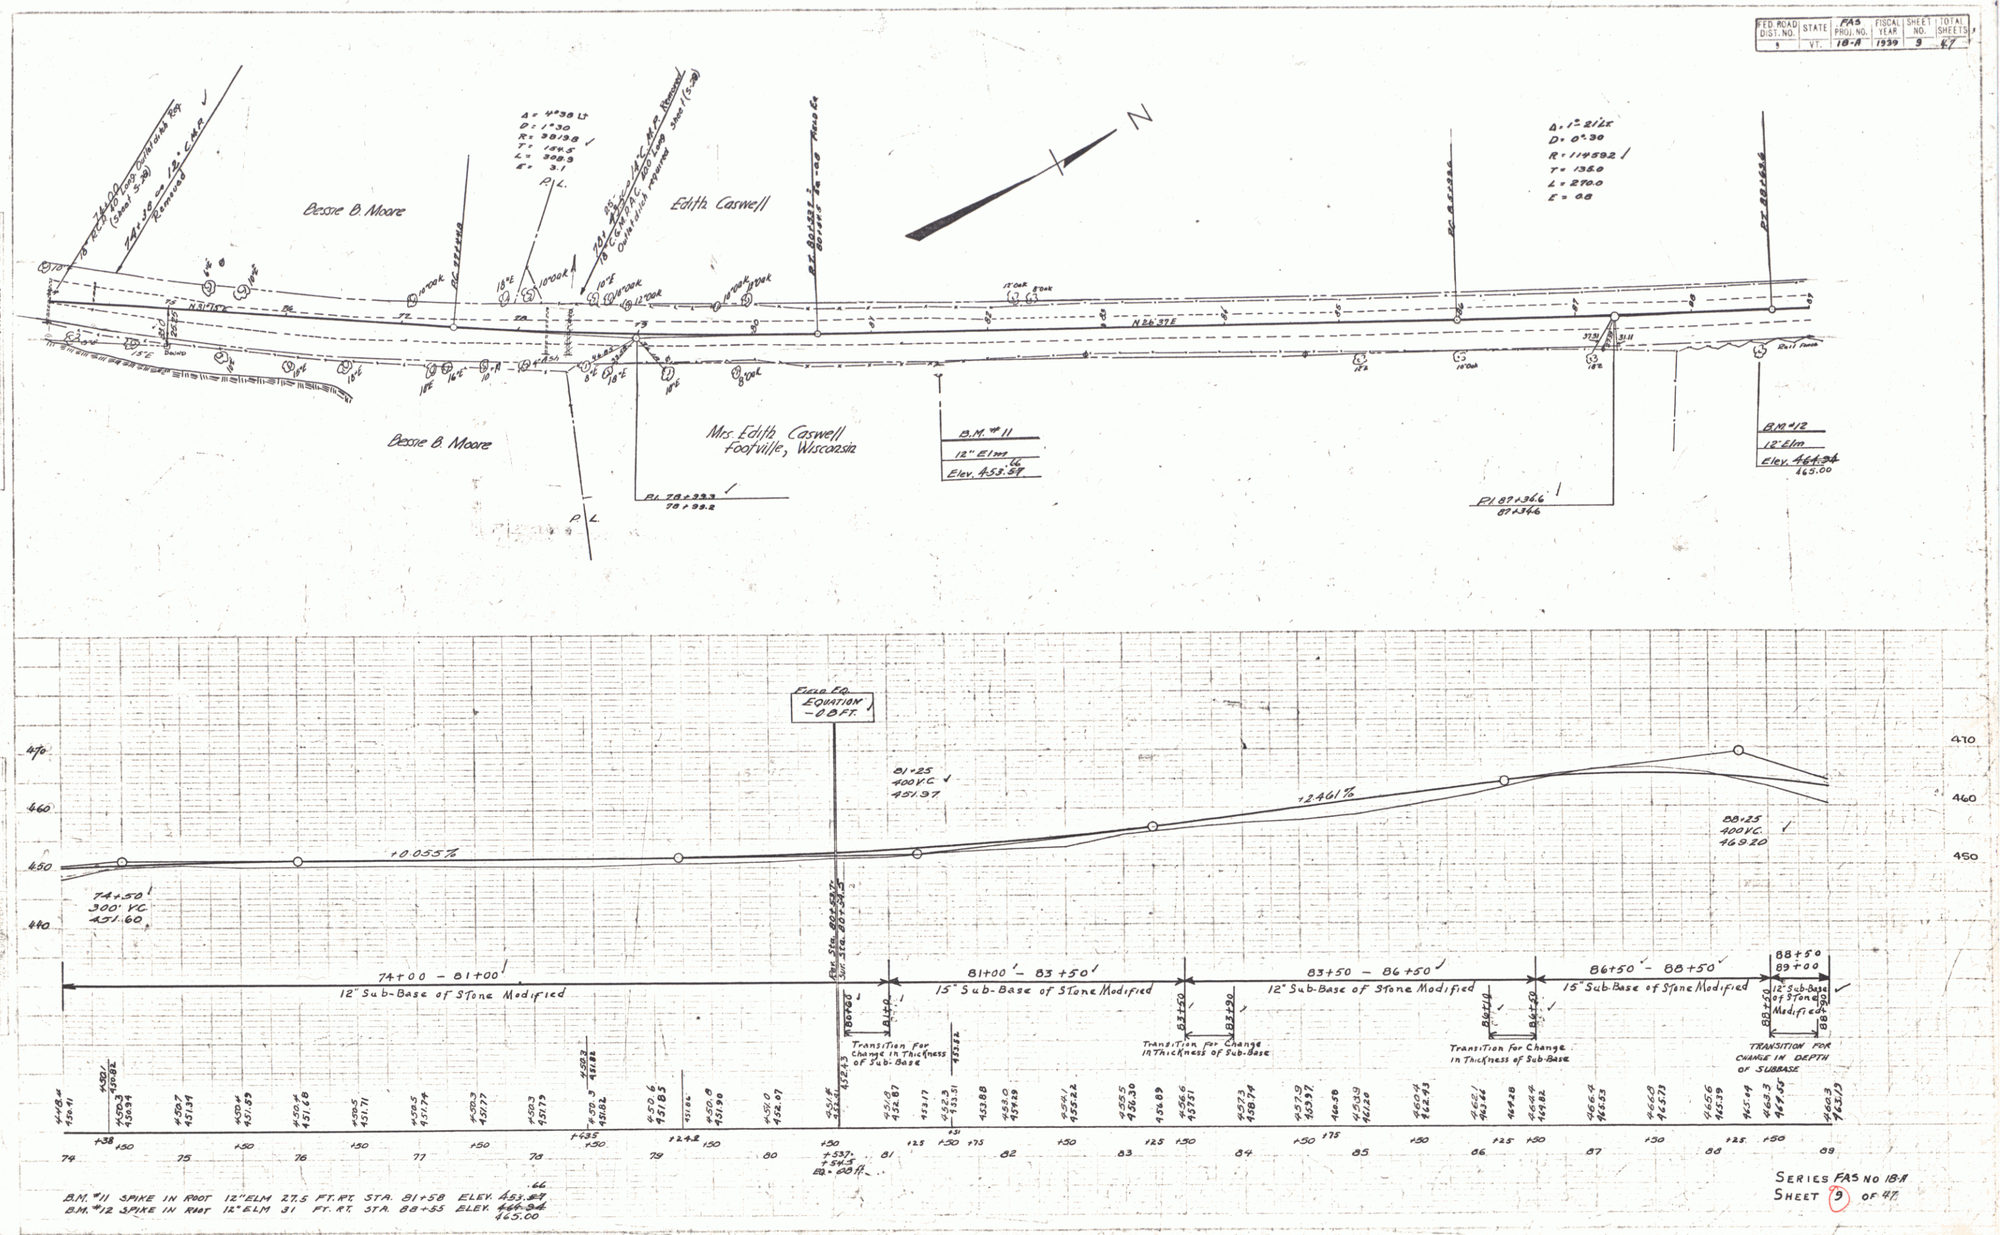

B.M. #11 SPIKE IN ROOT 12" ELM 27.5 FT. RT. STA. 81+58 ELEV. 453.64
B.M. #12 SPIKE IN ROOT 12" ELM 31 FT. RT. STA. 88+55 ELEV. 465.00

SERIES FAS NO 18-A
SHEET 9 OF 47

7