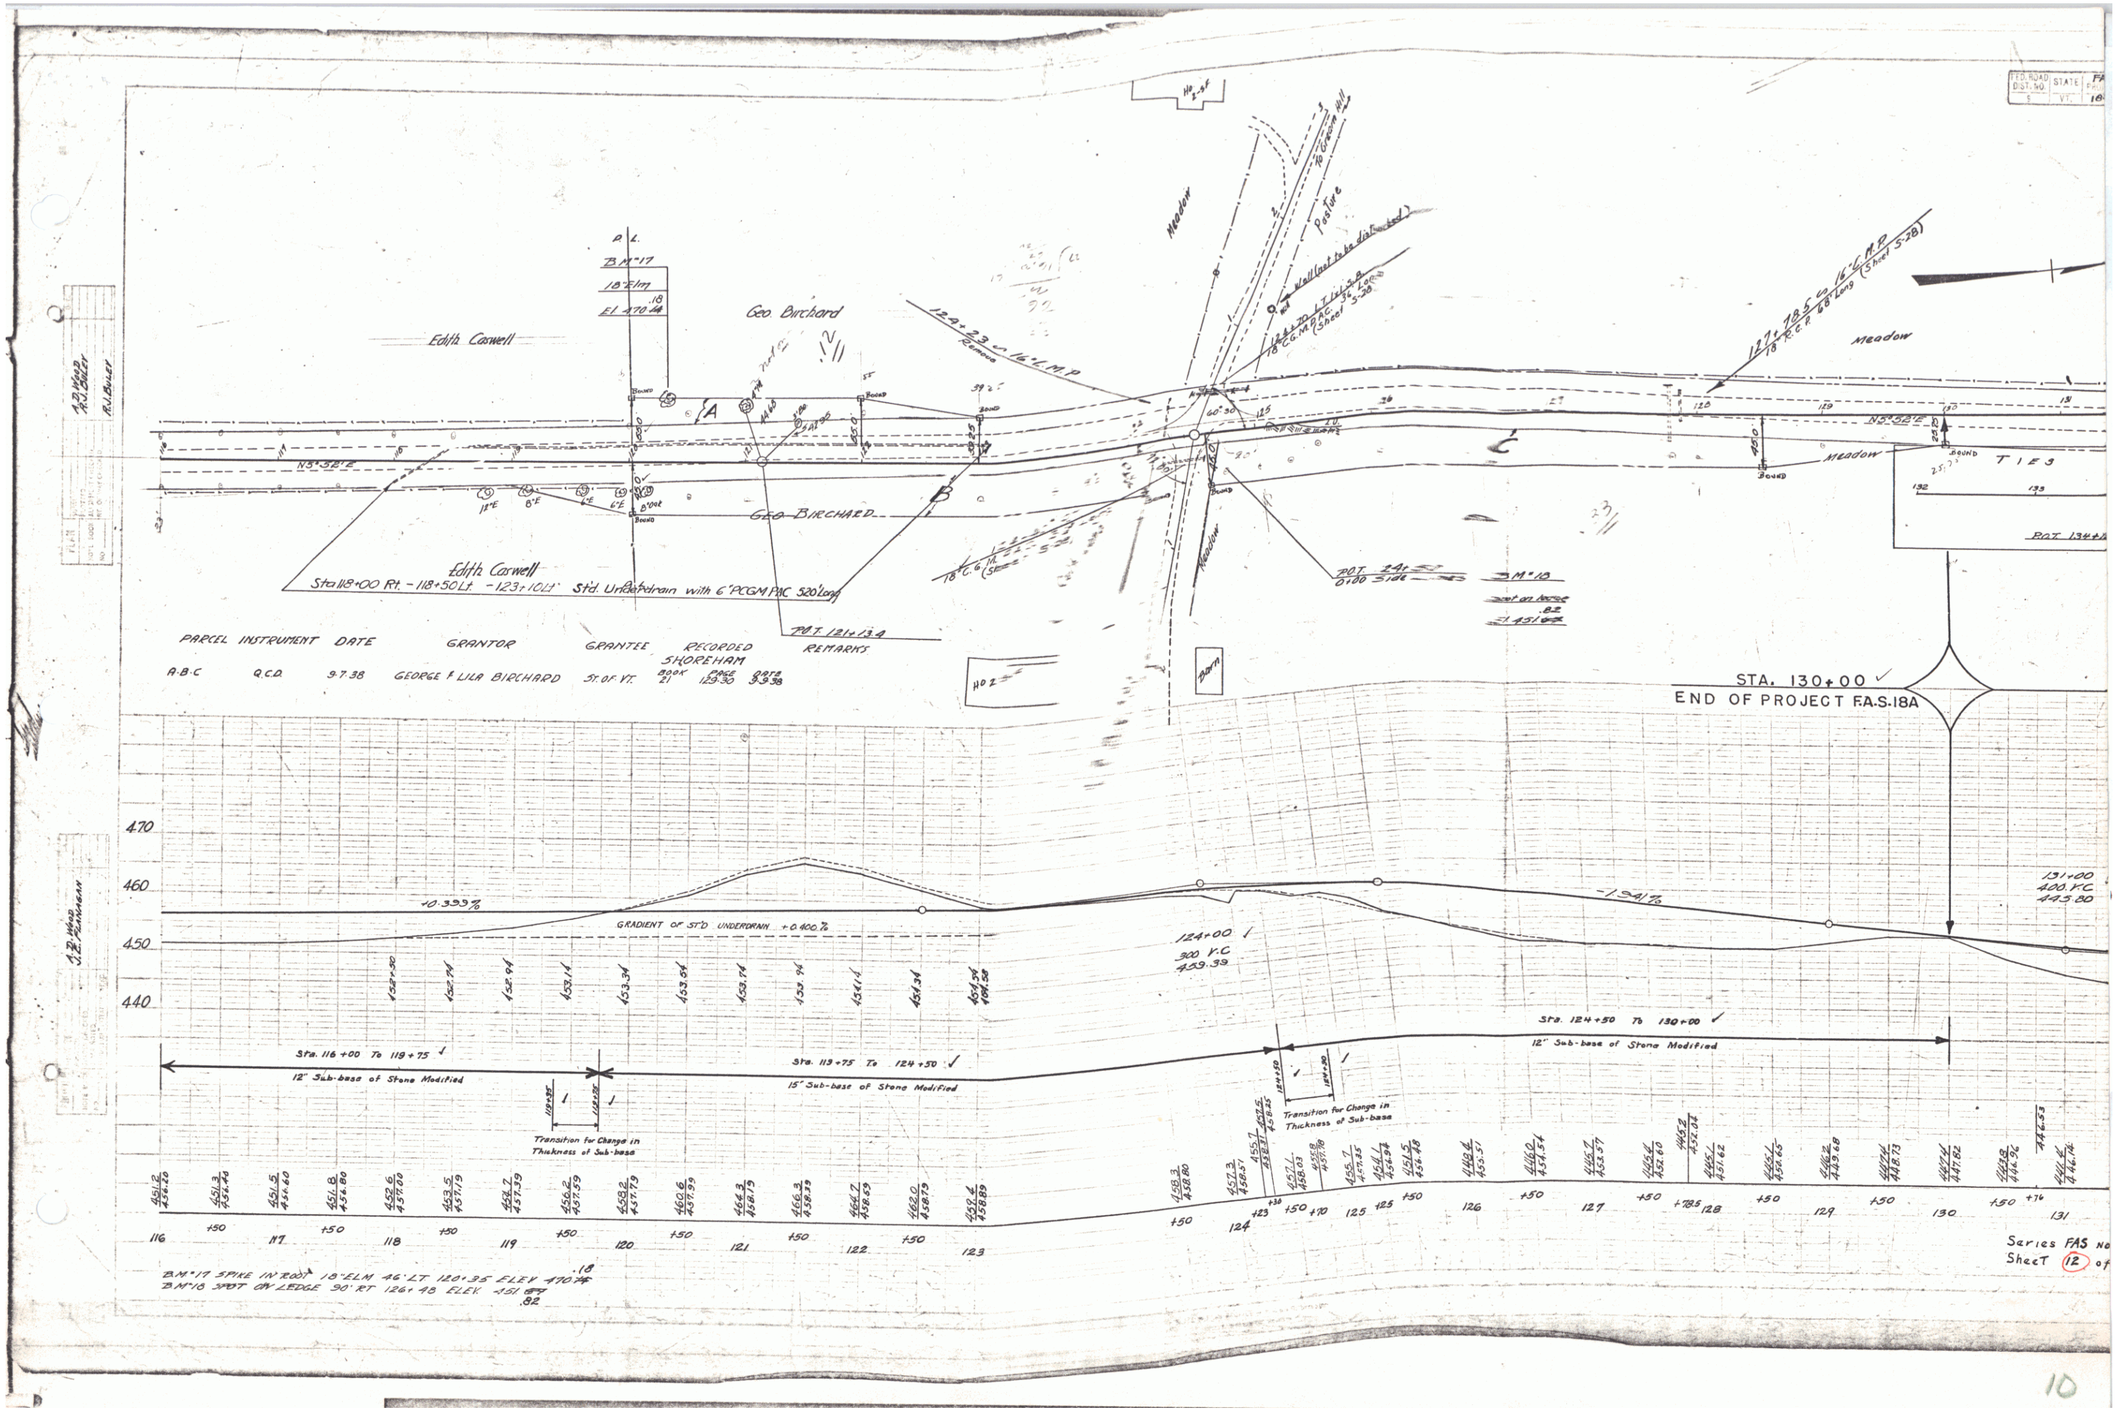
Edith Caswell
Geo. Birchard
Meadow
Pasture
N53°32'E
GEO. BIRCHARD
Edith Caswell
Sta 118+00 Rt. - 118+50 Lt - 123+10 Lt Std. Urbebdrain with 6" PCGM PAC 500' long
PARCEL INSTRUMENT DATE GRANTOR GRANTEE RECORDED SHOREHAM REMARKS
A-B-C Q.C.D. 9-7-38 GEORGE & LILA BIRCHARD ST. OF VT. BOOK 21 PAGE 129-30 DATE 9-9-38
STA. 130+00
END OF PROJECT F.A.S.-18A
TIE 3
GRADIENT OF ST'D UNDERDRAIN +0.400%
+0.333%
-1.94%
124+00
900 V.C.
439.39
131+00
400 V.C.
449.80
Sta. 116+00 To 119+75
12" Sub-base of Stone Modified
Sta. 119+75 To 124+50
15" Sub-base of Stone Modified
Sta. 124+50 To 130+00
12" Sub-base of Stone Modified
Transition for Change in Thickness of Sub-base
BM#17 SPIKE IN ROOT 18" ELM 46' LT 120+25 ELEV 470.18
BM#18 SPOT ON LEDGE 30' RT 126+48 ELEV. 451.82
Series FAS No
Sheet 12 of

10