FED. ROAD DIST. NO.	STATE	F.A.S. PROJ. NO.	FISCAL YEAR	SHEET NO.	TOTAL SHEETS
9	VT.	18-B(1)1240		4	67

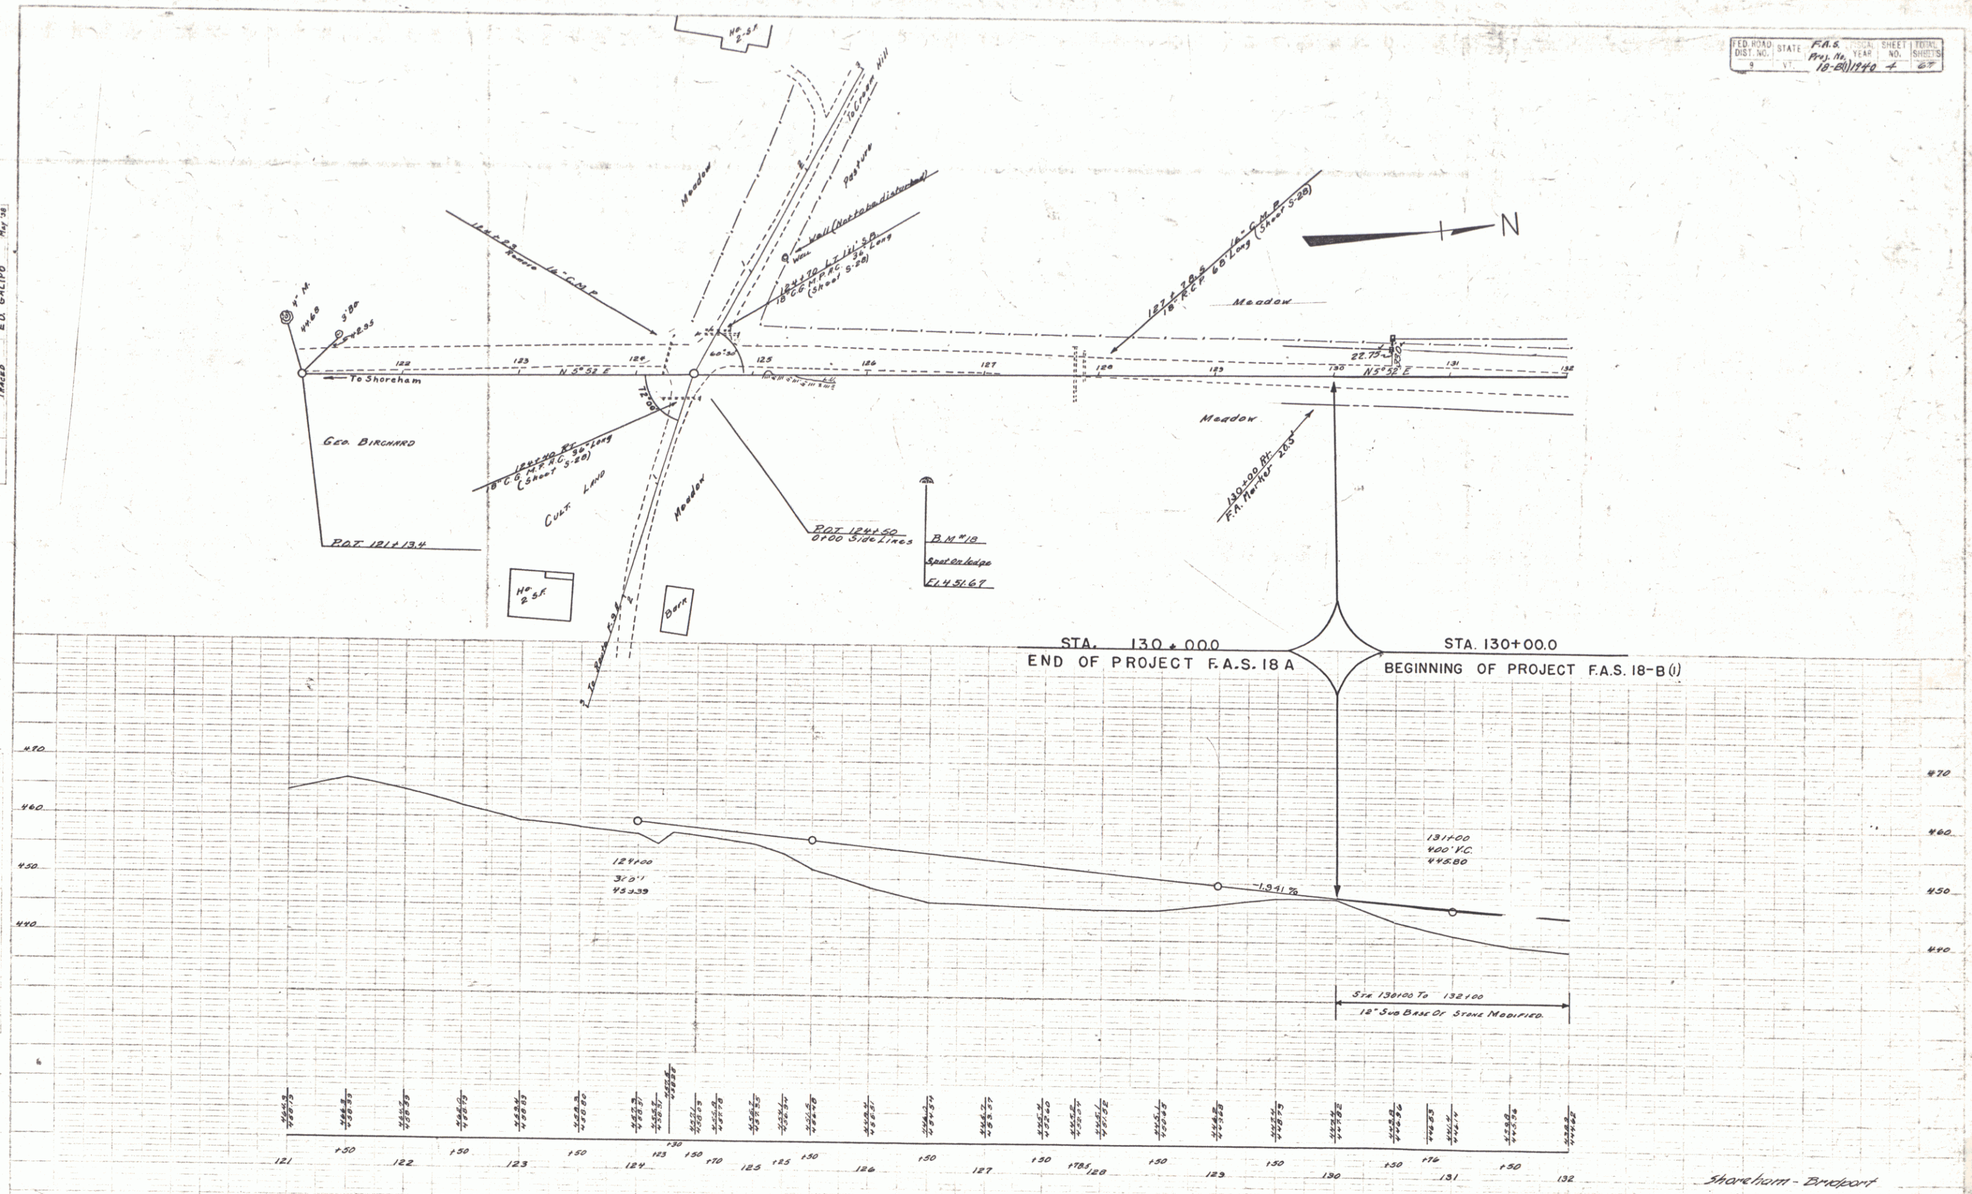

BM #18 SPOT ON LEDGE 99' RT. STA. 126+51 ELEV. 451.67

SERIES F.A.S. NO. 18-B(1)
SHEET 4 OF 67