FED. ROAD DIST. NO.	STATE	F.A.S. PROJ. NO.	FISCAL YEAR	SHEET NO.	TOTAL SHEETS
5	VT.	18 B(1)	1940	5	67

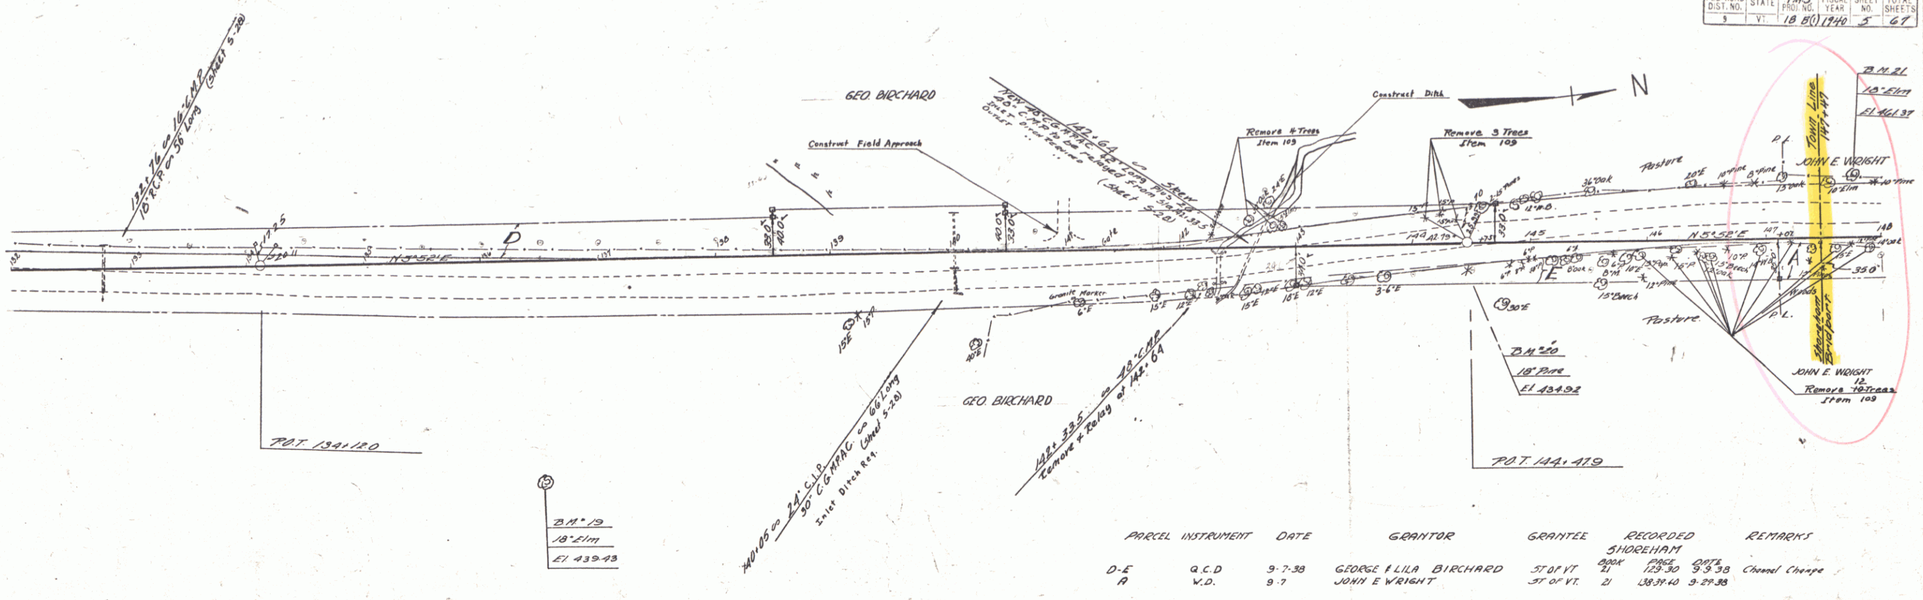

PARCEL	INSTRUMENT	DATE	GRANTOR	GRANTEE	RECORDED SHOREHAM BOOK	PAGE	DATE	REMARKS
D-E	Q.C.D	9-7-38	GEORGE & LILA BIRCHARD	ST OF VT.	21	129-30	9-9-38	Channel Change
A	W.D.	9-7	JOHN E WRIGHT	ST OF VT.	21	138-39-40	9-29-38	

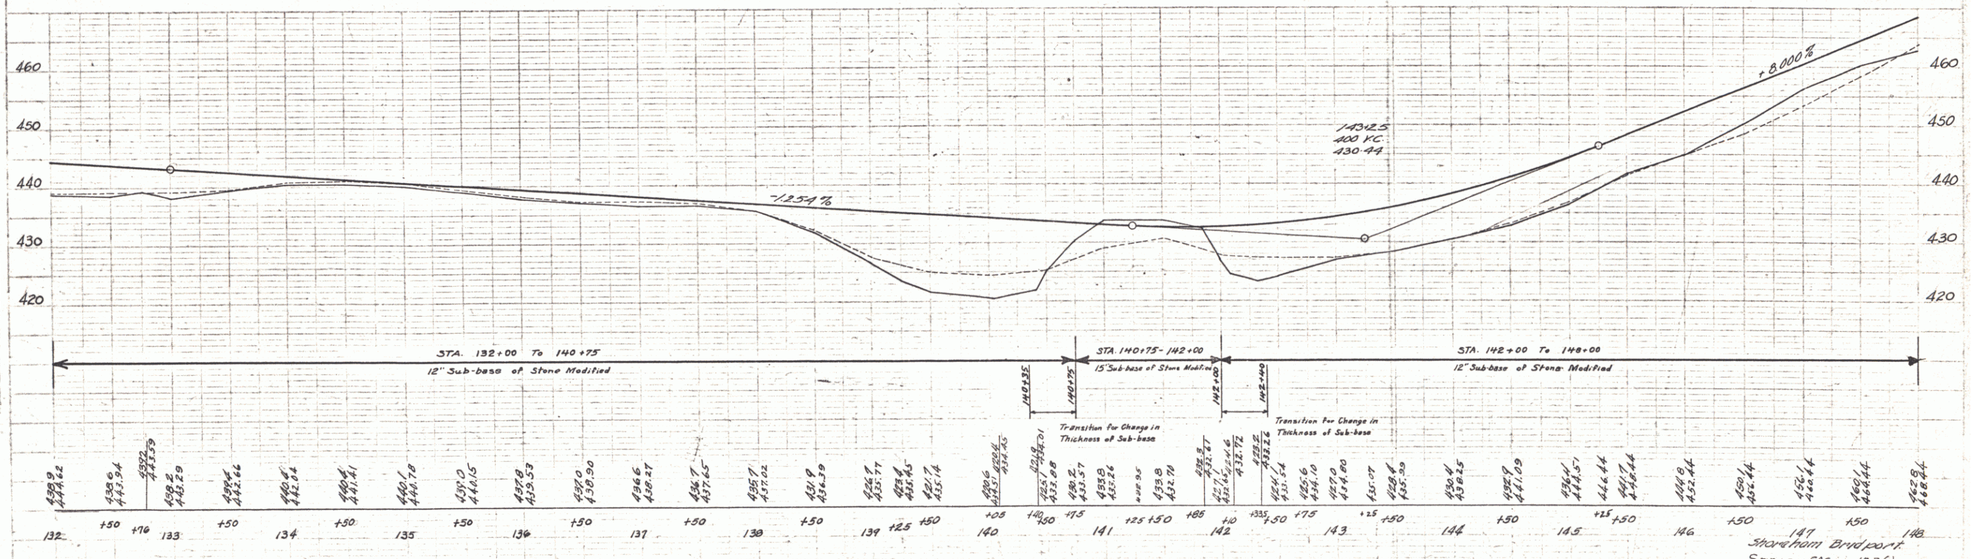

BM #19 SPIKE IN ROOT 18" ELM 106' RT. 136+50 ELEV 439.43
BM #20 " " " 18" PINE 23.5' RT. 144+47 " 434.92
BM #21 " " " 18" ELM 46.5 LT. 147+74 " 461.37

Shoreham Bridport
SERIES FAS NO 18-B(1)
SHEET 5 OF 67

3