FED. ROAD DIST. NO.	STATE	FAS PROJ. NO.	FISCAL YEAR	SHEET NO.	TOTAL SHEETS
9	VT	18-B(1)	1940	7	67

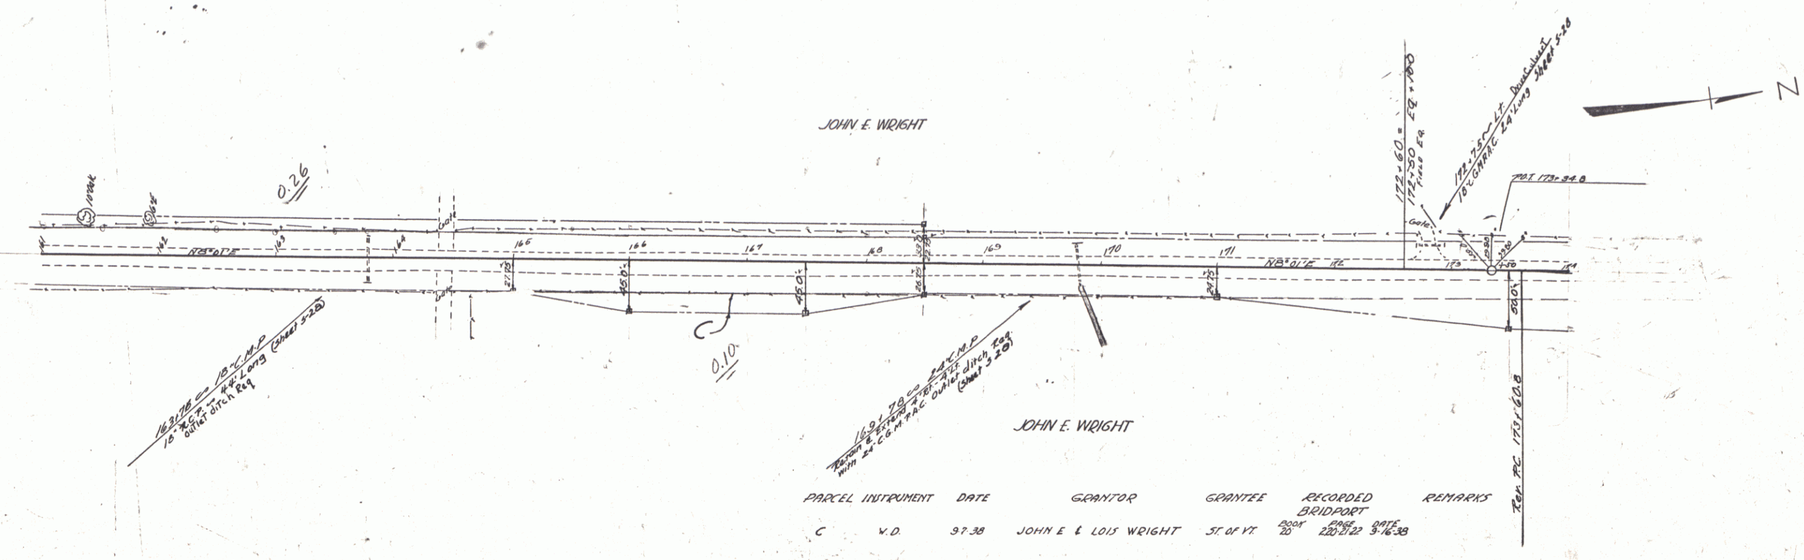

PARCEL	INSTRUMENT	DATE	GRANTOR	GRANTEE	RECORDED BRIDPORT BOOK	PAGE	DATE	REMARKS
C	W.D.	9-7-38	JOHN E & LOIS WRIGHT	ST. OF VT.	20	220-222	9-16-38	

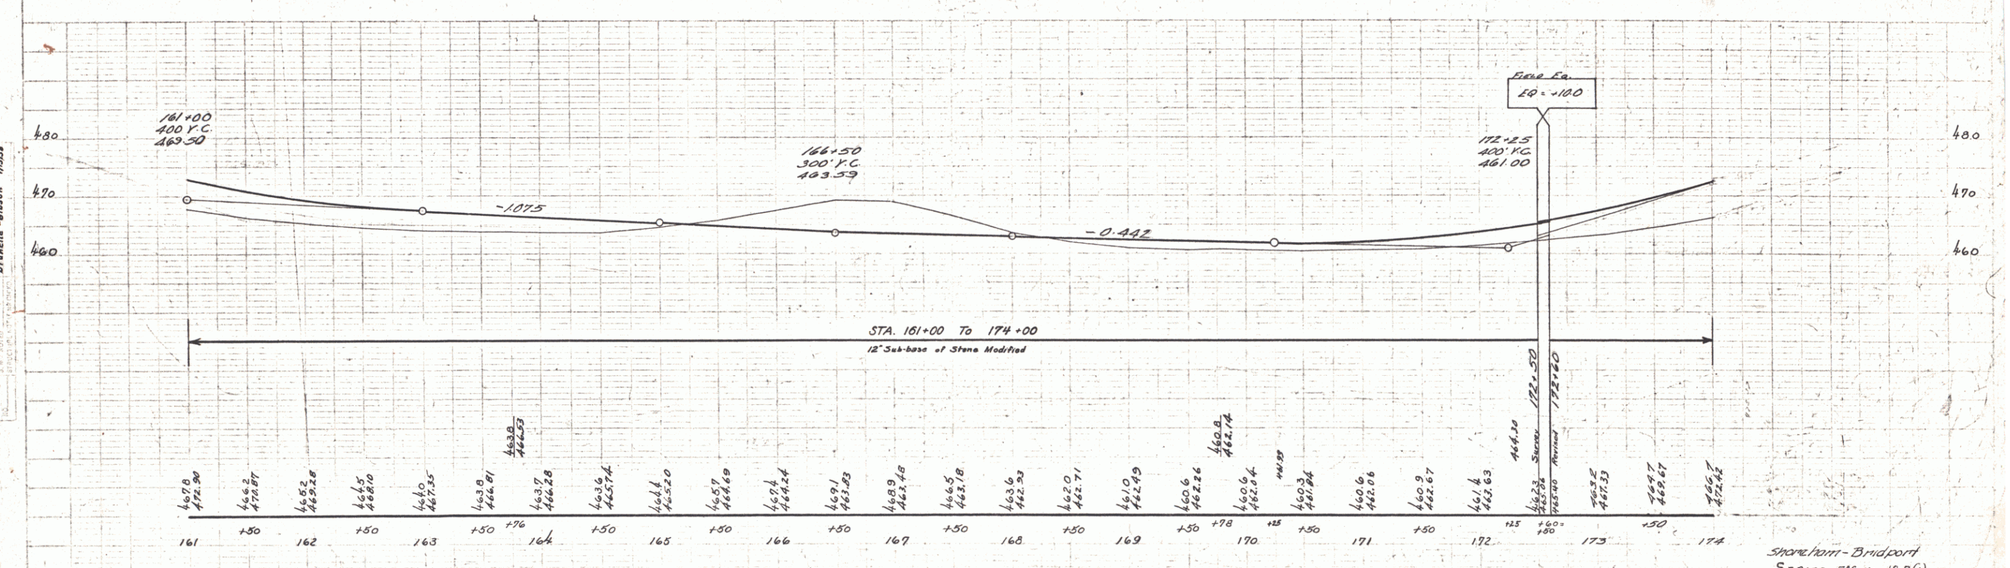

Shoreham - Bridport
SERIES FAS No 18-B(1)
SHEET 7 OF 67

5