FED. ROAD DIST. NO.	STATE	FAS PROJ. NO.	FISCAL YEAR	SHEET NO.	TOTAL SHEETS
1	VT	18-B(1)	1940	9	67

PARCEL	INSTRUMENT	DATE	GRANTOR	GRANTEE	RECORDED BRIDPORT BOOK	PAGE	DATE	REMARKS
A	QCD	9-7-38	T.D. & P. & MARY SUNDERLAND	ST OF VT.	20	218-19	9-10-38	Cal. Sta 296+00

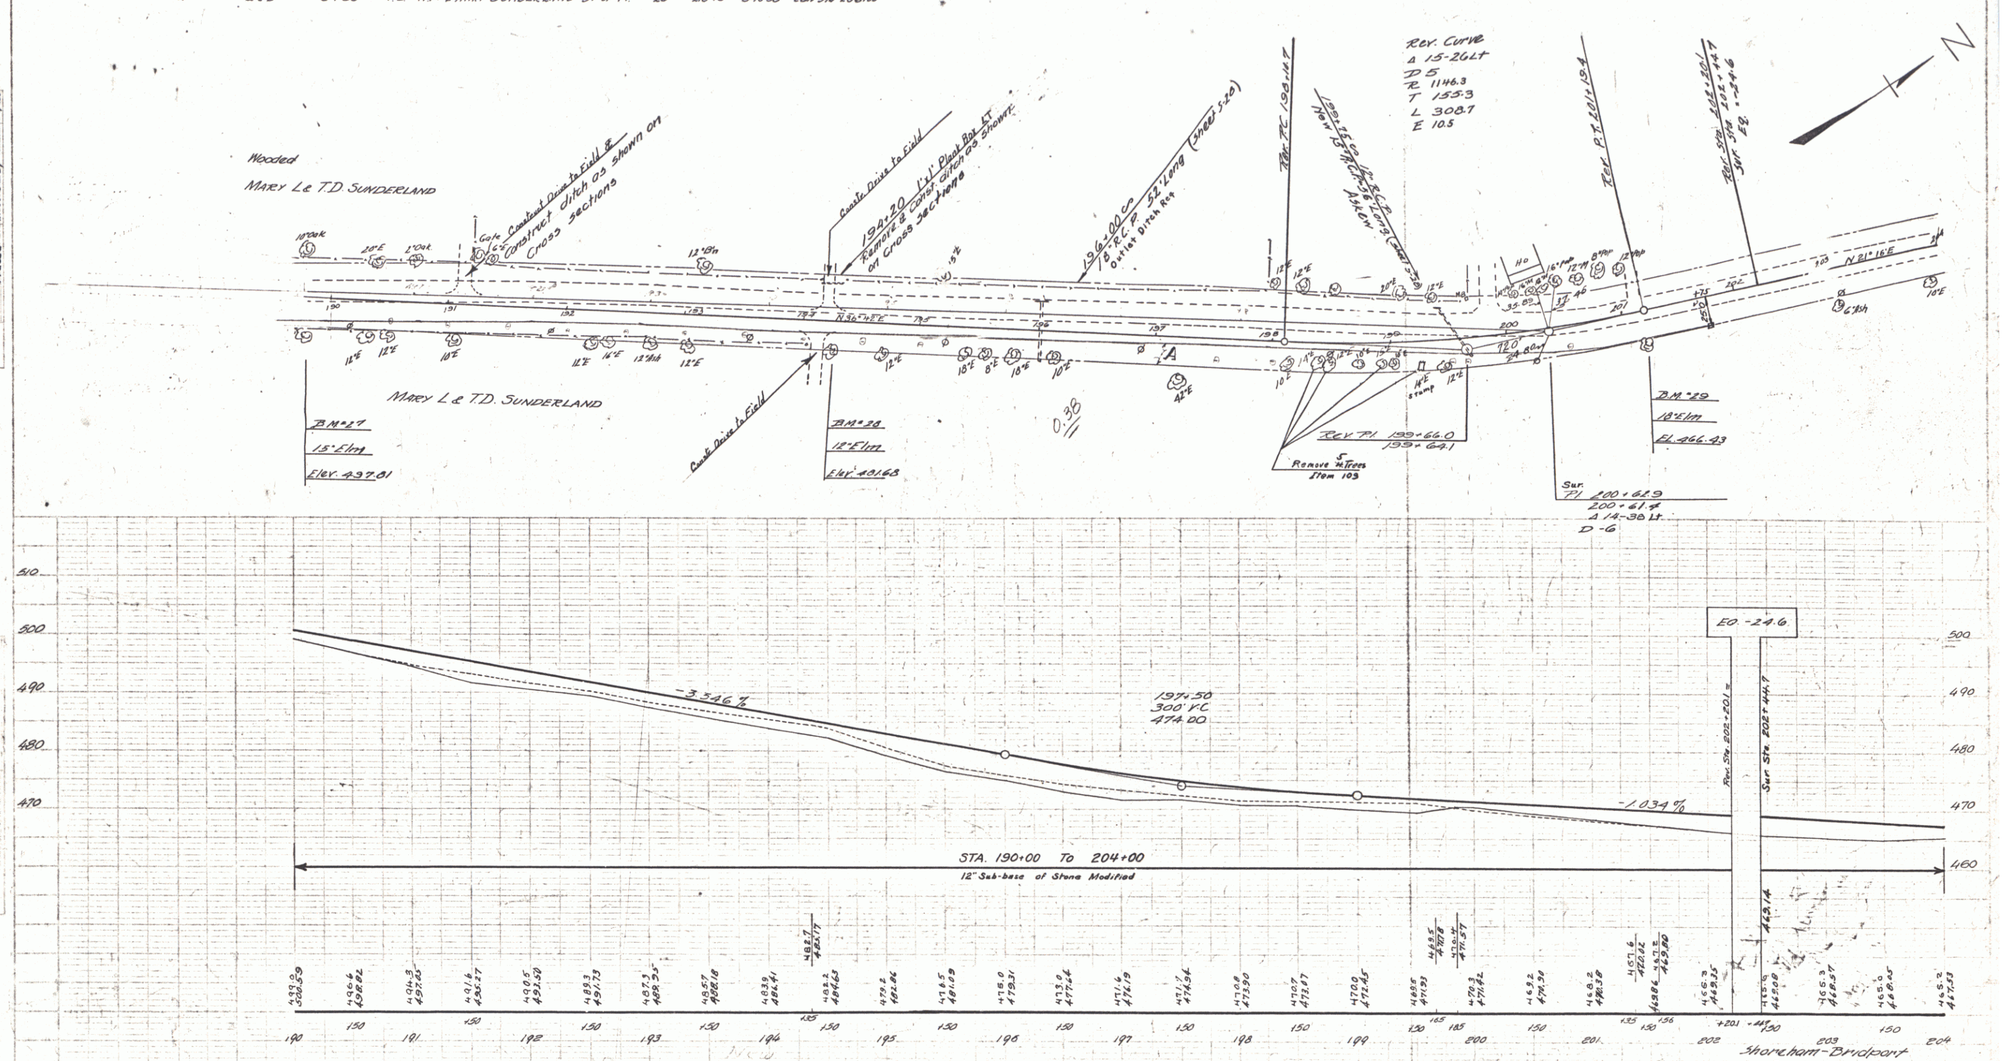

BM #27 SPIKE IN ROOT 15" ELM 31.5' RT. STA 190+03 ELEV 497.81
BM #28 " " " 12" ELM 31.5' RT. STA 194+32 ELEV 481.68
BM #29 " " " 18" ELM 26.5' RT. STA 201+41 ELEV 466.43

Shoreham-Bridport
SERIES FAS NO 18-B(1)
SHEET 9 OF 67

7