FED. RD. DIST. NO.	STATE	PROJ. NO.	FISCAL YEAR	SHEET NO.	TOTAL SHEETS
9	VT.	S 18(3)	1946	8	117

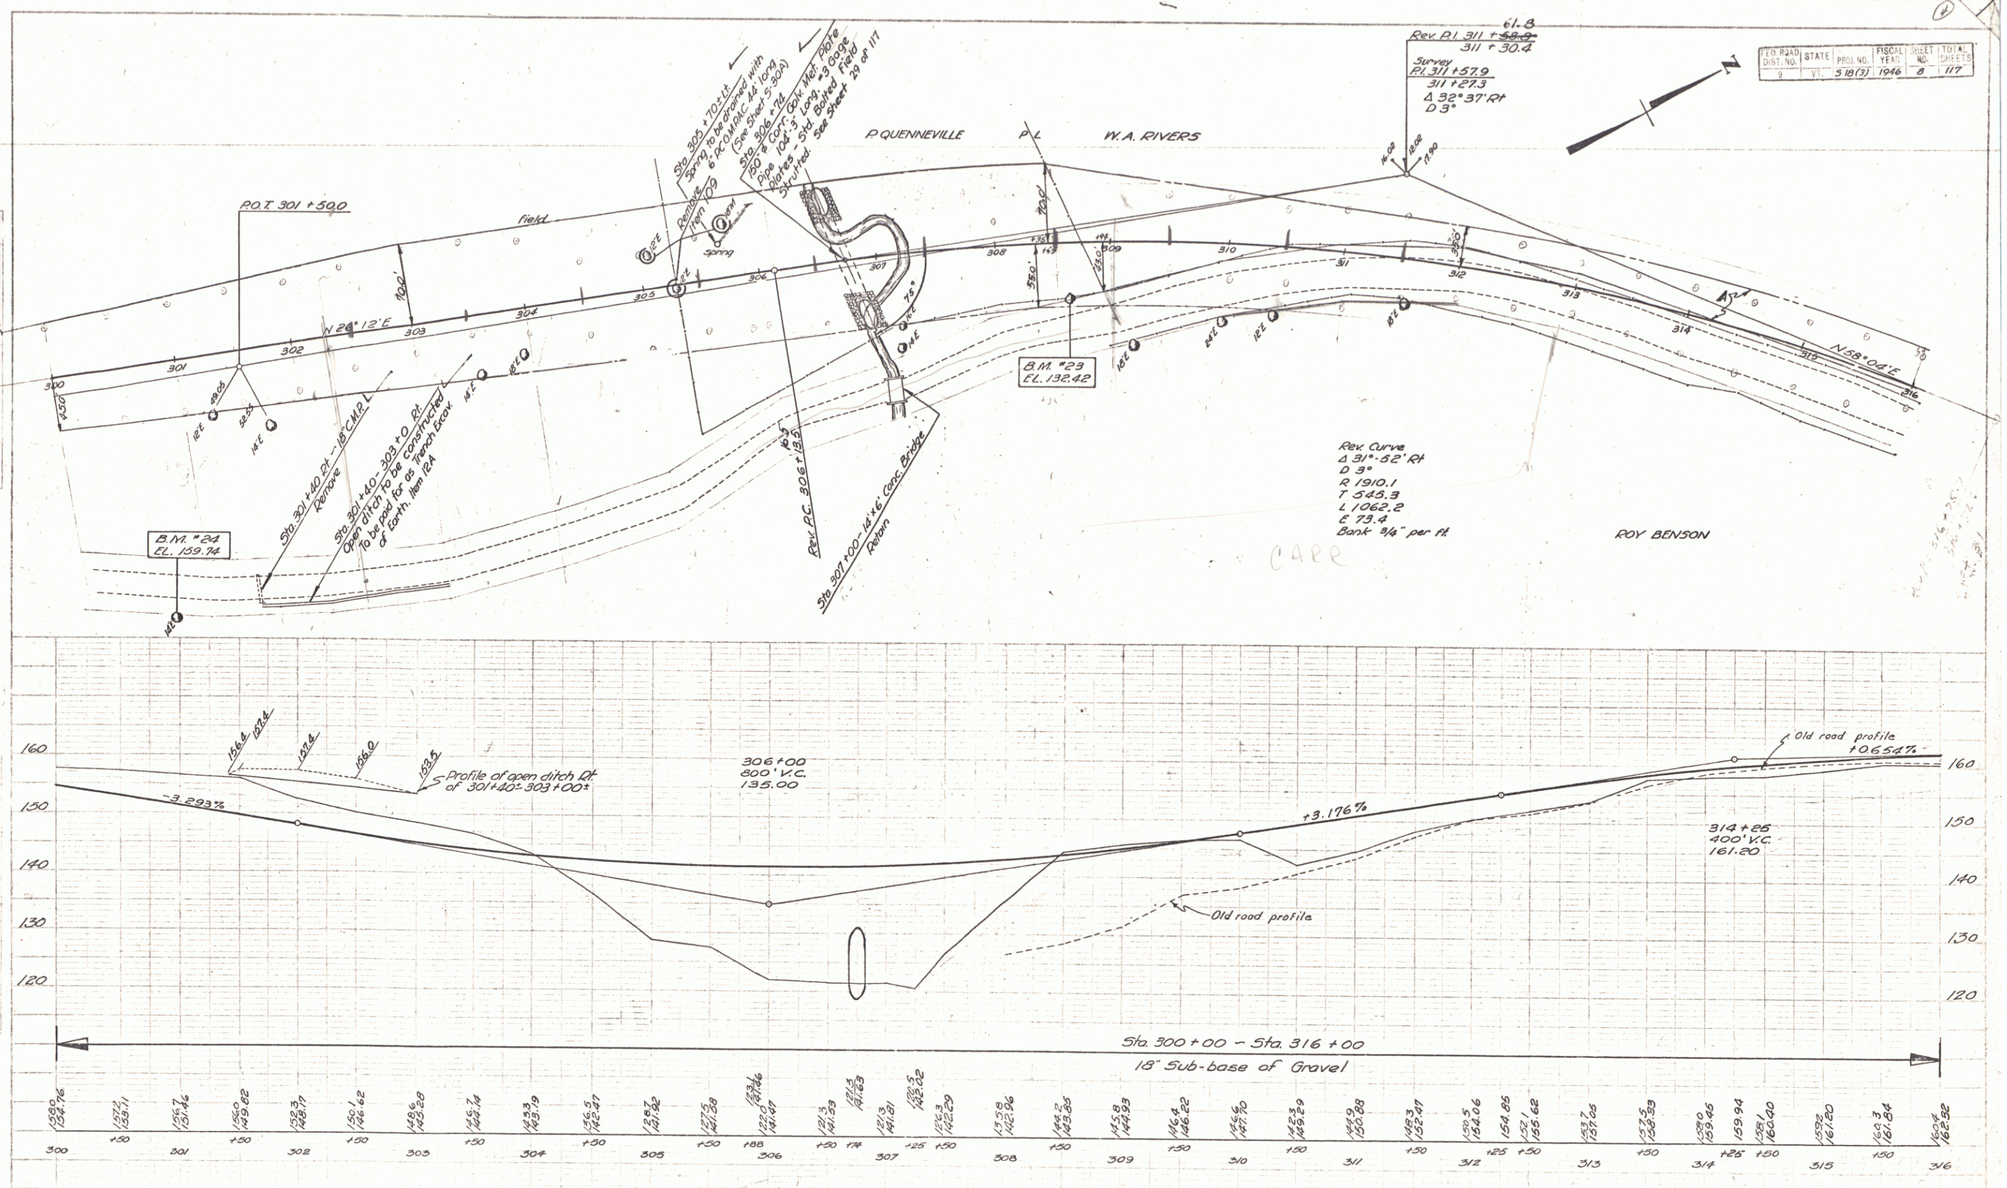

B.M. #23 El. 132.42 S.I.R. 12" Elm 40 ft Rt Sta 308 + 59
B.M. #24 El. 159.74 S.I.R. 14" Elm 200 ft Rt Sta 300 + 62

Bridport - Addison
series 5 no. 18 (3)
sheet 8 of 117 sheets