PARCEL	INSTRUMENT	DATE	GRANTOR	GRANTEE	RECORDED ADDISON BOOK	PAGE	DATE	REMARKS
A	W.D.Q.E.	10-1-46	EDWARD C. & ALTA A. BRILEYA	ST. OF VT.	29	246-247	10-19-46	

FED. ROAD DIST. NO.	STATE	PROJ. NO.	FISCAL YEAR	SHEET NO.	TOTAL SHEETS
4		S 18(3)	1946	12	117

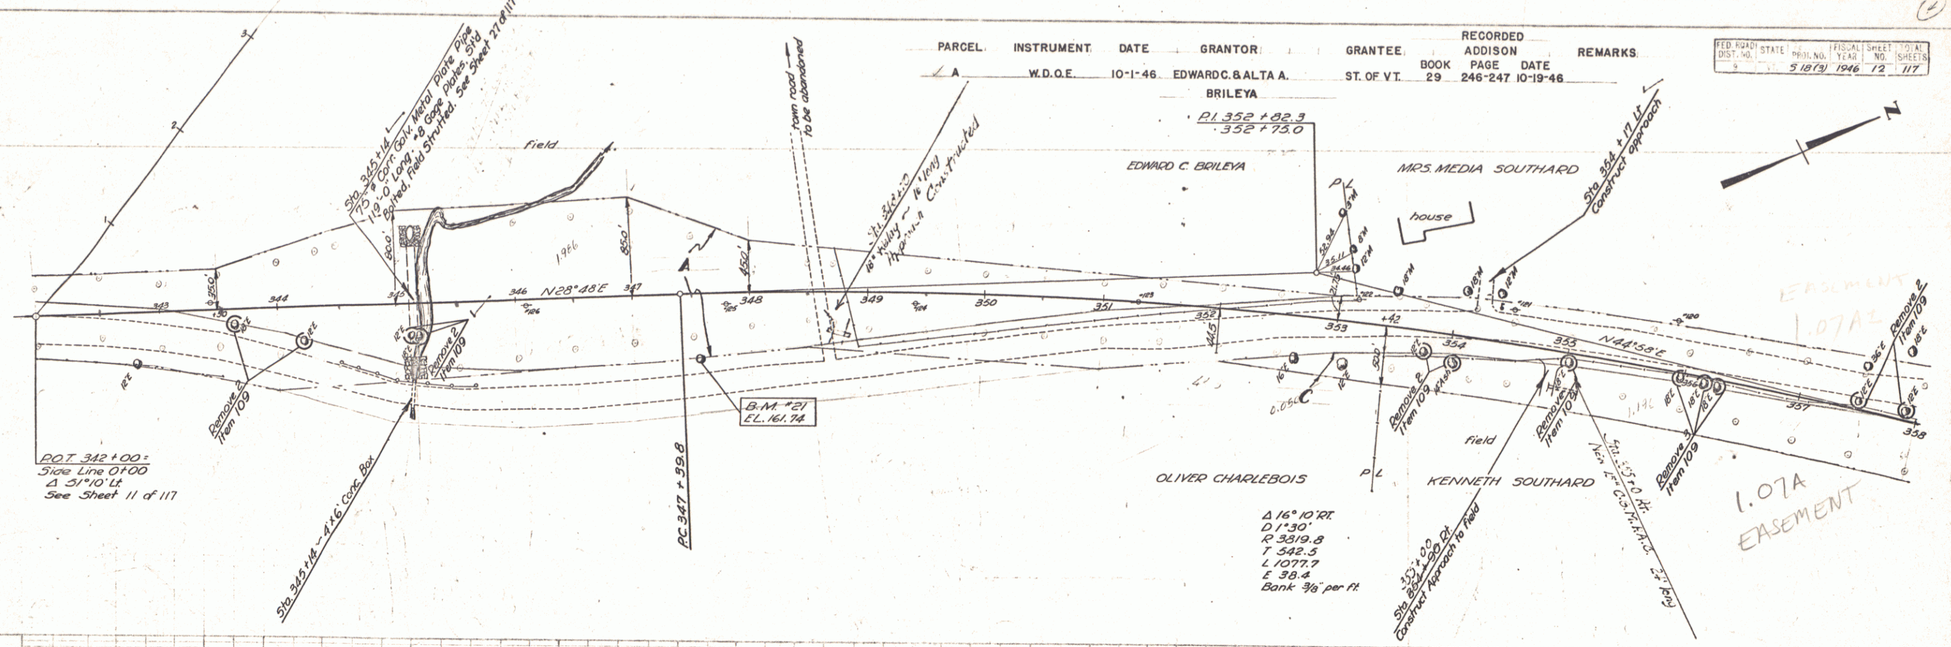

10