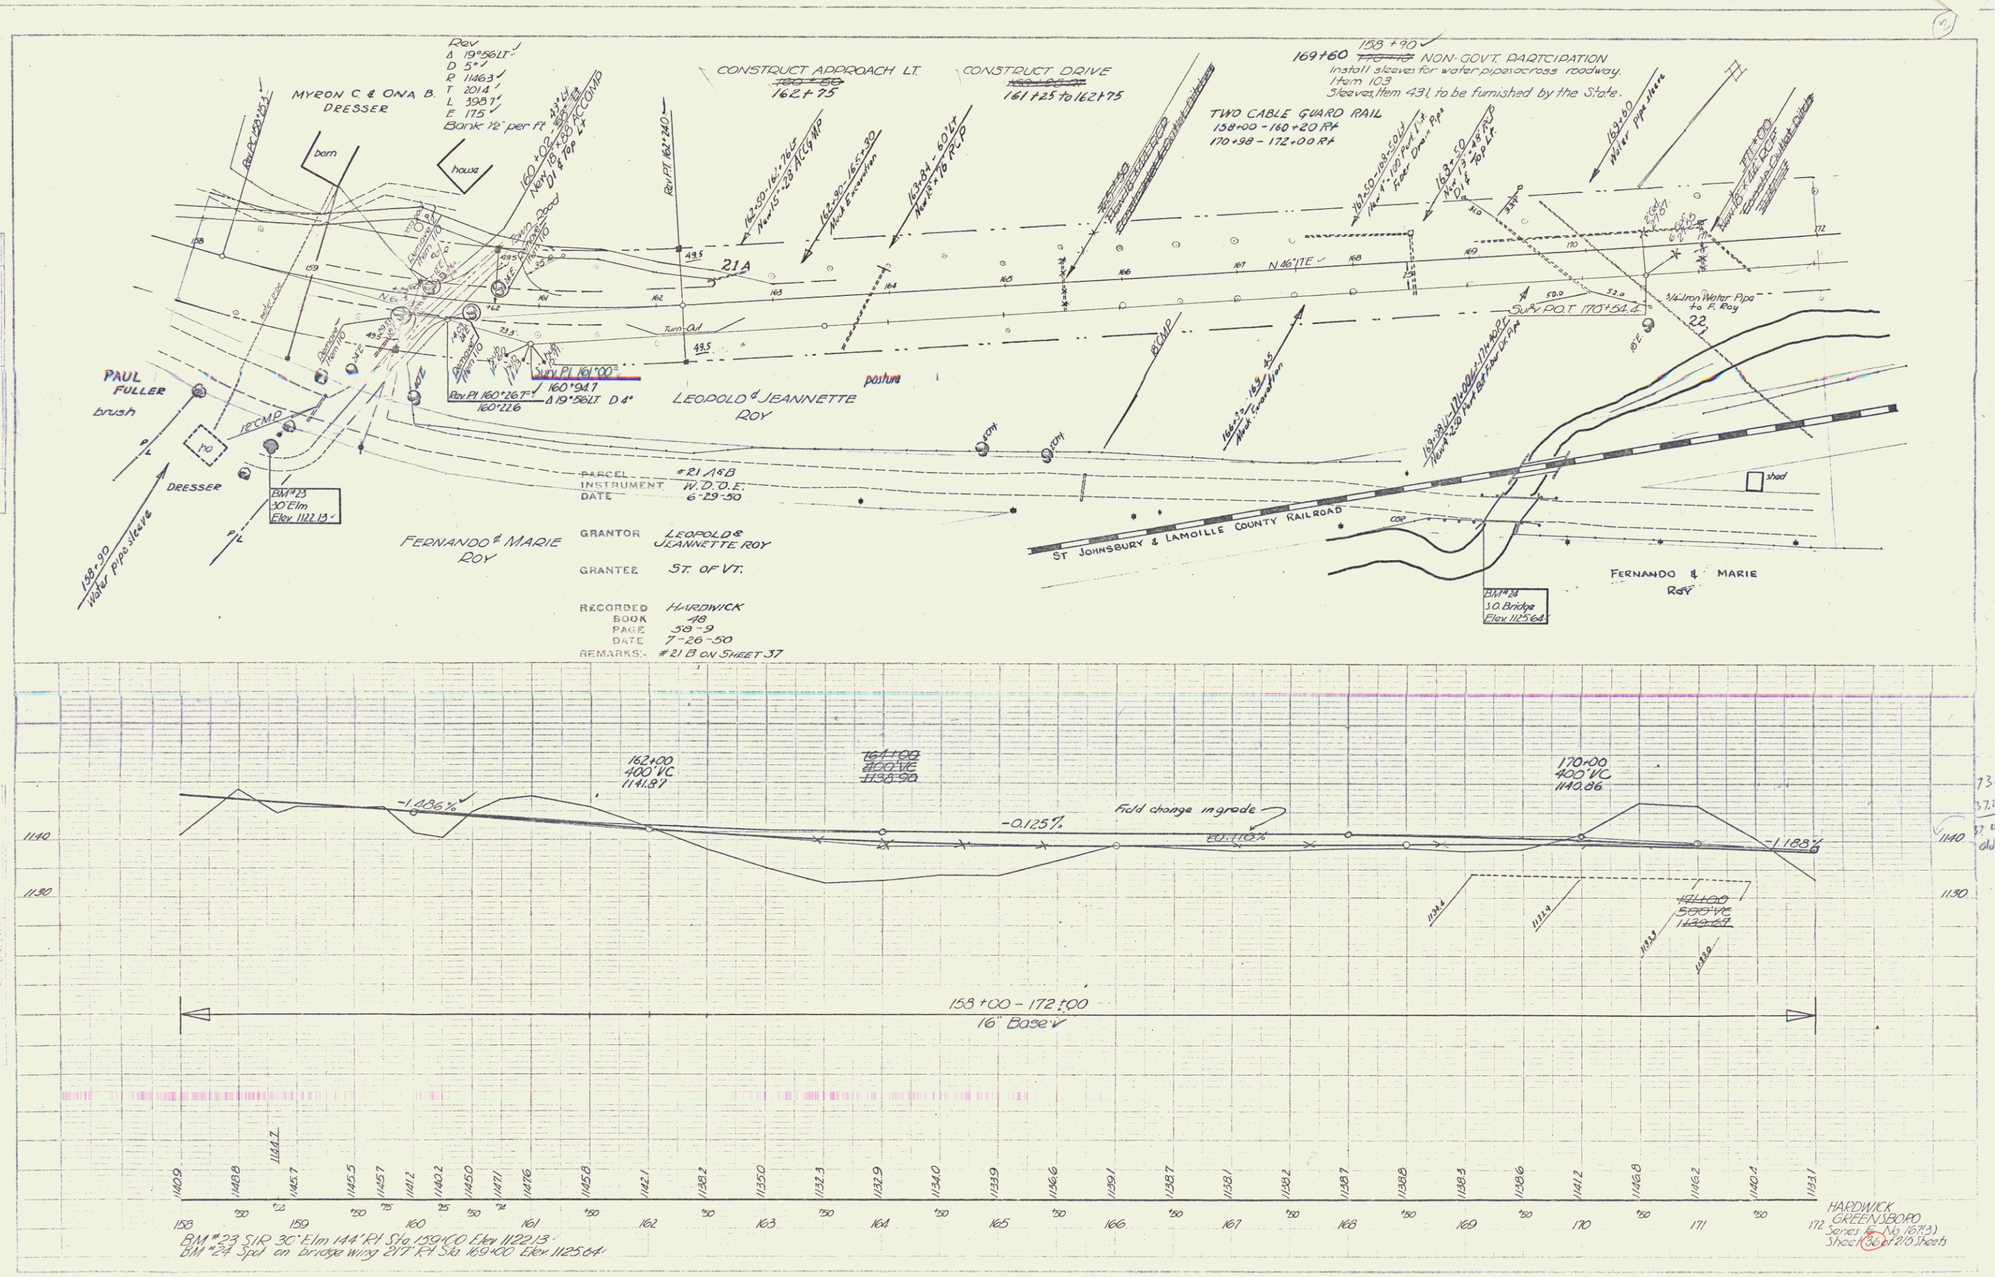
MYRON C. & ONA B. DRESSER
barn
house
Rev
Δ 19°56LT
D 5°
R 1146.3
T 201.4
L 398.7
E 17.5'
Bank ½" per ft
CONSTRUCT APPROACH LT.
162+75
CONSTRUCT DRIVE
161+25 to 162+75
169+60
158+90
NON-GOV'T. PARTCIPATION
Install sleeves for water pipes across roadway.
Item 103
Sleeves, Item 431, to be furnished by the State.
TWO CABLE GUARD RAIL
158+00 - 160+20 Rt
170+98 - 172+00 Rt
21A
N 46°1'E
Sur. P.O.T. 170+54.4
22
PAUL FULLER
brush
DRESSER
BM #23
30" Elm
Elev. 1122.13
158+90
Water pipe sleeve
FERNANDO & MARIE ROY
LEOPOLD & JEANNETTE ROY
pasture
Sur. Pt 161.00
Rev. Pt 160+26.7
160+22.6
160.94
Δ 19°56LT D 4°
Turn-Out
PARCEL #21 A&B
INSTRUMENT W.D.O.E.
DATE 6-29-50
GRANTOR LEOPOLD & JEANNETTE ROY
GRANTEE ST. OF VT.
RECORDED HARDWICK
BOOK 49
PAGE 58-9
DATE 7-26-50
REMARKS:- #21 B ON SHEET 37
ST JOHNSBURY & LAMOILLE COUNTY RAILROAD
shed
BM #24
S.O. Bridge
Elev. 1125.64
FERNANDO & MARIE ROY
162+00
400' VC
1141.87
-1.486%
-0.125%
Field change in grade
170+00
400' VC
1140.86
-1.183%
158+00 - 172+00
16" Base
BM #23 S/R 30" Elm 144' Rt Sta 159+00 Elev 1122.13'
BM #24 Spk on bridge wing 217' Rt Sta 169+00 Elev 1125.64'
HARDWICK
GREENSBORO
Series E No. 1(17.3)
Sheet 36 of 120 Sheets