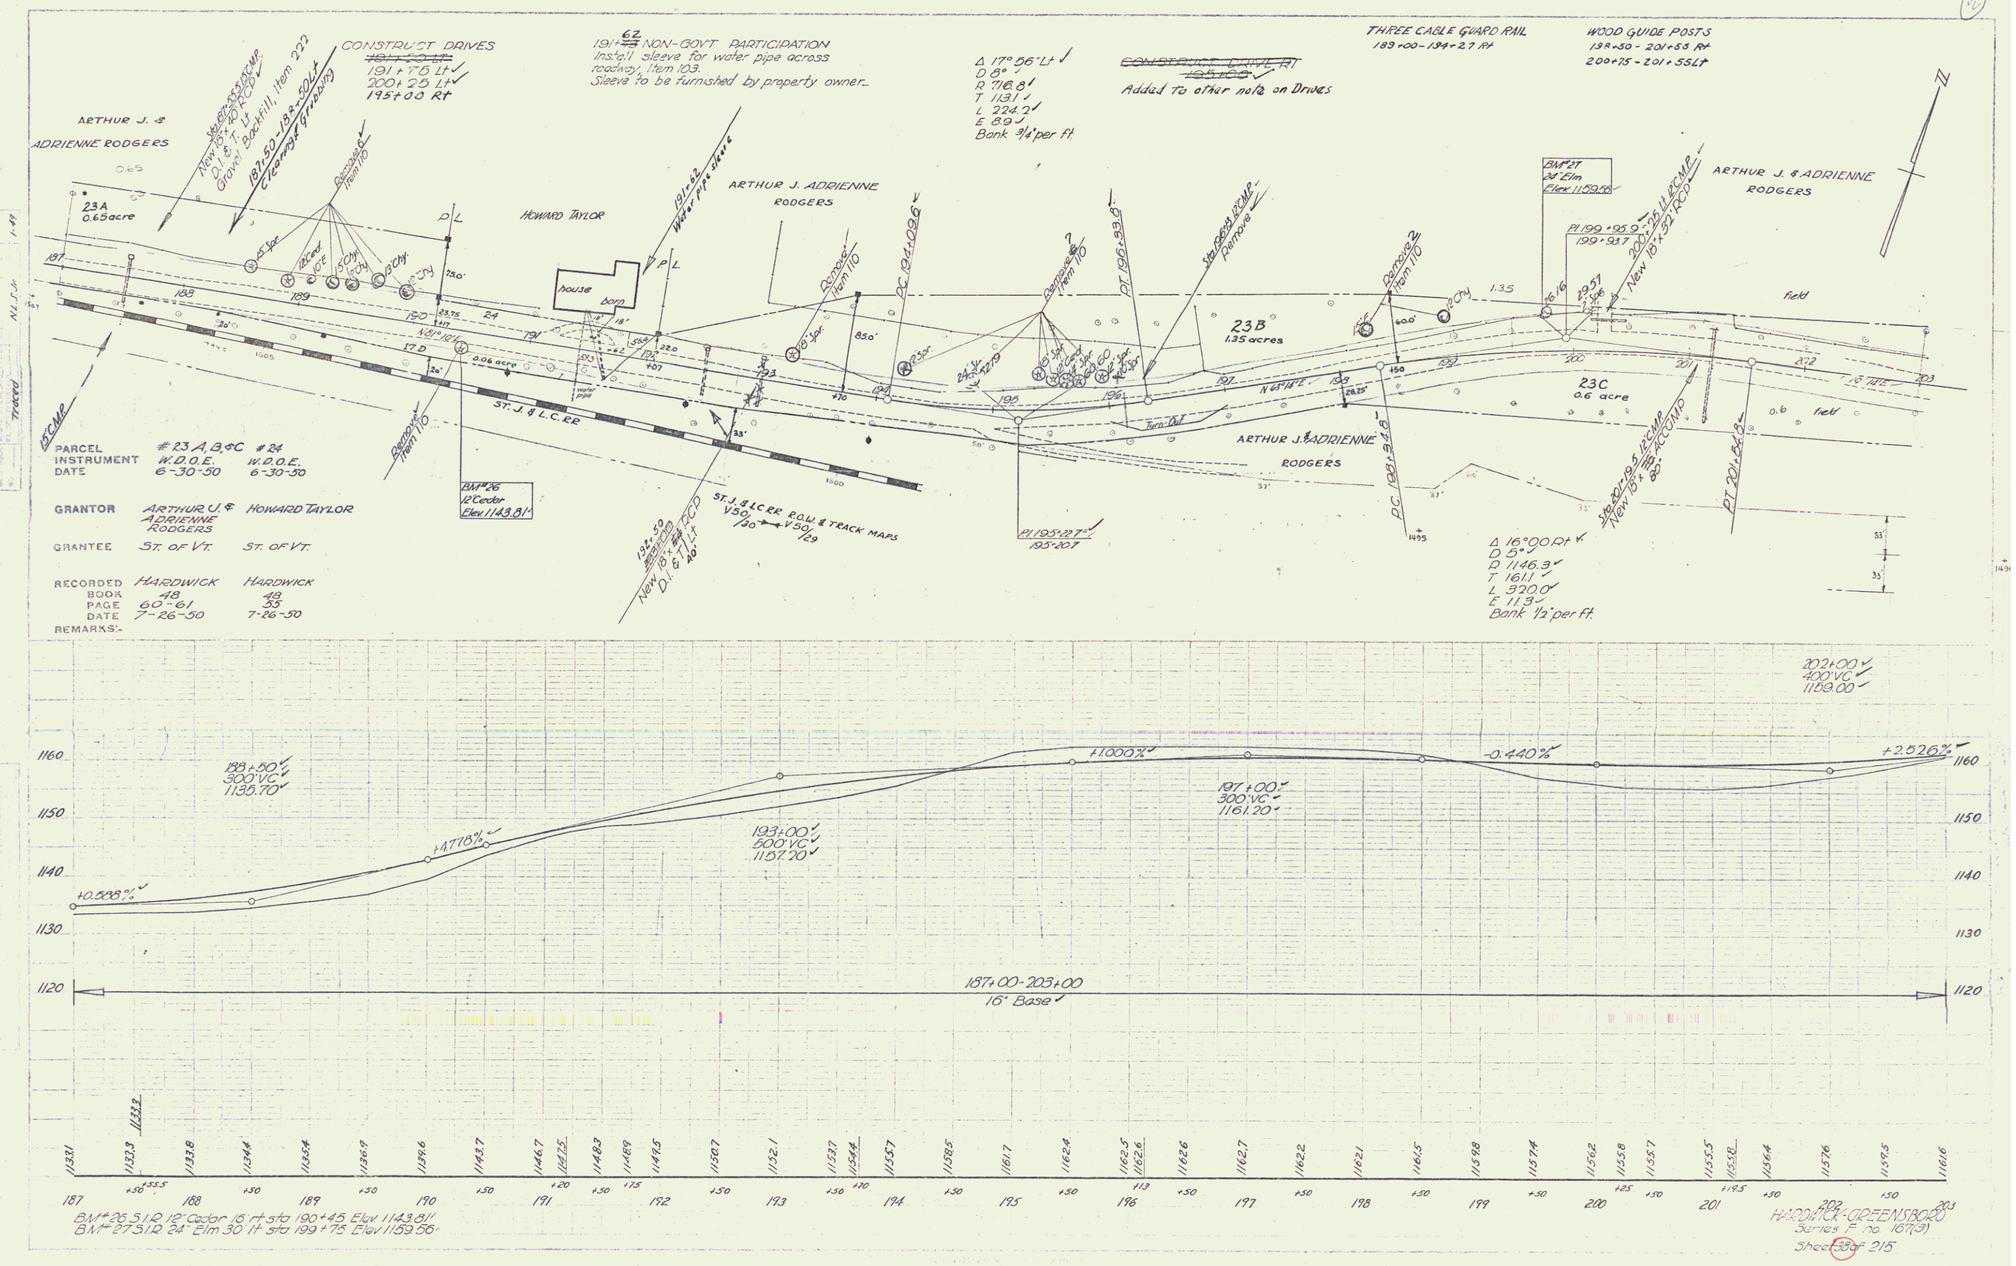
CONSTRUCT DRIVES
191+76 Lt
200+75 Lt
195+00 Rt
191+62 NON-GOVT PARTICIPATION
Install sleeve for water pipe across roadway, Item 103.
Sleeve to be furnished by property owner.
Δ 17° 56' Lt
D 8°
R 716.8'
T 113.1
L 224.2
E 8.9
Bank 3/4' per ft
Added to other note on Drives
THREE CABLE GUARD RAIL
189+00 - 194+27 Rt
WOOD GUIDE POSTS
198+50 - 201+55 Rt
200+75 - 201+55 Lt
ARTHUR J. & ADRIENNE RODGERS
23A
0.65 acre
HOWARD TAYLOR
house
barn
ARTHUR J. ADRIENNE RODGERS
23B
1.35 acres
23C
0.6 acre
field
ST. J. & L.C. RR
ST. J. & LC RR R.O.W. & TRACK MAPS
BM #26
12" Cedar
Elev 1143.81'
BM #27
24" Elm
Elev 1159.56'
PARCEL
INSTRUMENT
DATE
#23 A, B, & C
W.D.O.E.
6-30-50
#24
W.D.O.E.
6-30-50
GRANTOR
ARTHUR J. & ADRIENNE RODGERS
HOWARD TAYLOR
GRANTEE
ST. OF VT.
ST. OF VT.
RECORDED
BOOK
PAGE
DATE
HARDWICK
48
60-61
7-26-50
HARDWICK
48
59
7-26-50
REMARKS:-
Δ 16° 00' Rt
D 5°
R 1146.3
T 161.1
L 920.0
E 11.9
Bank 1/2' per ft
+0.588%
+4.718%
+1.000%
-0.440%
+2.526%
188+50
300' VC
1135.70
193+00
500' VC
1157.70
197+00
300' VC
1161.20
202+00
400' VC
1159.00
187+00-203+00
16' Base
BM #26 S 1/2 12" Cedar 16 rt sta 190+45 Elev 1143.81'
BM #27 S 1/2 24" Elm 30 lt sta 199+75 Elev 1159.56'
HARDWICK-GREENSBORO
Series F no. 167(9)
Sheet 38 of 215

12