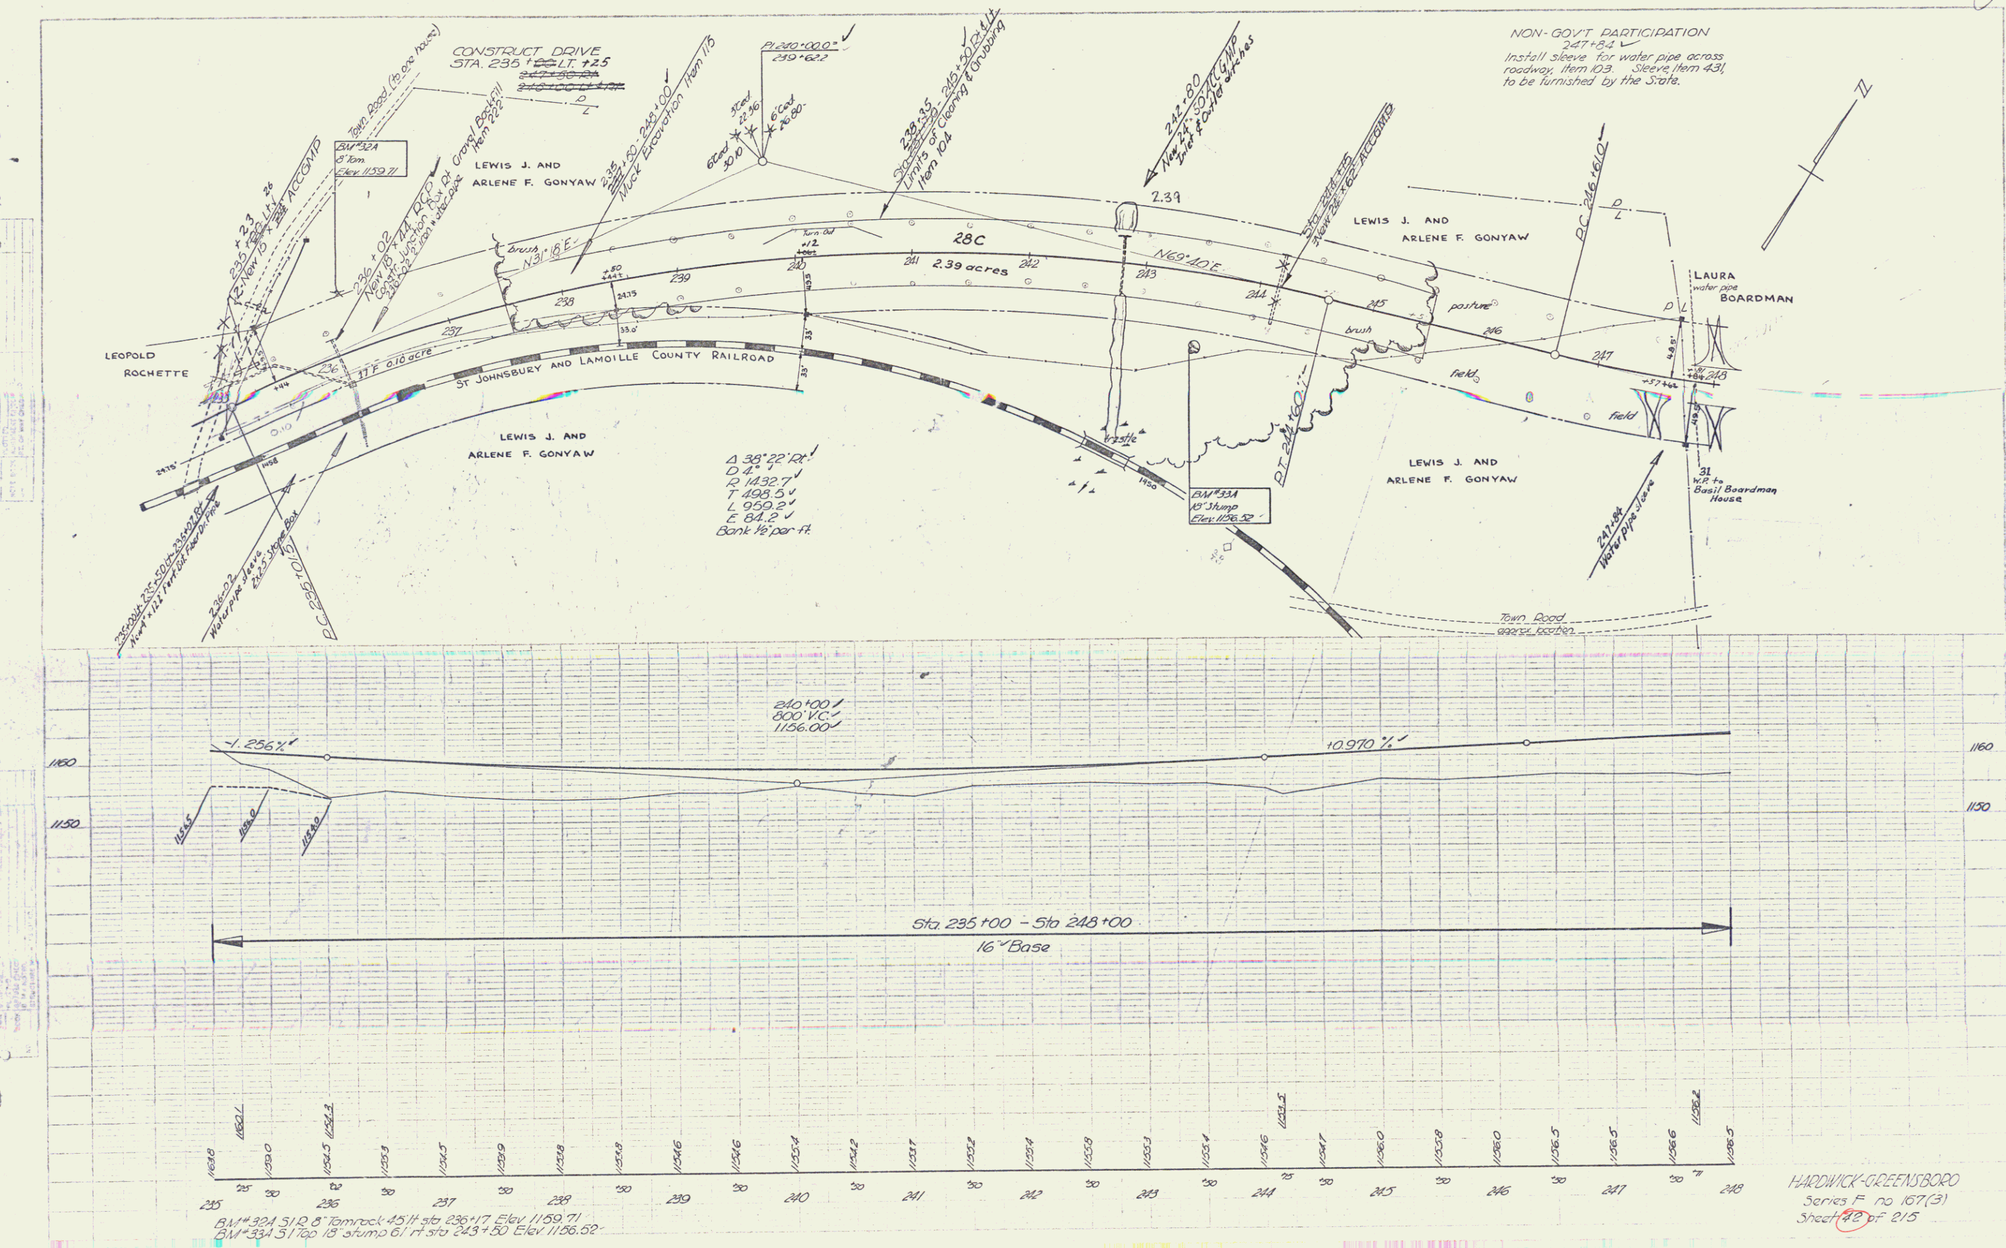

HARDWICK-GREENSBORO
Series F no. 167(3)
Sheet 42 of 215