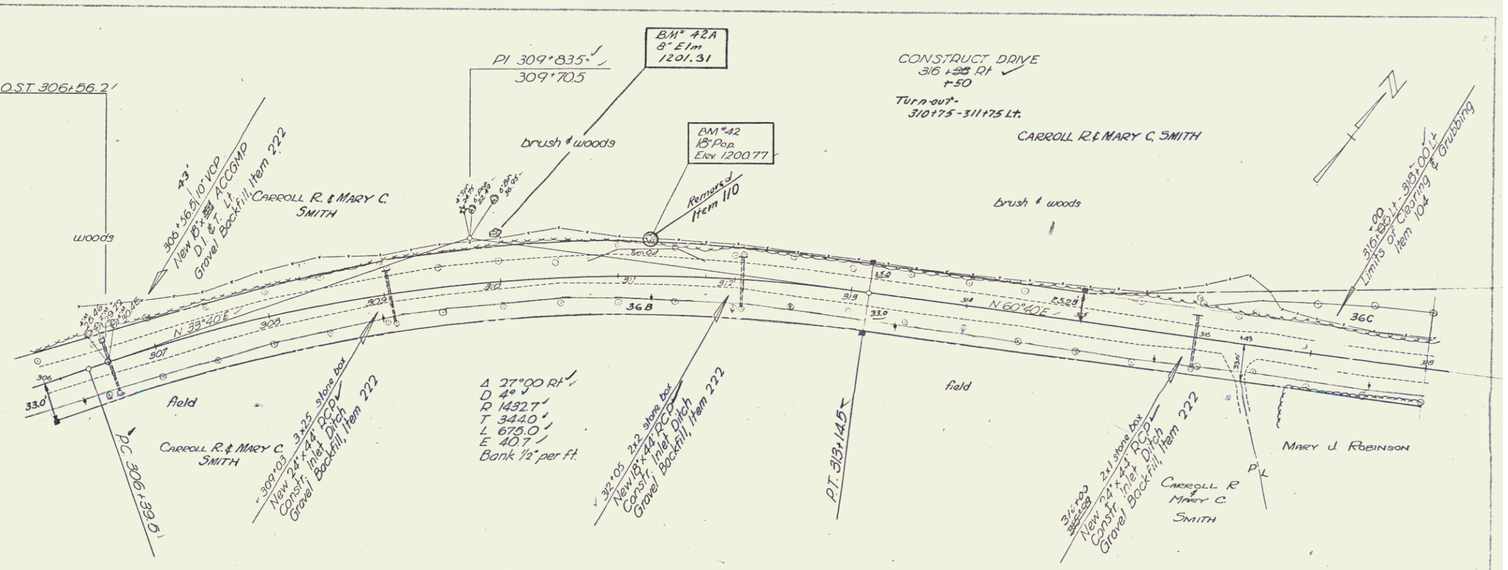

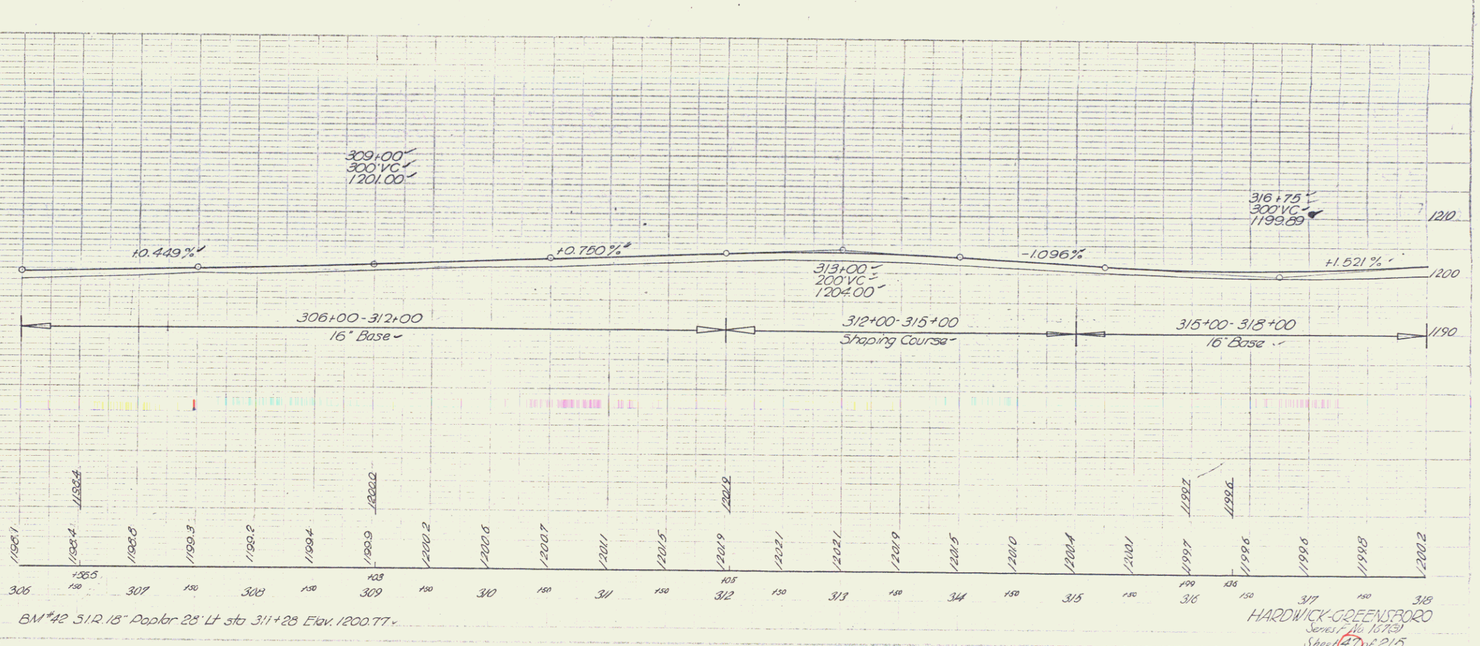

BM#42 5.12.18" Poplar 28' Lt sta 311+28 Elev. 1200.77

HARDWICK-GREENSBORO
Series 1 No. 1(17)
Sheet 47 of 215

20