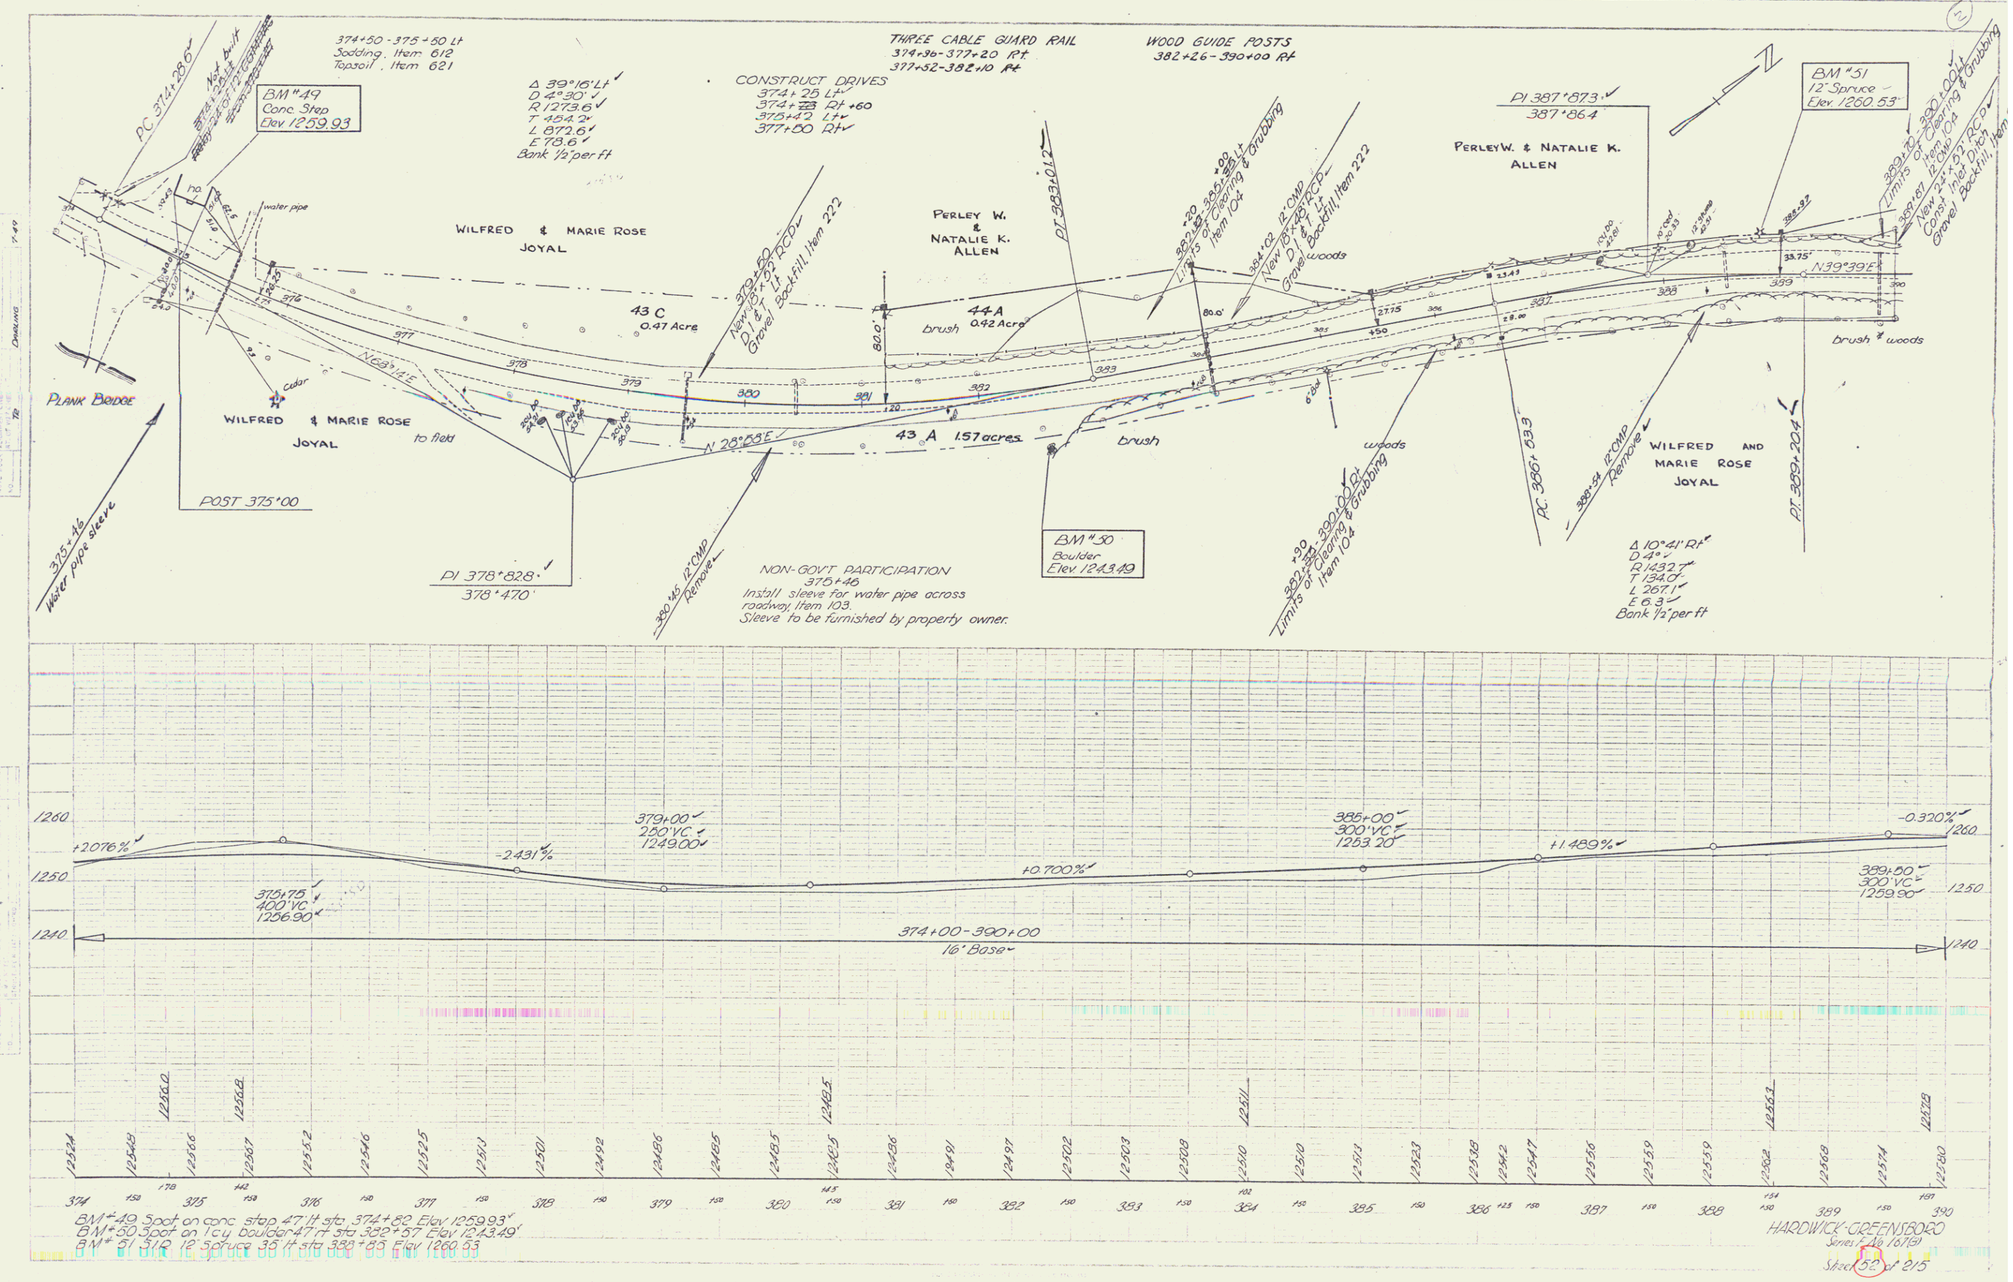
374+50 - 375+50 Lt
Sodding, Item 612
Topsoil, Item 621
BM #49
Conc Step
Elev 1259.93
PC 374+29.6
Δ 39°16' Lt
D 4°30'
R 1273.6
T 454.2
L 872.6
E 73.6
Bank 1½ per ft
CONSTRUCT DRIVES
374+25 Lt
374+75 Rt +60
375+70 Lt
377+00 Rt
THREE CABLE GUARD RAIL
374+36-377+20 Rt
377+52-382+10 Rt
WOOD GUIDE POSTS
382+26-390+00 Rt
WILFRED & MARIE ROSE JOYAL
43 C
0.47 Acre
PERLEY W. & NATALIE K. ALLEN
44 A
0.42 Acre
brush
43 A 1.57 acres
brush
woods
PERLEY W. & NATALIE K. ALLEN
PI 387+87.3
387+86.4
BM #51
12" Spruce
Elev 1260.53
N39°39'E
brush & woods
WILFRED AND MARIE ROSE JOYAL
PLANK BRIDGE
cedar
water pipe
to field
N 28°53'E
POST 375+00
375+46
Water pipe sleeve
PI 378+82.8
378+47.0
378+46 12" CMP
Remove
NON-GOVT PARTICIPATION
375+46
Install sleeve for water pipe across roadway, Item 103.
Sleeve to be furnished by property owner.
BM #50
Boulder
Elev 1243.49
PC 386+53.3
389+54 12" CMP
Remove
Δ 10°41' Rt
D 4°
R 1432.7
T 134.0
L 267.1
E 6.3
Bank 1½ per ft
PT 389+20.4
+2.076%
-2.431%
+0.700%
+1.489%
-0.320%
375+75
400' VC
1256.90
379+00
250' VC
1249.00
385+00
300' VC
1253.20
389+50
300' VC
1259.90
374+00-390+00
16' Base
1260
1250
1240
BM #49 Spot on conc step 47' lt sta 374+80 Elev 1259.93
BM #50 Spot on 1 cy boulder 47' rt sta 382+57 Elev 1243.49
BM # 51 51.0 12" Spruce 35' lt sta 388+85 Elev 1260.53
HARDWICK-GREENSBORO
Series 1-46 16/19
Sheet 52 of 215