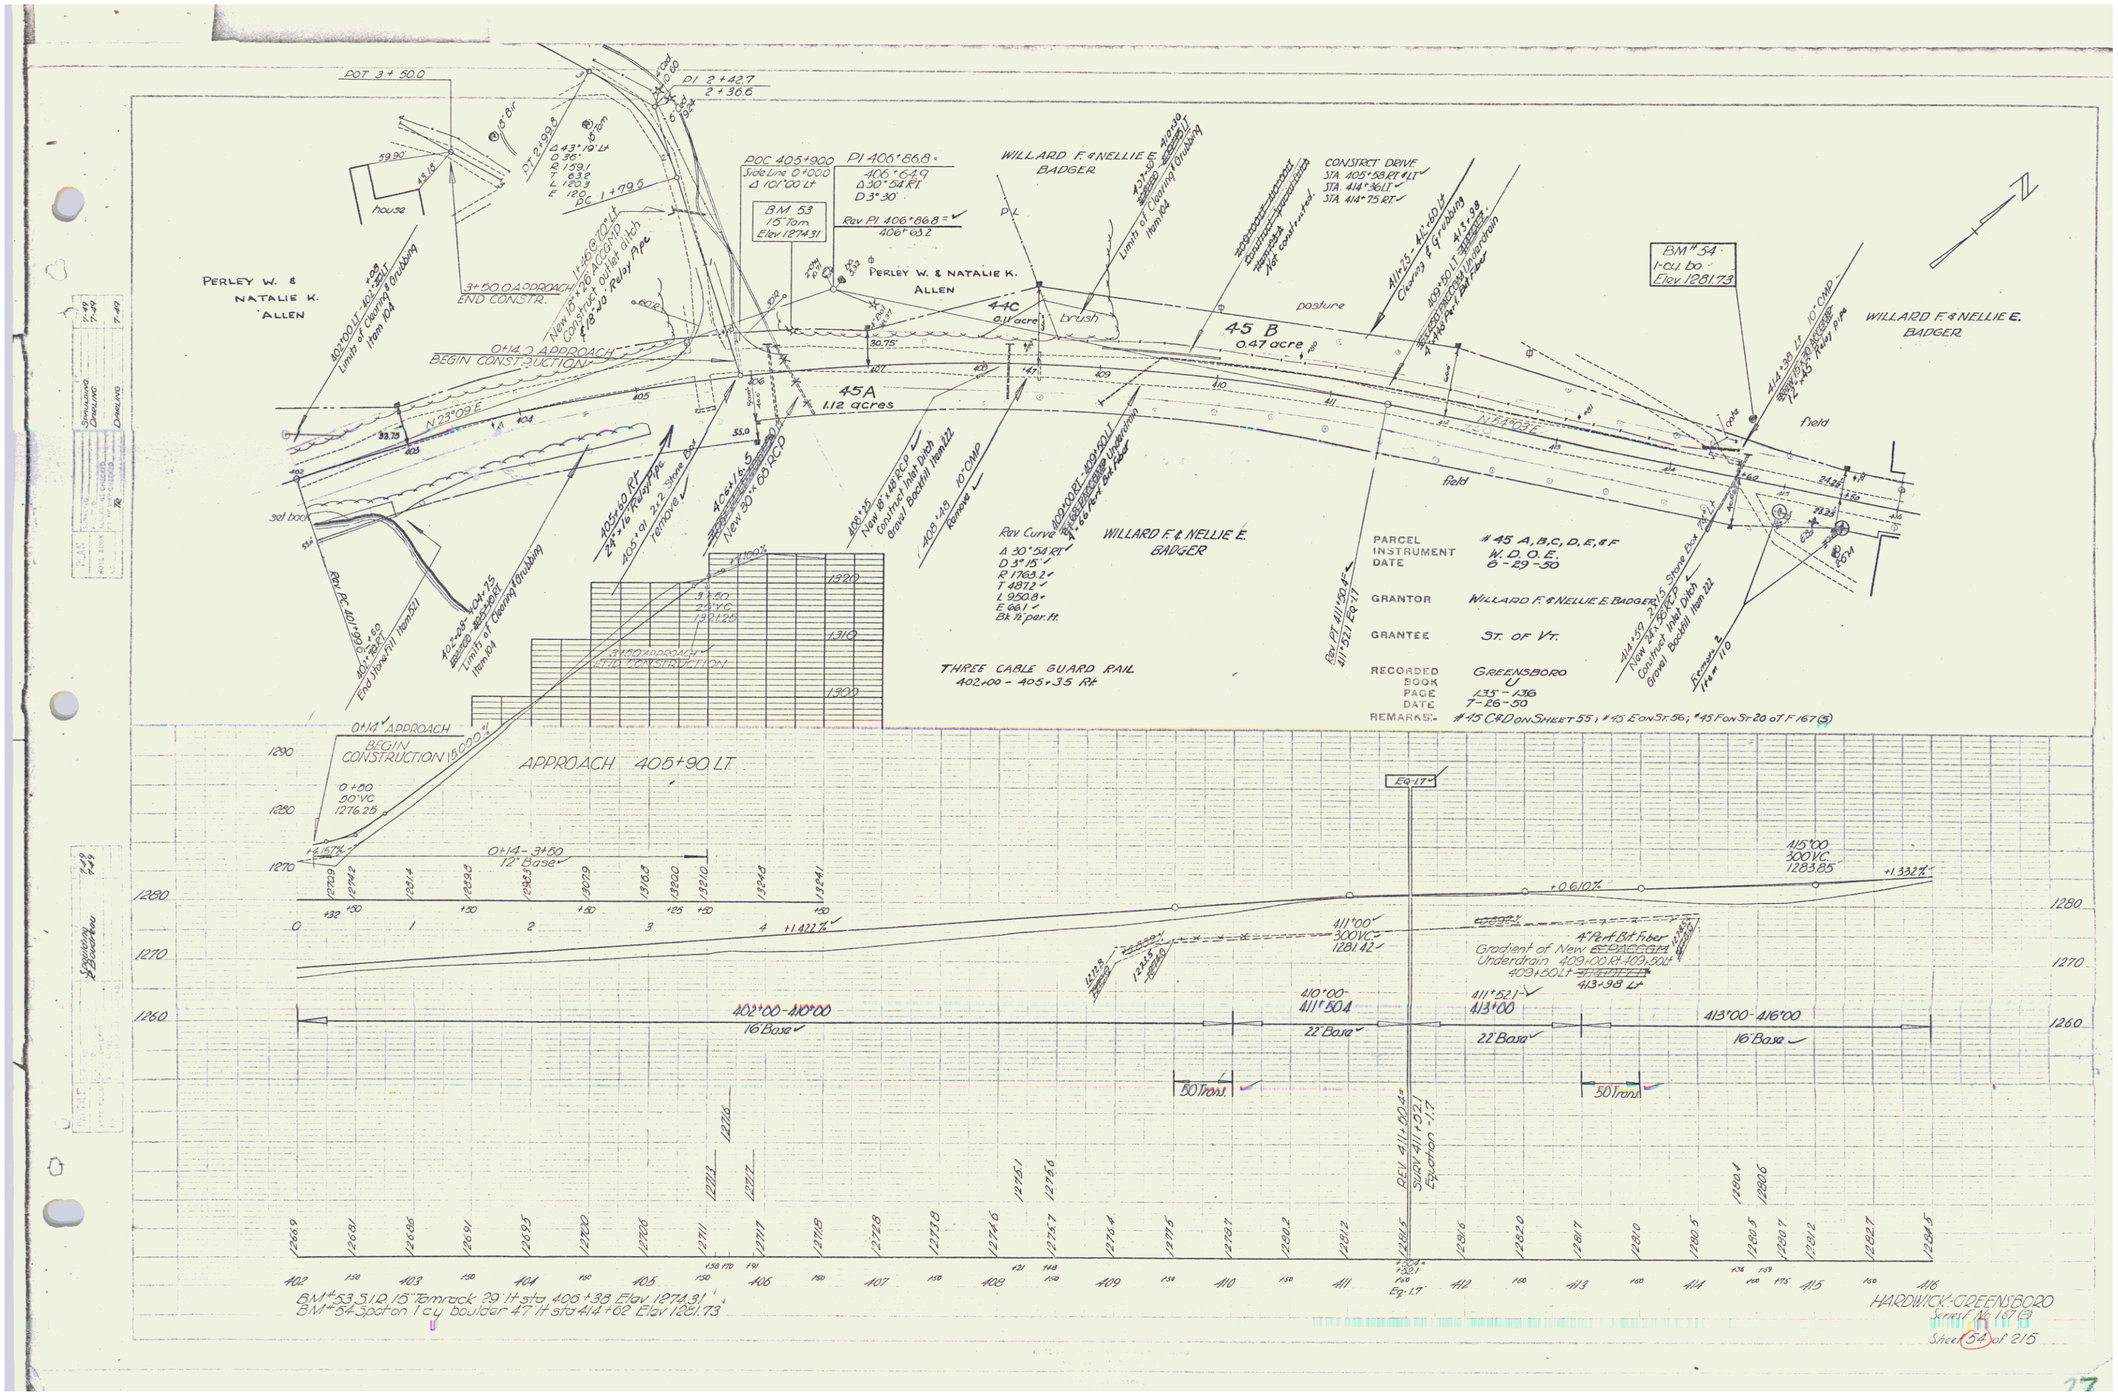
PERLEY W. & NATALIE K. ALLEN
WILLARD F. & NELLIE E. BADGER
45 B
0.47 acre
45A
1.12 acres
44C
0.11 acre
PARCEL #45 A, B, C, D, E, & F
INSTRUMENT W.D.O.E.
DATE 6-29-50
GRANTOR WILLARD F. & NELLIE E. BADGER
GRANTEE ST. OF VT.
RECORDED GREENSBORO
BOOK U
PAGE 135-136
DATE 7-26-50
REMARKS:- #45 C&D ON SHEET 55; #45 E ON ST. 56; #45 F ON ST. 20 & T. F. 167 (5)
THREE CABLE GUARD RAIL 402.00 - 405+35 Rt.
APPROACH 405+90 LT.
BM #53 1-Q.R. 15" Tamarack 29' lt. sta. 405+33 Elev. 1274.31
BM #54 3 pt. 1 cy boulder 47' lt. sta. 414+62 Elev. 1281.73
HARDWICK-GREENSBORO
Sheet 54 of 215