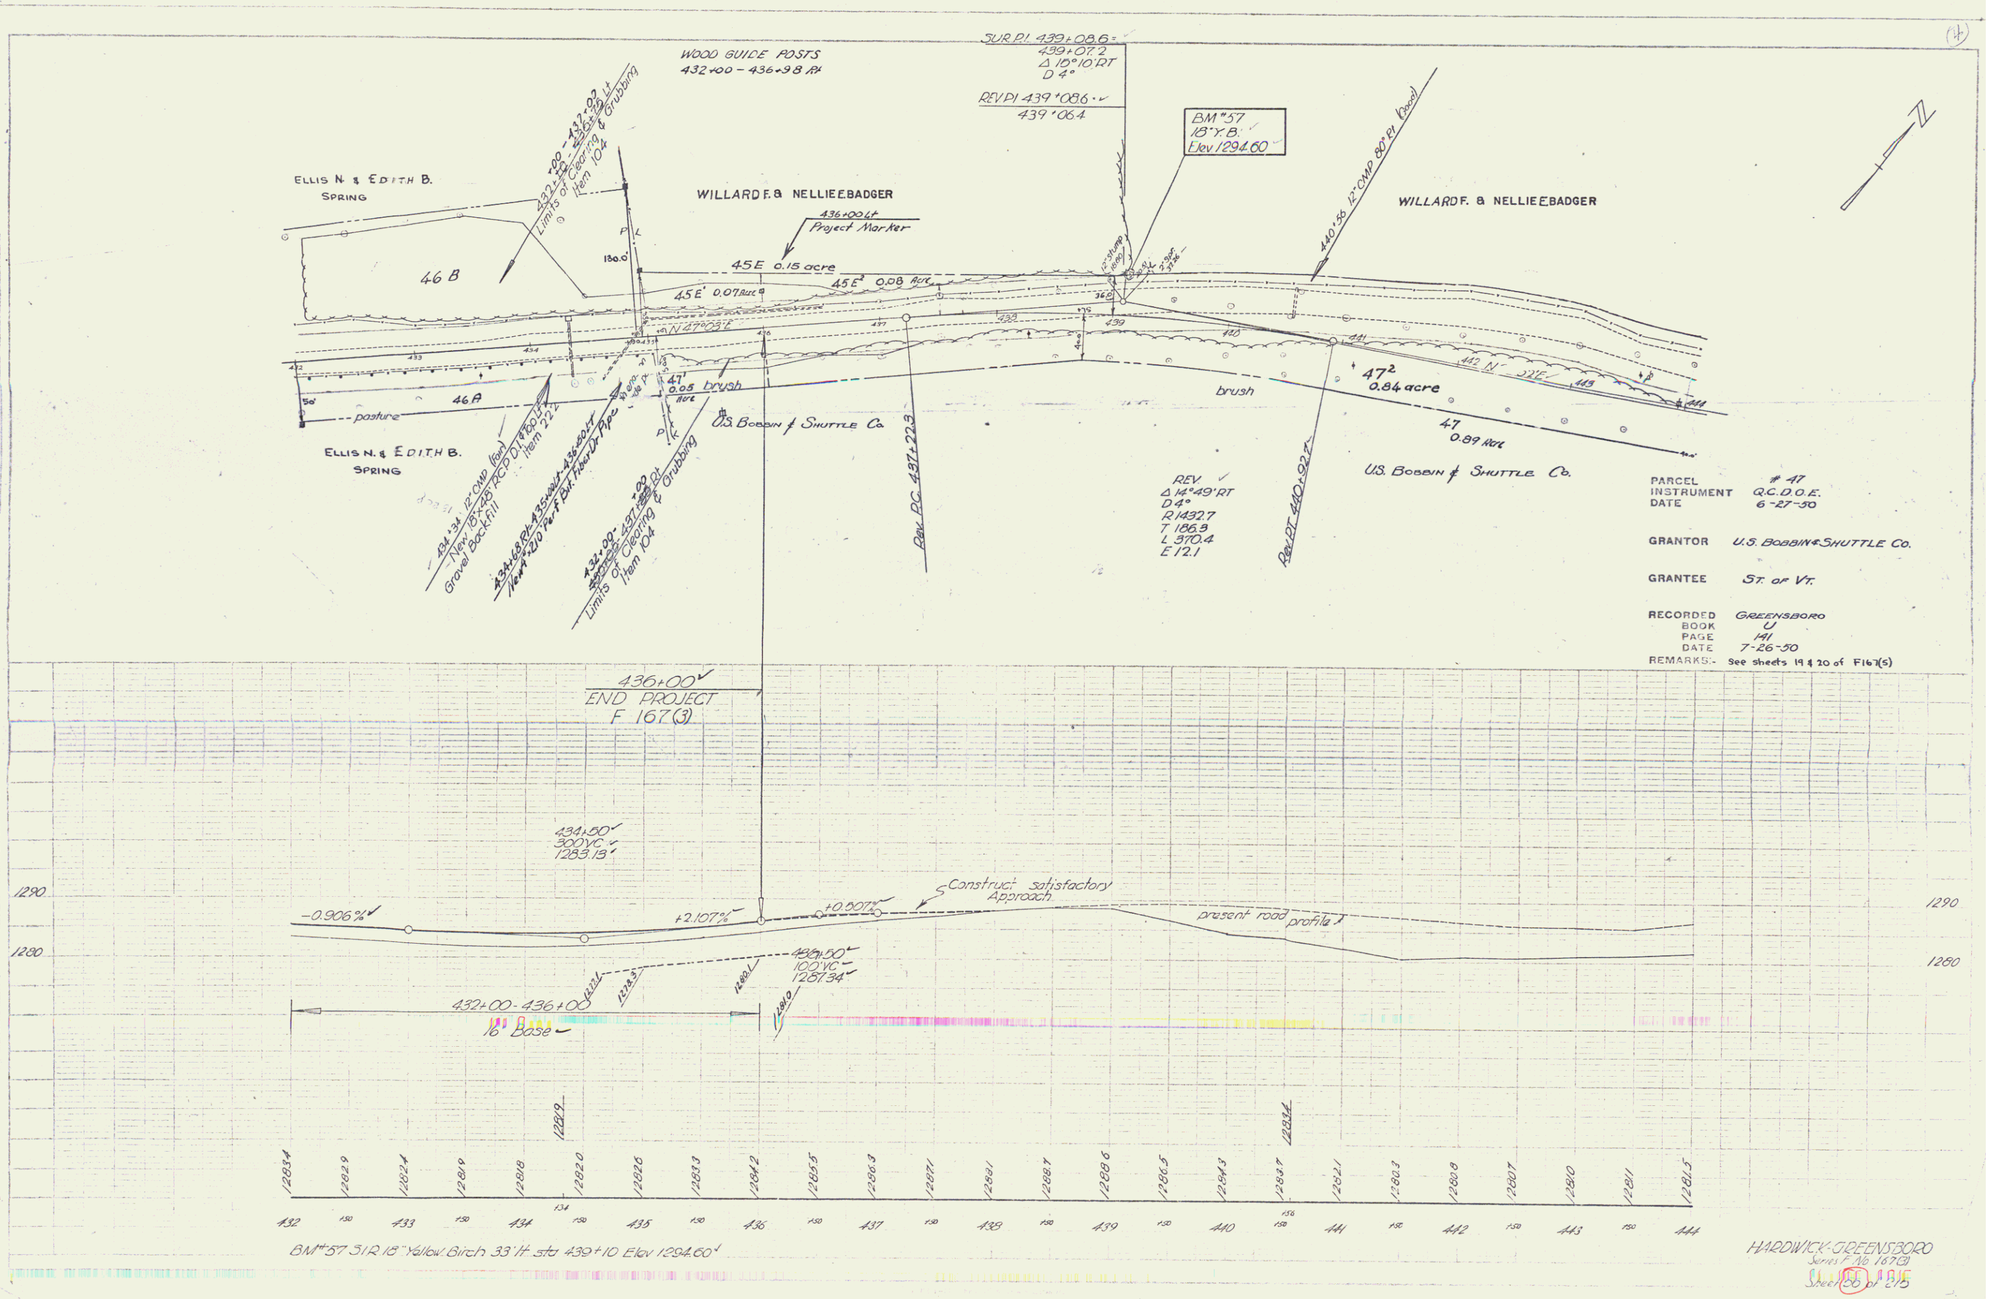
WOOD GUIDE POSTS
432+00 - 436+98 Rt
SUR PI 439+08.6
439+07.2
Δ 10°10' RT
D 4°
REV PI 439+08.6
439+06.4
B.M. #57
18" Y.B.
Elev 1294.60
ELLIS N. & EDITH B. SPRING
WILLARD F. & NELLIE E. BADGER
436+00 Lt
Project Marker
WILLARD F. & NELLIE E. BADGER
440+56 12" CMP 80' Rt (Level)
432+00 - 432+98 Lt
Limits of Clearing & Grubbing
Item 104
46 B
45 E 0.15 acre
45 E² 0.08 Acre
45 E¹ 0.07 Acre
N 47°05' E
47¹ 0.08 Acre brush
46 A
pasture
ELLIS N. & EDITH B. SPRING
U.S. Bobbin & Shuttle Co.
brush
47² 0.84 acre
47 0.89 Acre
U.S. Bobbin & Shuttle Co.
434+34 12" CMP (Rm)
New 18"x48" PCP Dt 8+80 Lt
Gravel Backfill
Item 122
435+48 Rt - 435+80 Lt - 436+00 Lt
New 4"x10' Vitr. Bit. Fiber Dr. Pipe
432+00 - 437+98 Lt
Limits of Clearing & Grubbing
Item 104
Rev. PC 437+22.3
REV
Δ 14°49' RT
D 4°
R 1432.7
T 186.9
L 370.4
E 12.1
Rev. PT 440+92.7
PARCEL # 47
INSTRUMENT Q.C.D.O.E.
DATE 6-27-50
GRANTOR U.S. BOBBIN & SHUTTLE Co.
GRANTEE ST. of VT.
RECORDED GREENSBORO
BOOK U
PAGE 141
DATE 7-26-50
REMARKS:- See sheets 19 & 20 of F167(5)
436+00
END PROJECT
F 167(3)
434+50
300' VC
1283.18
-0.906%
+2.107%
+0.907%
Construct satisfactory Approach
present road profile
486+50
100' VC
1287.34
432+00 - 436+00
16' Base
1290
1280
432 433 434 435 436 437 438 439 440 441 442 443 444
B.M. #57 3/2 18" Yellow Birch 33' lt. sta 439+10 Elev 1294.60'
HARDWICK-GREENSBORO
Series F No 167(3)
Sheet 66 of 215

29