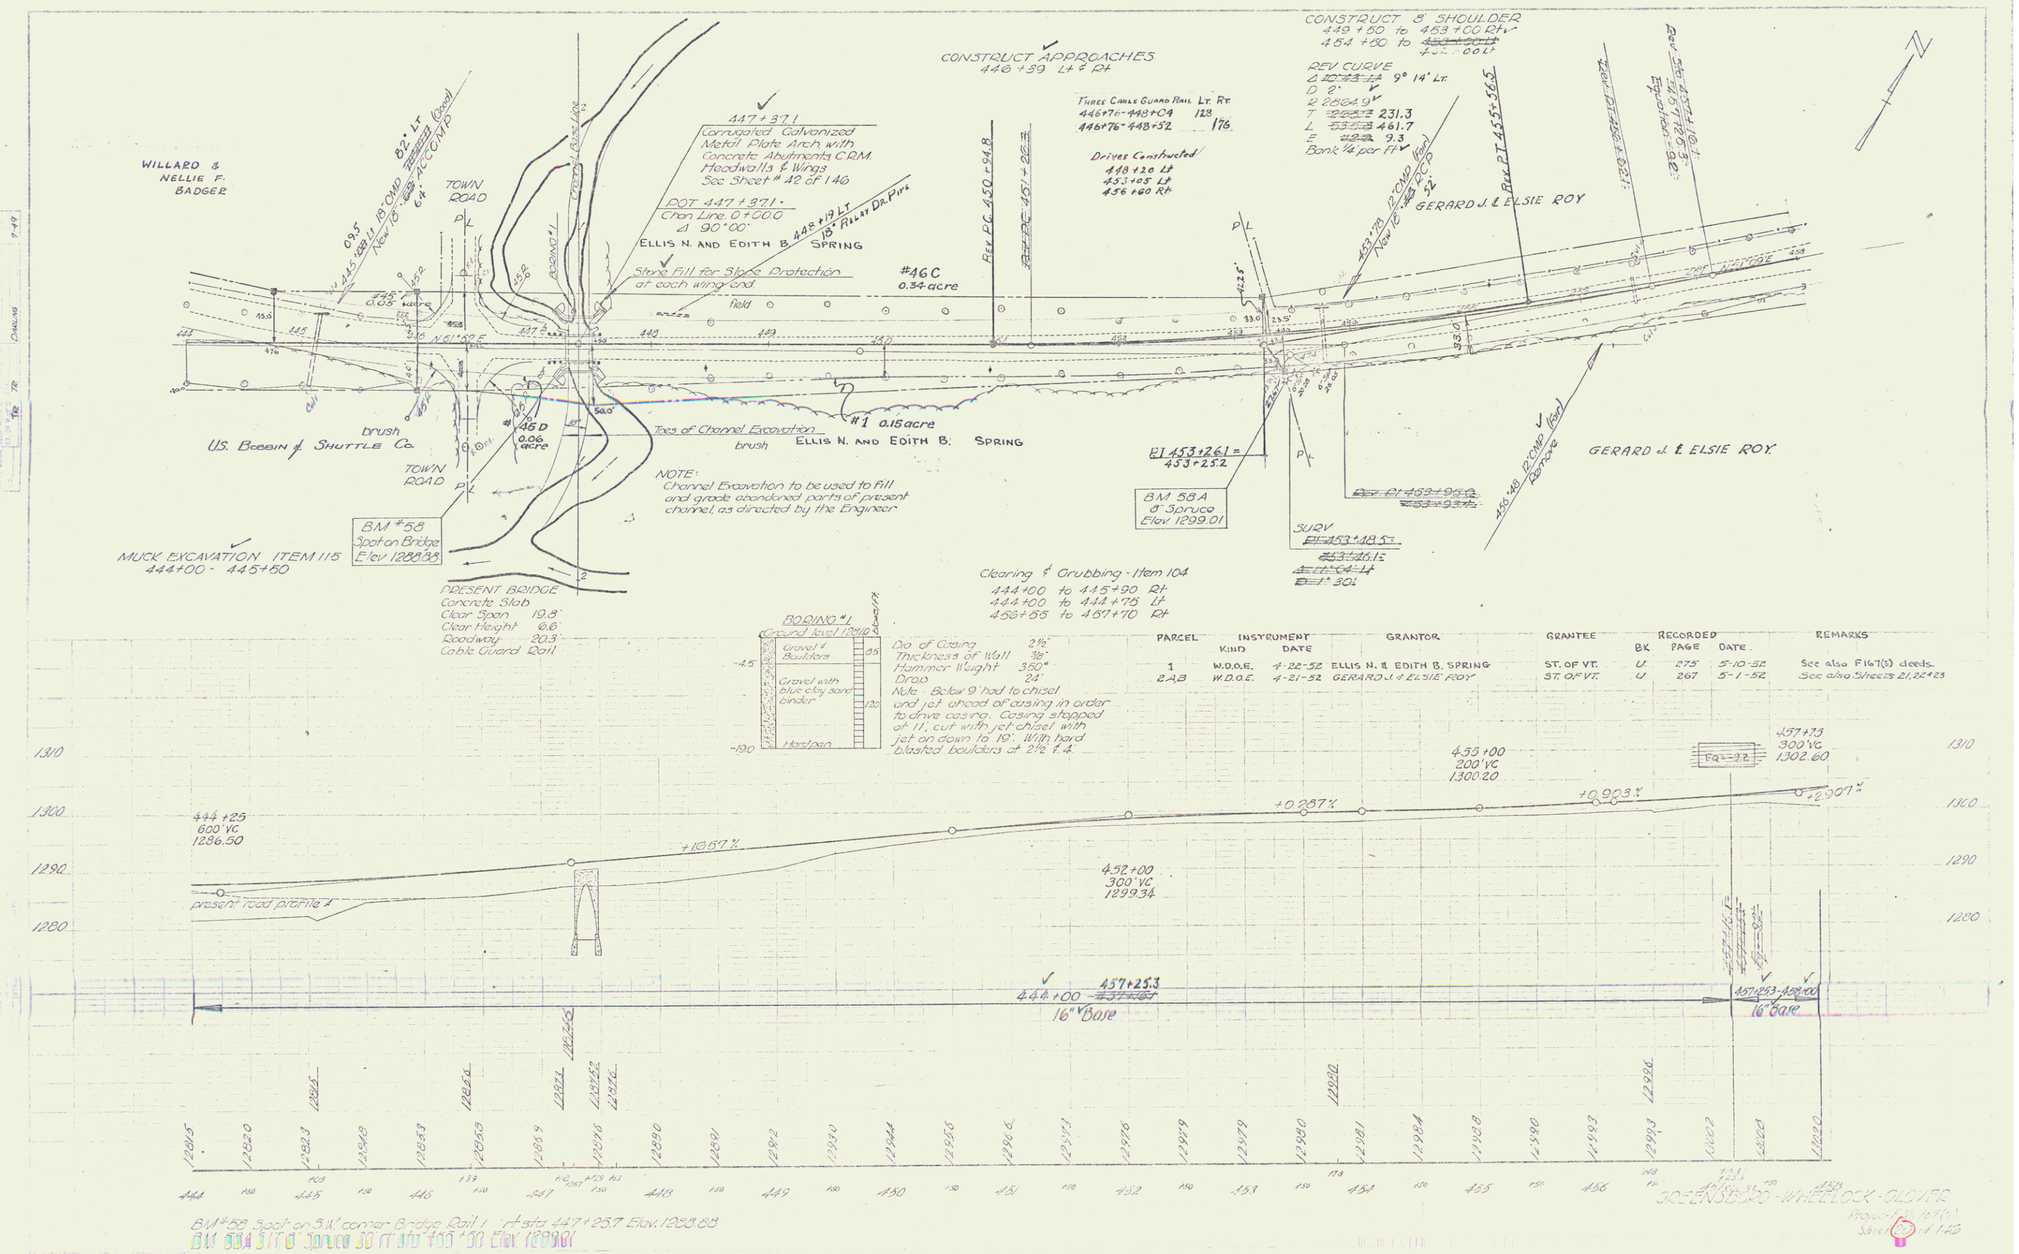

PARCEL	INSTRUMENT KIND	INSTRUMENT DATE	GRANTOR	GRANTEE	RECORDED BK	RECORDED PAGE	RECORDED DATE	REMARKS
1	W.D.O.E.	4-22-52	ELLIS N. & EDITH B. SPRING	ST. OF VT.	U	275	5-10-52	See also F167(3) deeds.
2,A,B	W.D.O.E.	4-21-52	GERARD J. & ELSIE ROY	ST. OF VT.	U	267	5-1-52	See also Sheets 21, 22 & 23

3