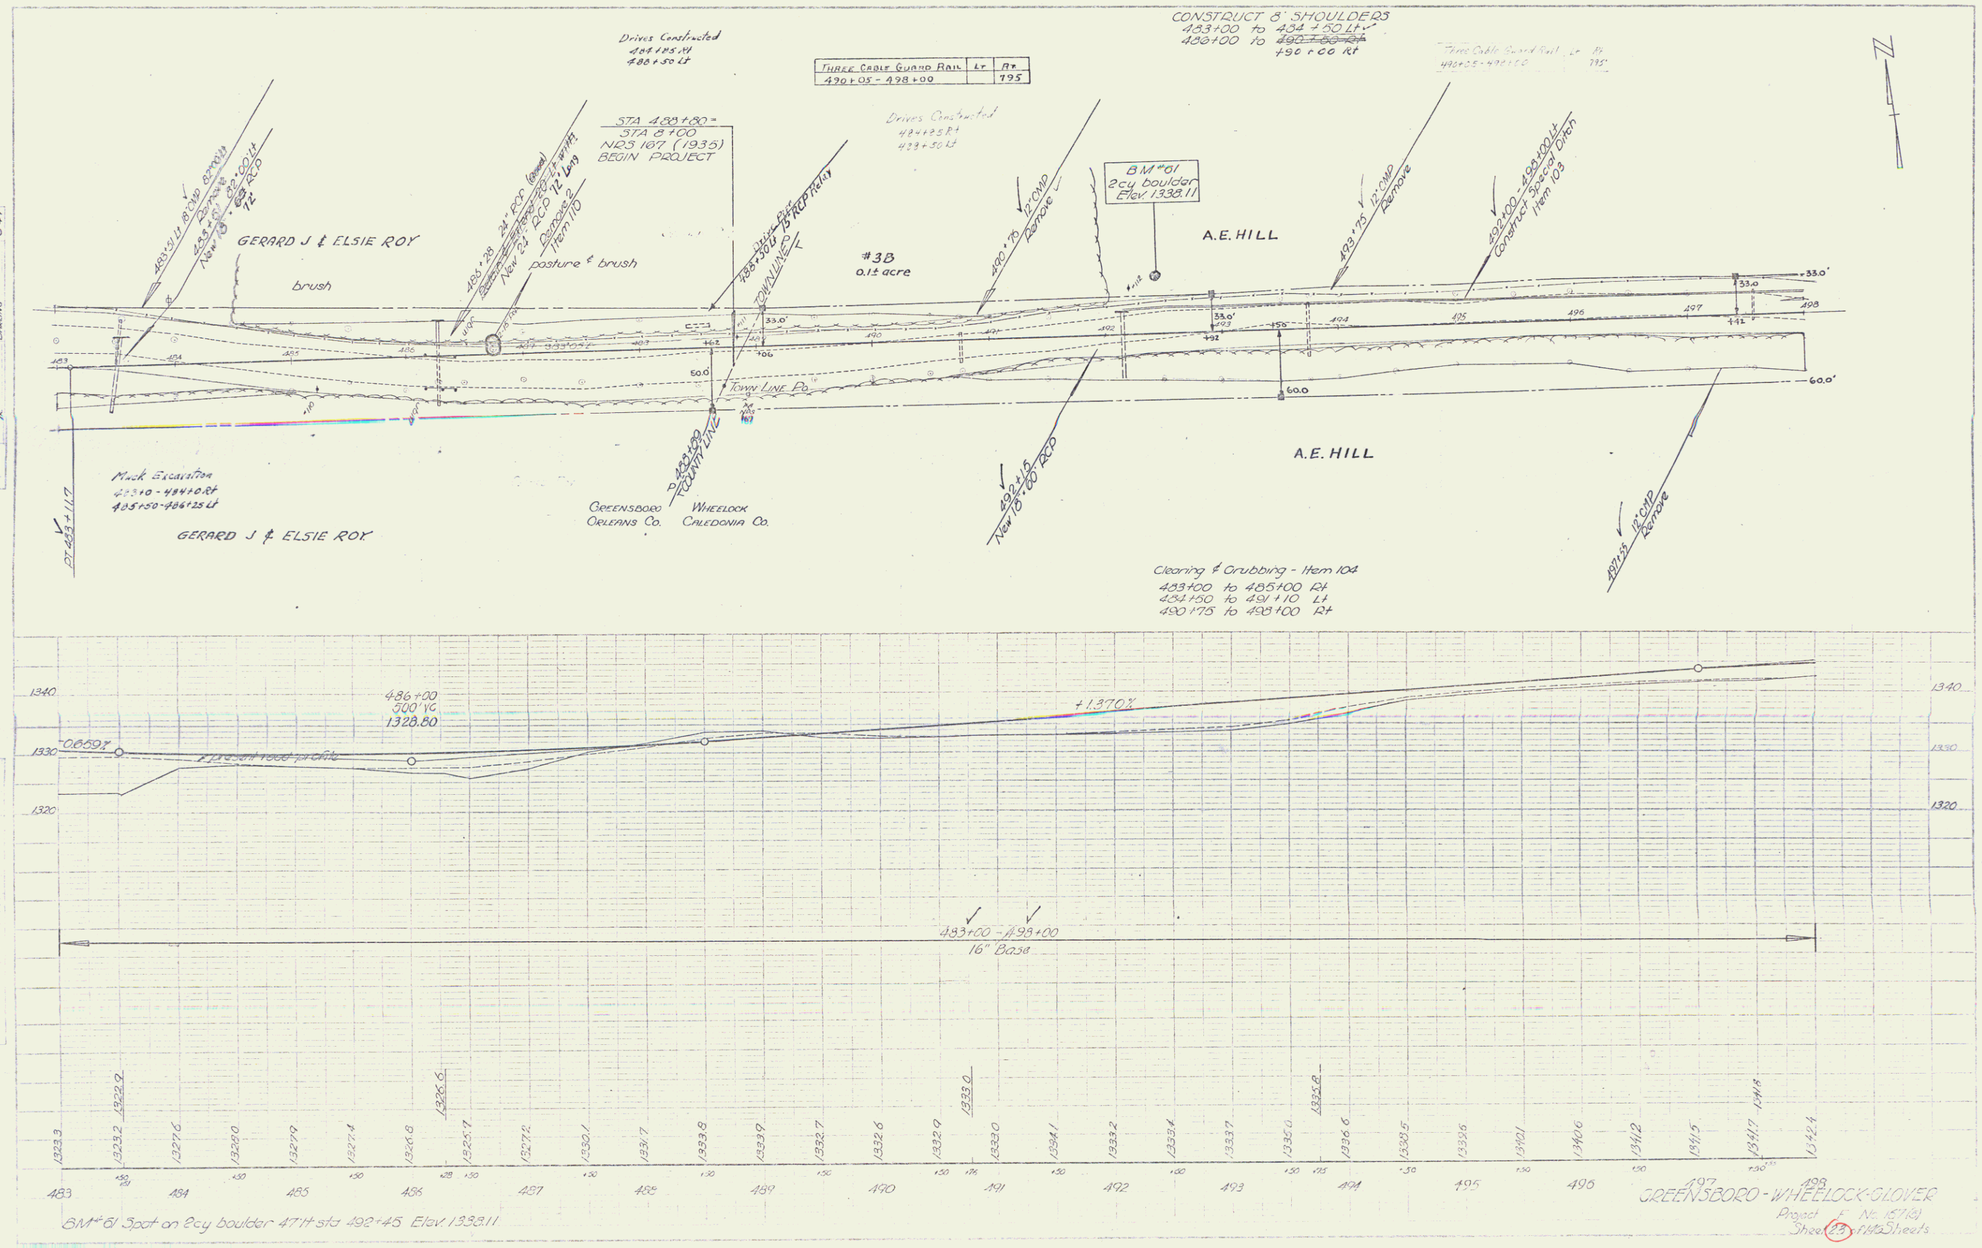

BM #61 Spot on 2cy boulder 47'lt sta 492+45 Elev 1338.11

GREENSBORO - WHEELOCK - GLOVER

Project F No. 1571(8)

Sheet 23 of 105 Sheets

6