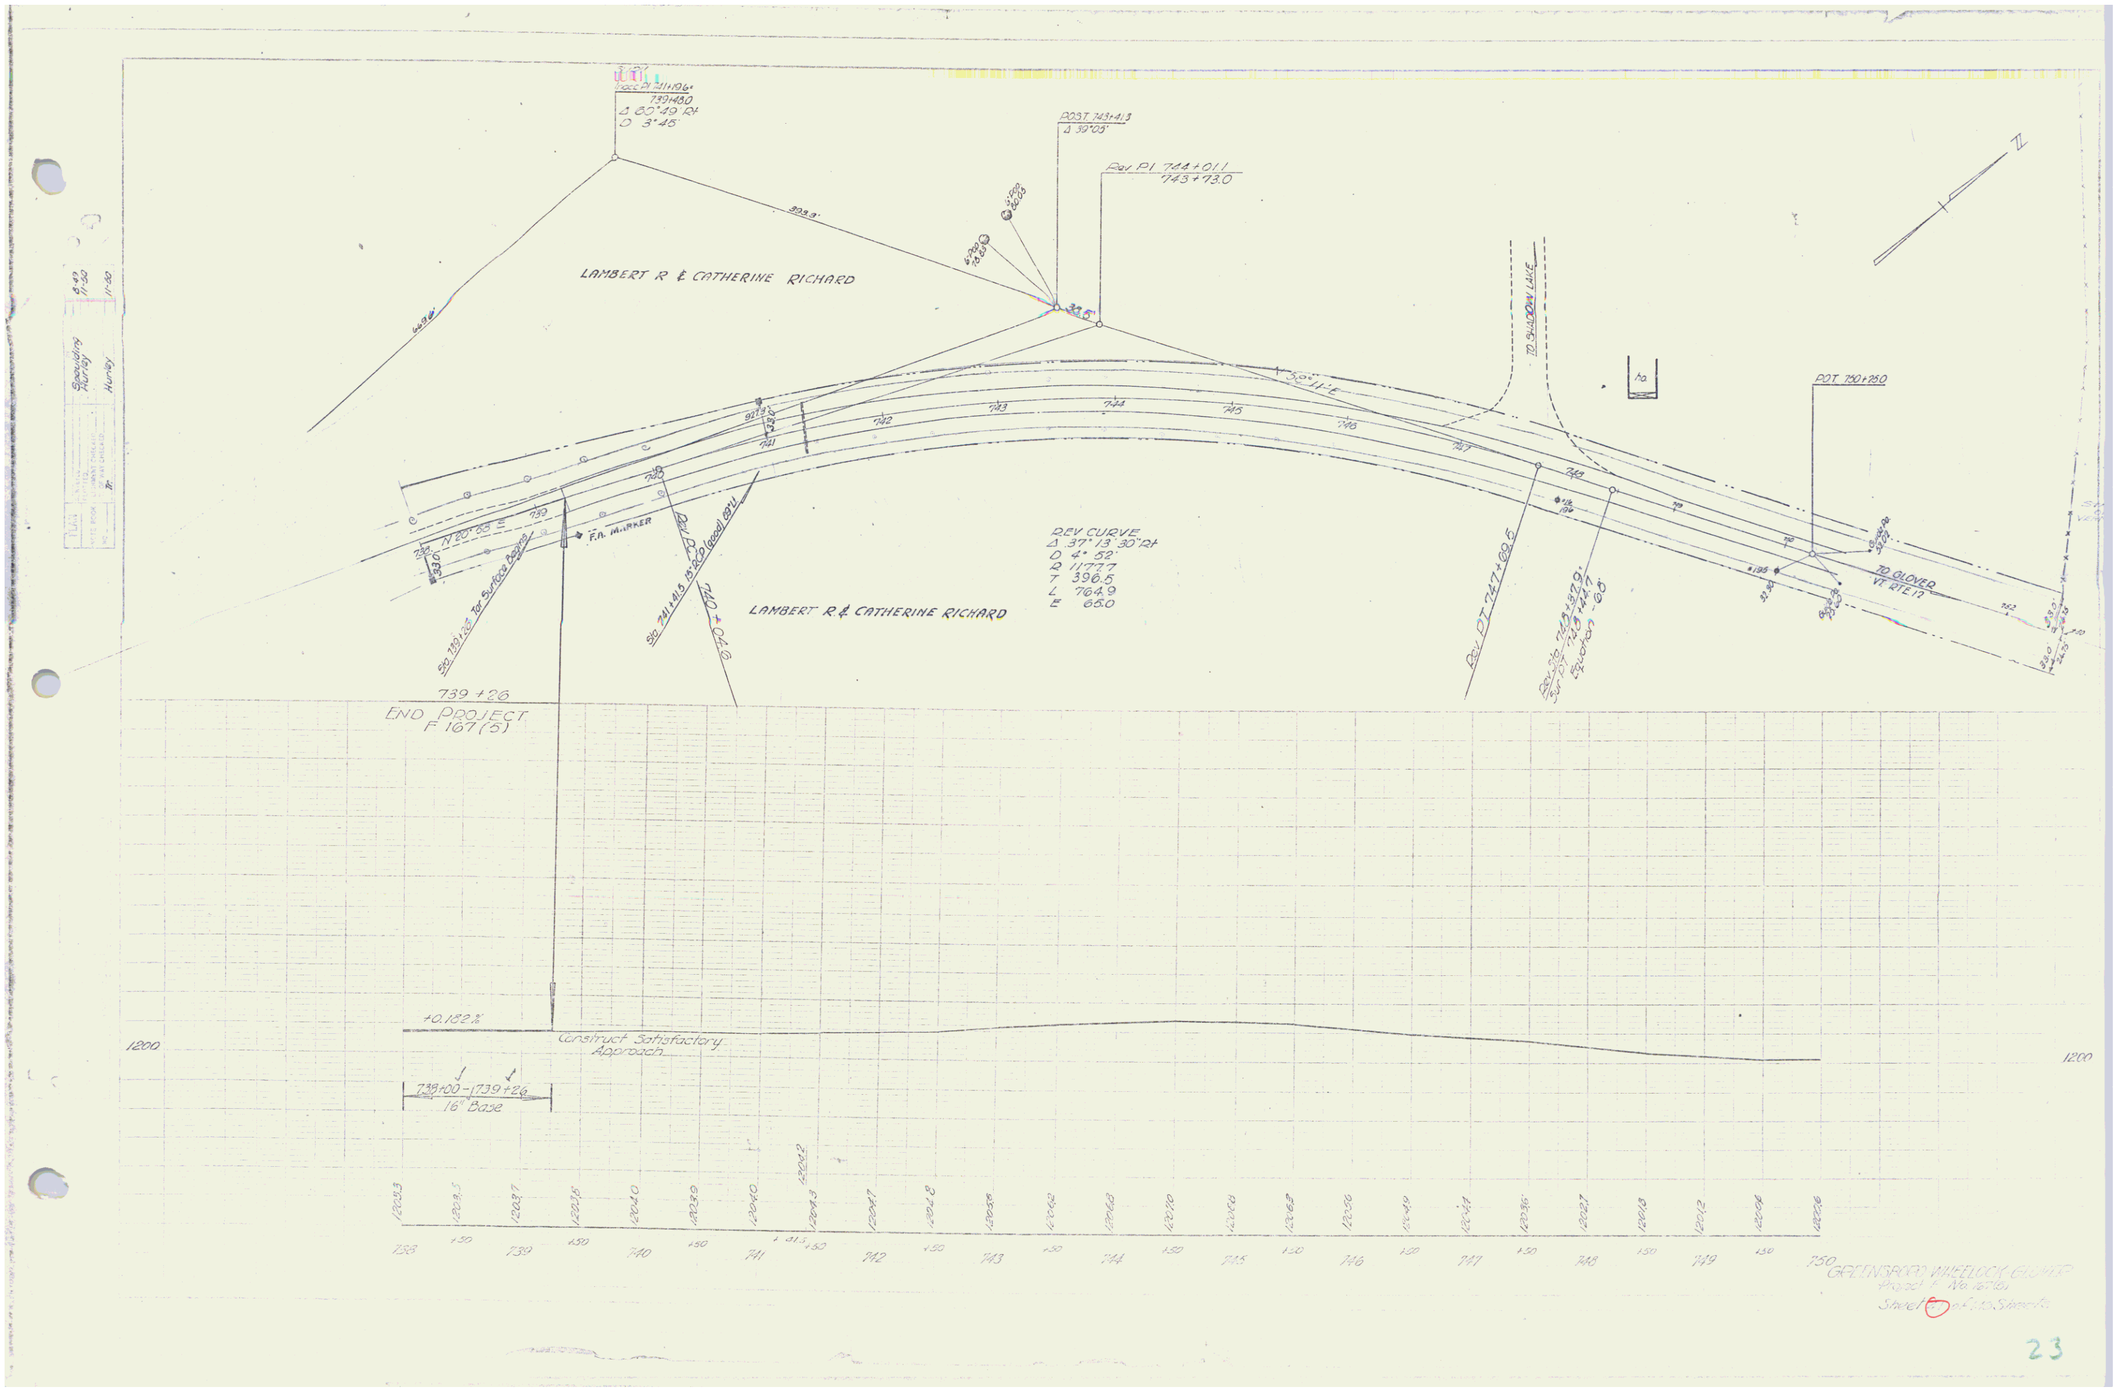
LAMBERT R & CATHERINE RICHARD
POST 743+413
Δ 39°05'
Rev PI 744+011
743+73.0
LAMBERT R & CATHERINE RICHARD
REV CURVE
Δ 37°13'30" Rt
D 4°52'
R 1177.7
T 396.5
L 764.9
E 66.0
POT 750+250
TO GLOVER
VT RTE 17
F.A. MARKER
END PROJECT
F 167(5)
739+26
+0.182%
Construct Satisfactory
Approach
739+00 - 1739+26
16" Base
Project F No. 167(5)
Sheet 23 of 23 Sheets

23