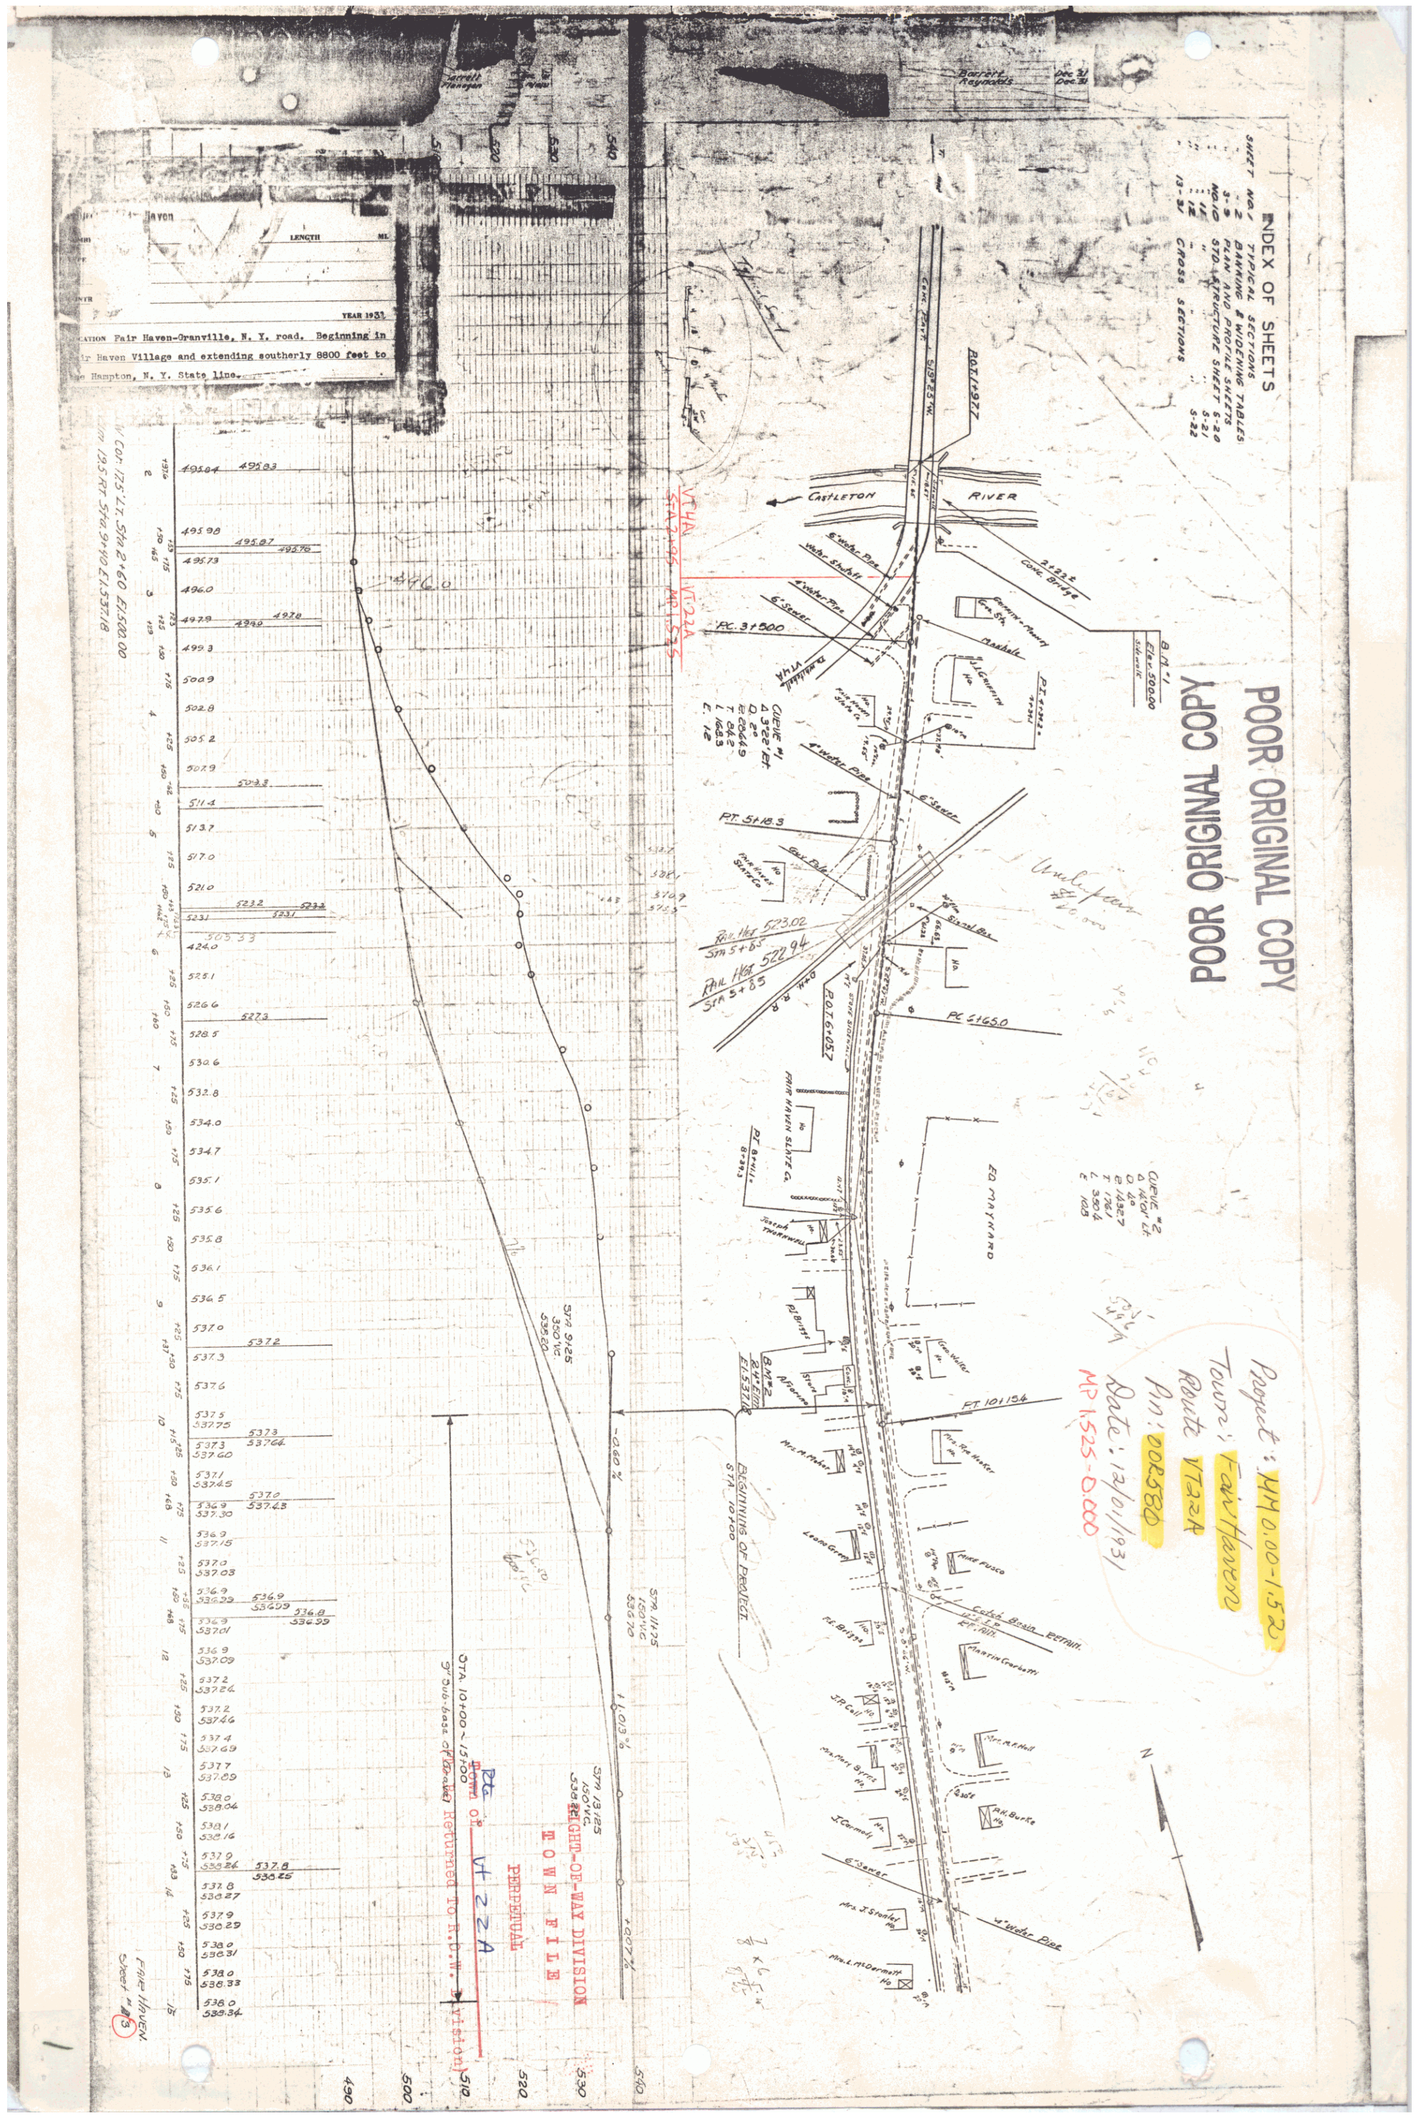
INDEX OF SHEETS
SHEET NO. 1 TYPICAL SECTIONS
" 2 " " " TABLES
" 3-5 PLAN AND PROFILE SHEETS
" NO. 10 " " " "
" 11 STD. STRUCTURE SHEET S-20
" 12 " " " S-21
" 13-31 CROSS SECTIONS S-22
POOR ORIGINAL COPY
POOR ORIGINAL COPY
Project: 4110.00-1.52
Town: Fair Haven
Route VT22A
P.I.N.: 008580
Date: 12/01/93
MP 1.525-0.000
Fair Haven
LENGTH MI.
YEAR 1933.
Castleton River
Ed Maynard
Fair Haven Slate Co.
Beginning of Project
STA. 10+00
Sta. 11+25
Sta. 13+25
Sta. 15+00
Sta. 9+50 Lt. 531.8
Sta. 2+60 Lt. 500.00
Sta. 9+50 Rt. 500.00
Rail Hgt. 523.02
Rail Hgt. 522.94
Sta. 5+65
PC 5+65.0
PT 5+18.3
PC 3+500
Curve #1
Curve #2
Curve #3
Rt. 4 Fair Haven
Rt. 4 Castleton
Rt. 22A
Rt. 22A
Rt. 22A