




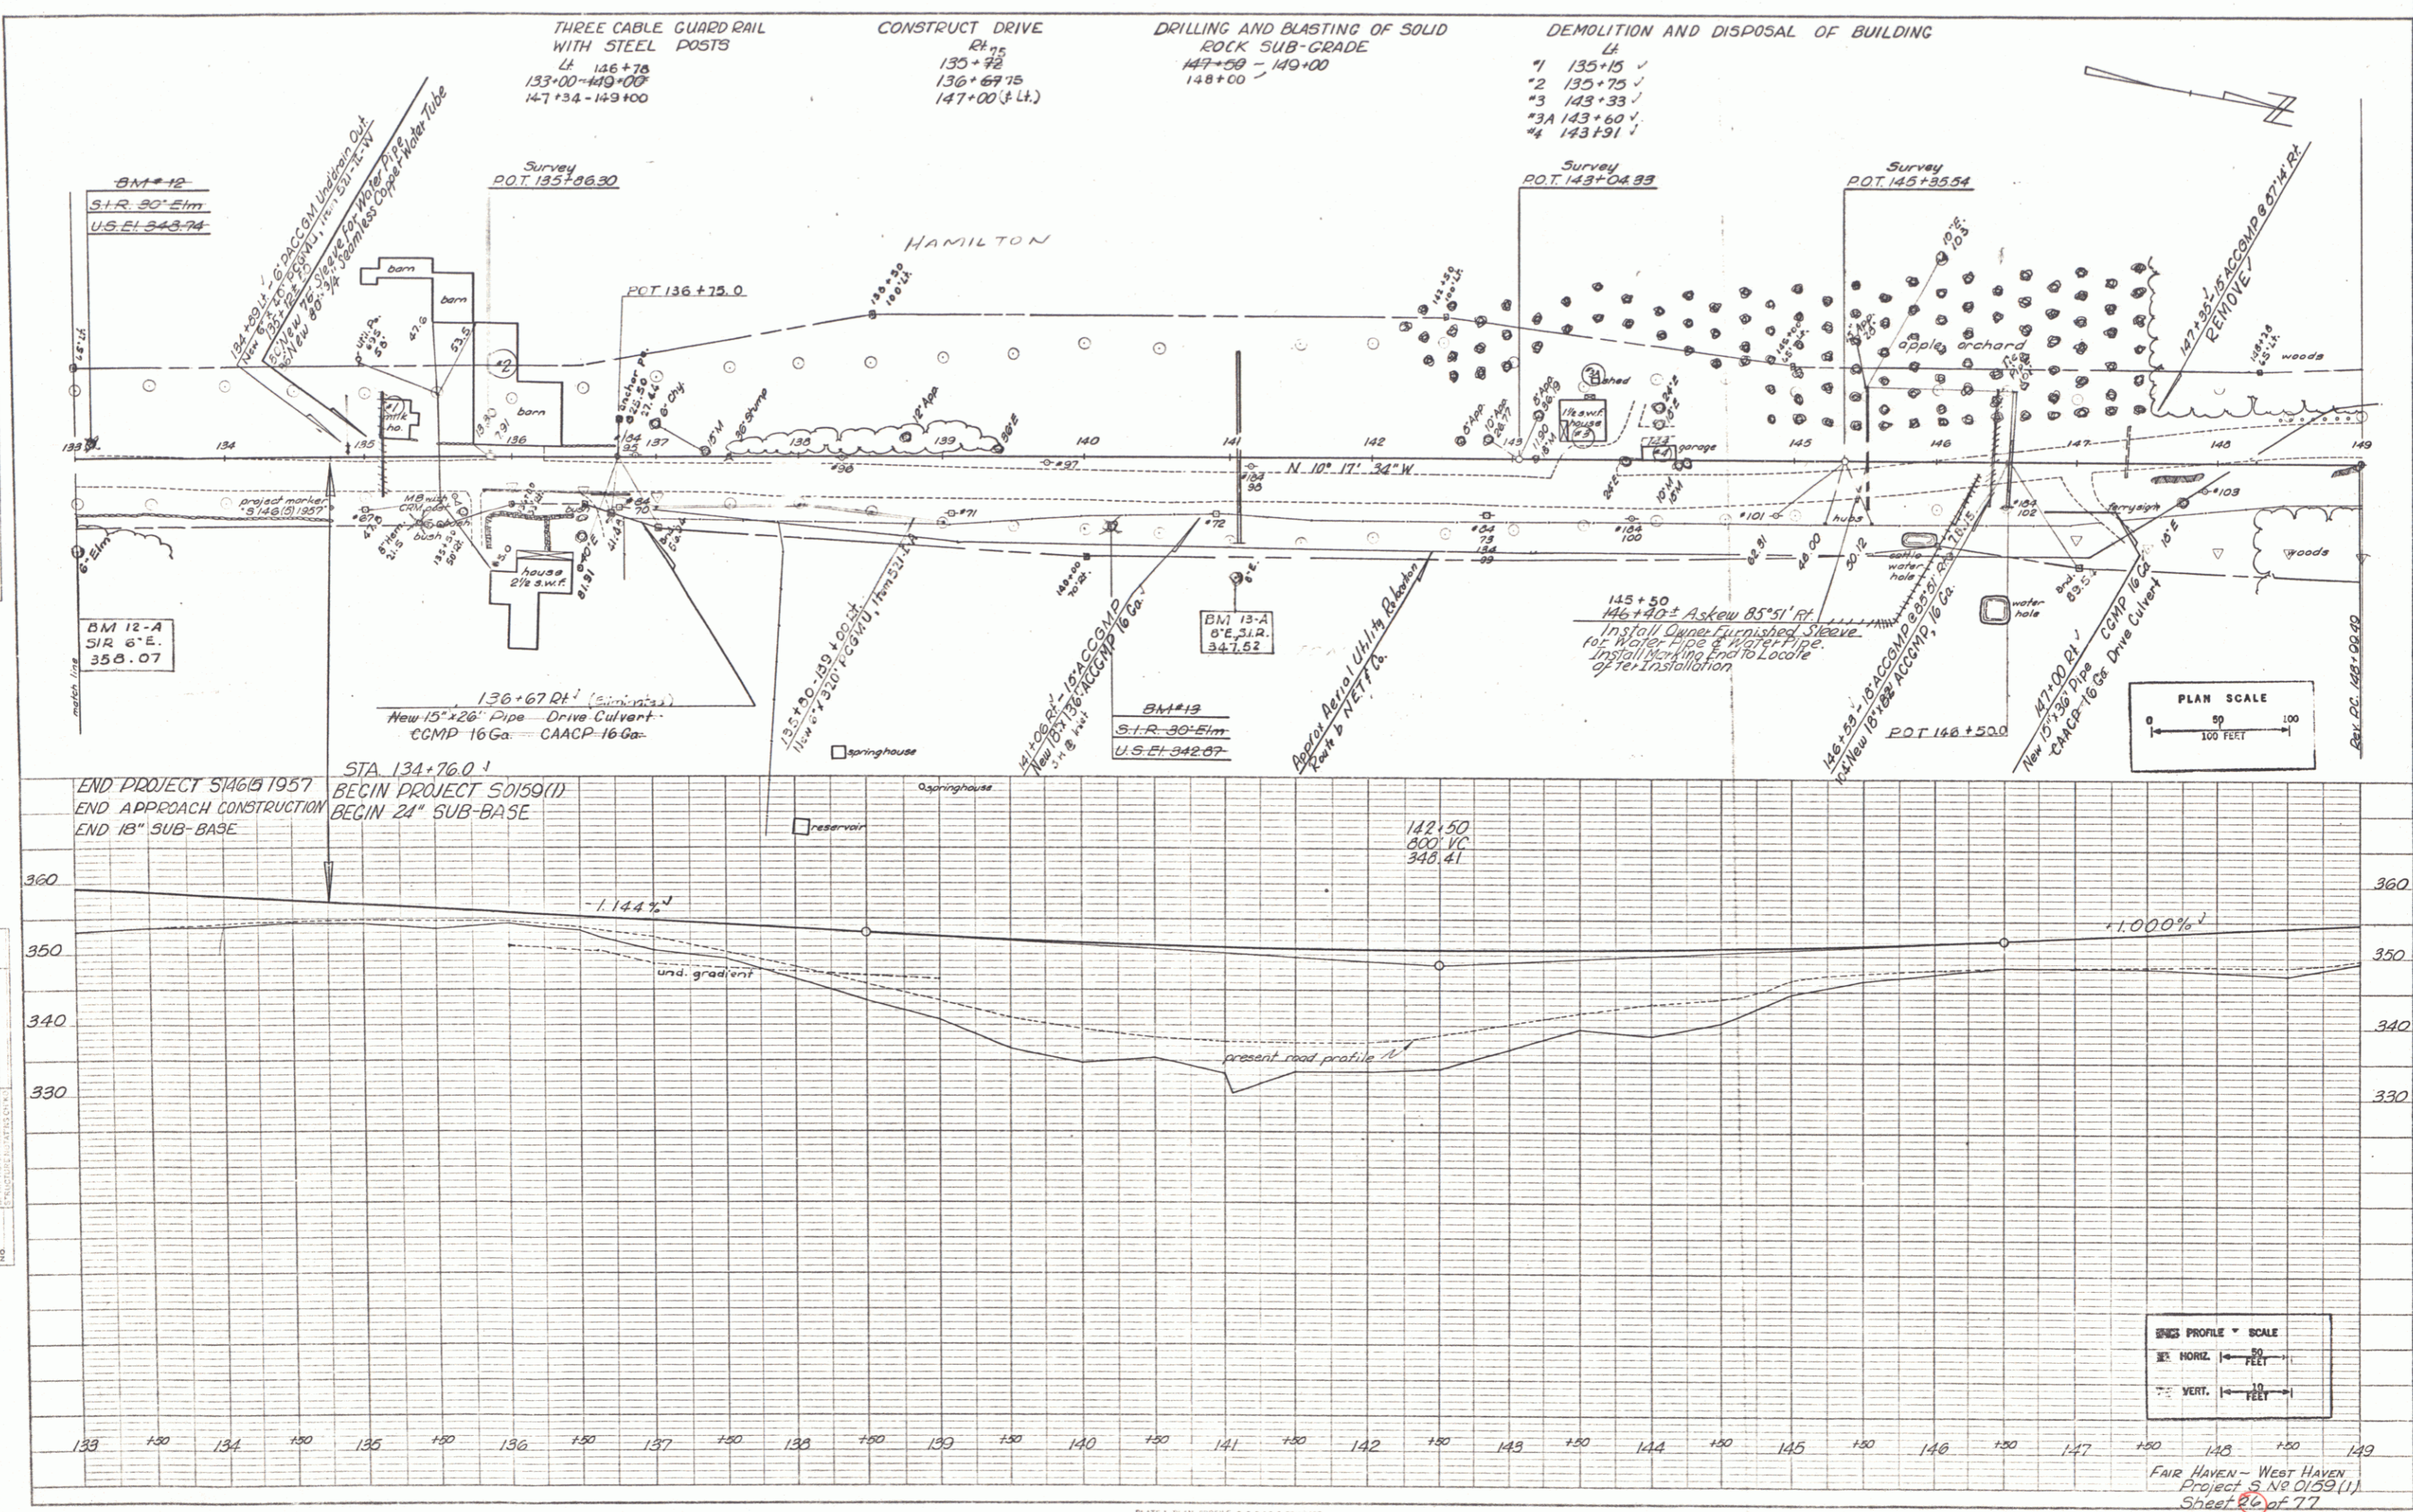

PLAN SCALE
 0 50 100
 FEET

PROFILE SCALE
 1" = 10'
 1" = 100'

FAIR HAVEN - WEST HAVEN
 Project S. No. 0159(1)
 Sheet 20 of 77


2
 3