

PLAN


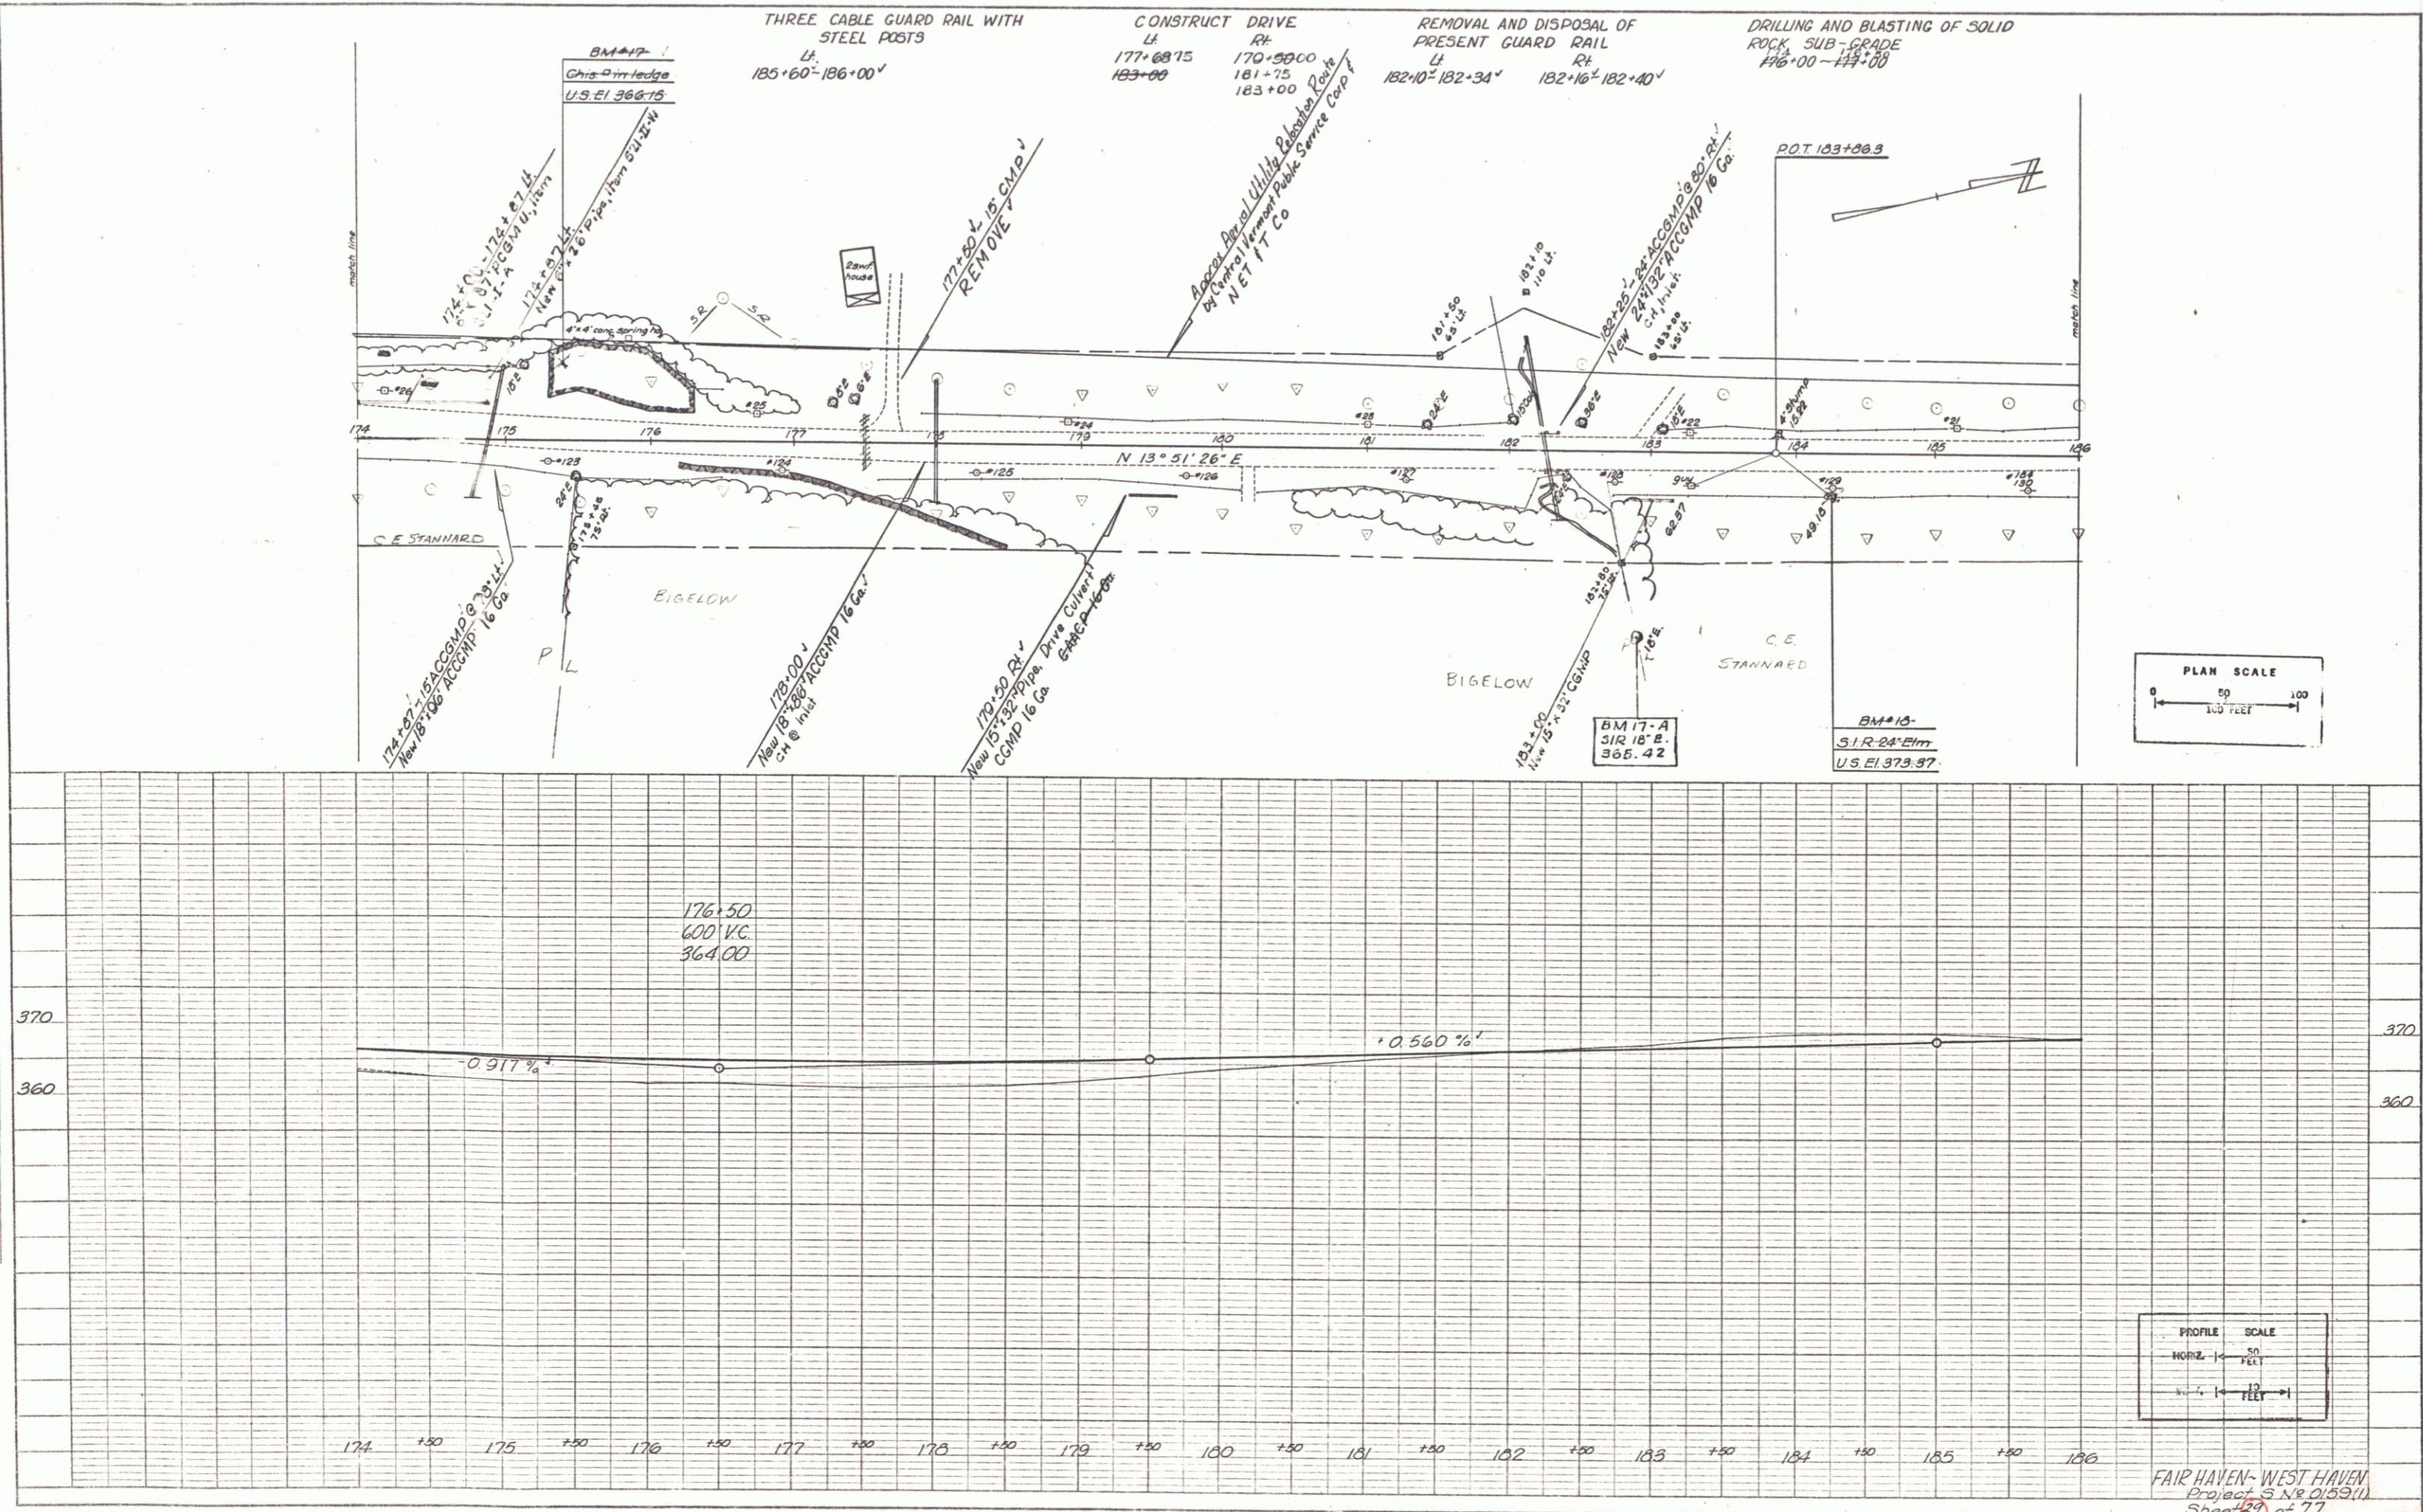


