THREE CABLE GUARD RAIL
WITH STEEL POSTS
Lt
234+00-237+08

CONSTRUCT DRIVE:
Lt APPROACH STA 240+00
Rt APPROACH STA. 240+65

DRILLING AND BLASTING OF
SOLID ROCK SUB-GRADE
234+00~235+00

TREATED TIMBER CURB
(PAVED SHOULDER FULL WIDTH
Lt
234+00~236+06

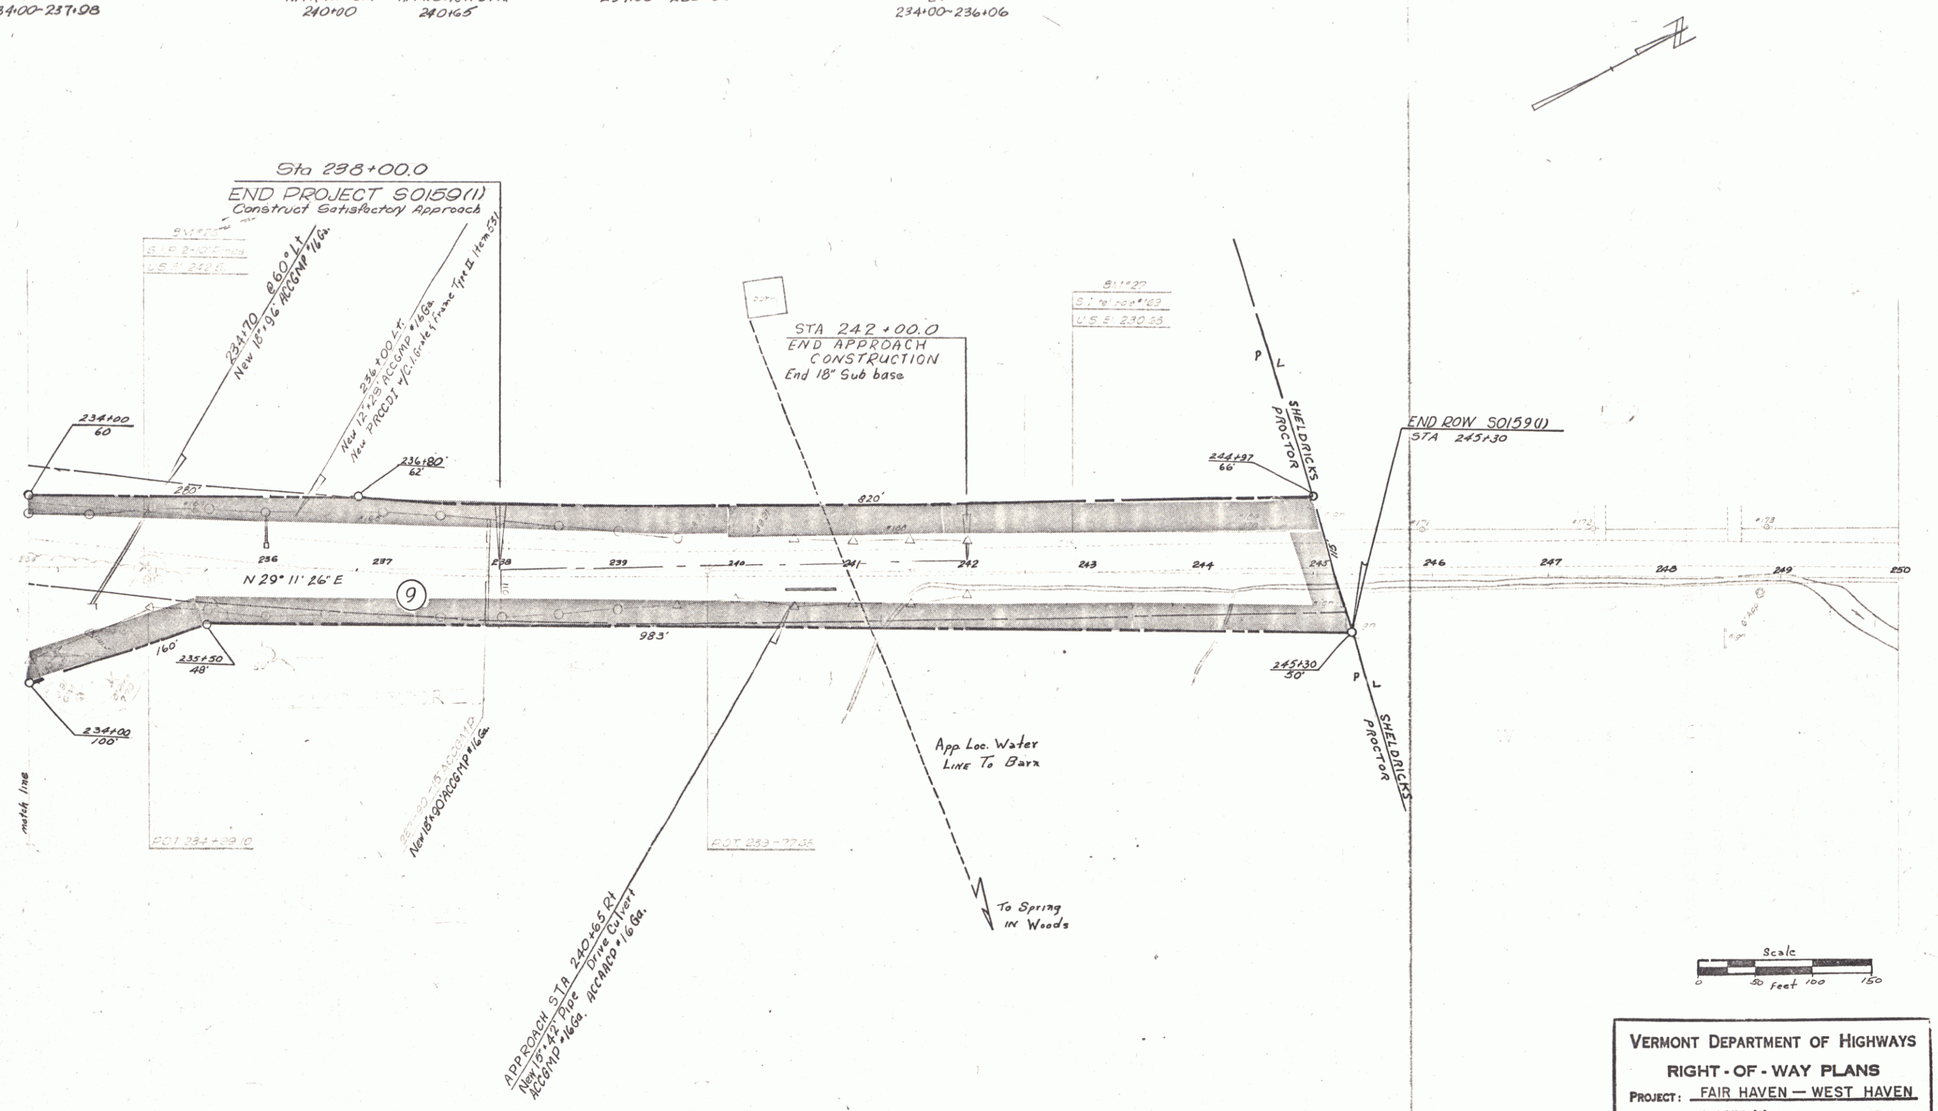

VERMONT DEPARTMENT OF HIGHWAYS
RIGHT-OF-WAY PLANS
PROJECT: FAIR HAVEN — WEST HAVEN
No. S 0159 (1)
SHEET 18 OF 18