NBS 146 1938 15 61

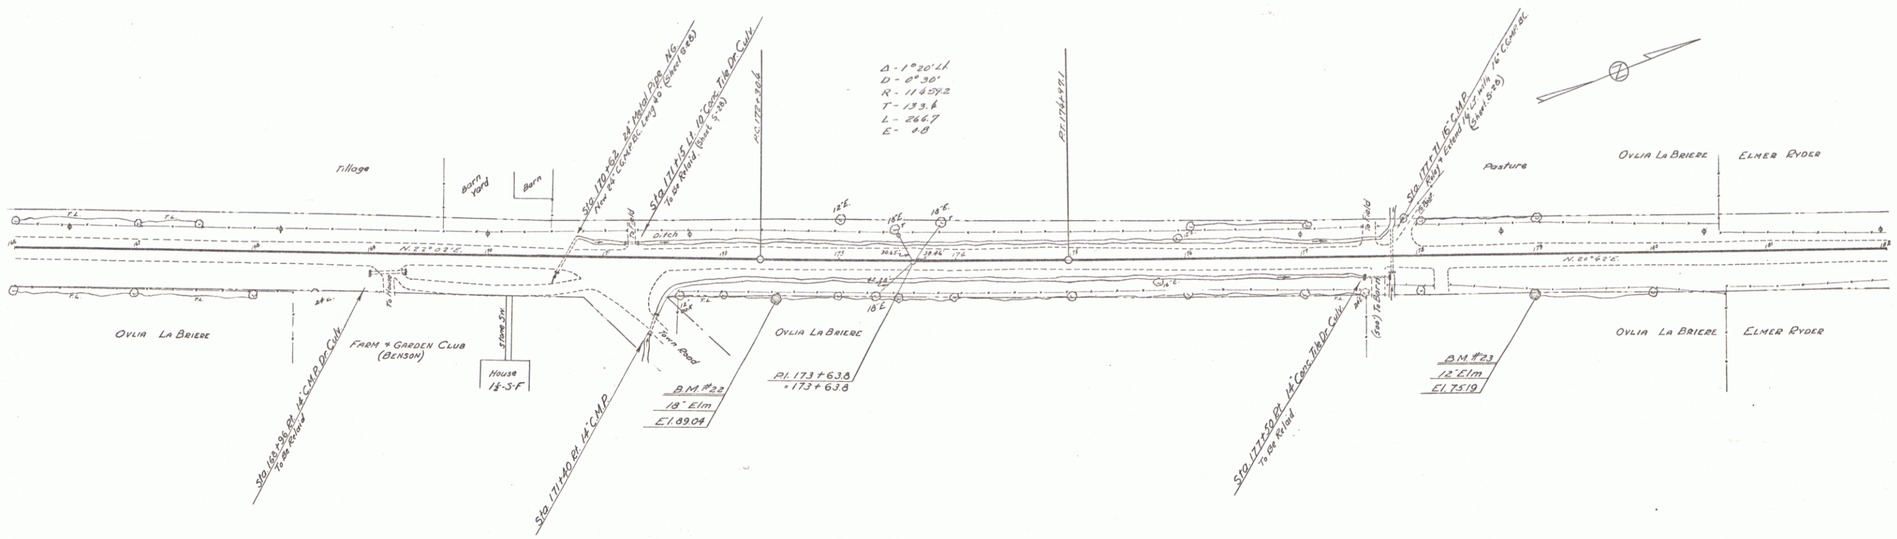

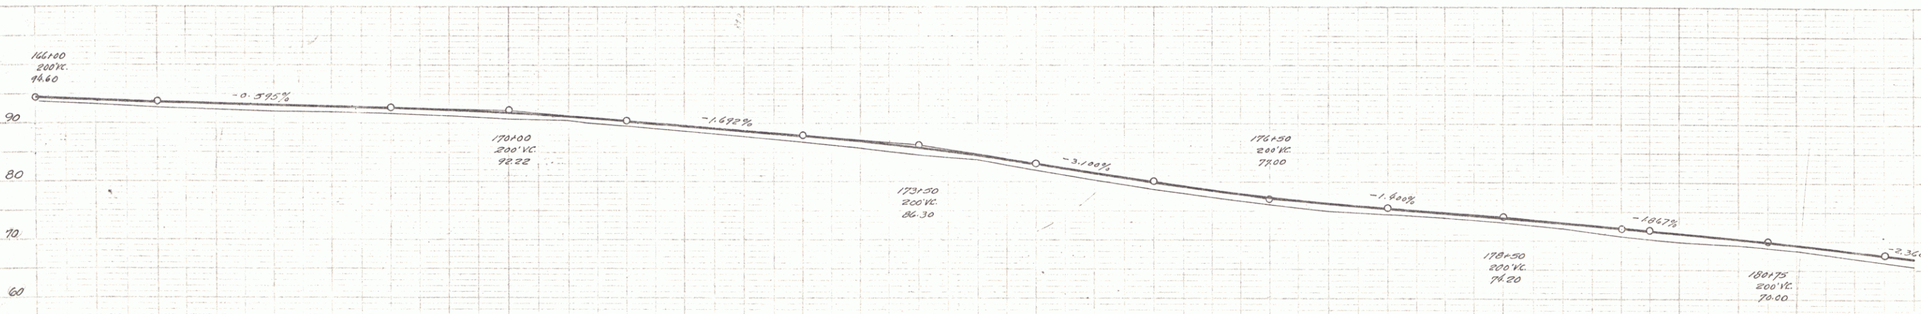

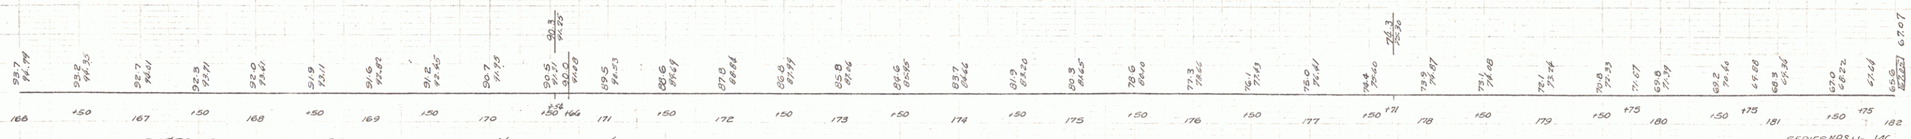

B.M. #22 Spike in Root of 18" Elm 28 Ft. Rt. Sta. 172+66 Elev. 89.04
B.M. #23 " " " 12" Elm 29 Ft. Rt. Sta. 178+98 Elev. 75.19

SERIES NBS No. 146
Sheet 15 of 61

15