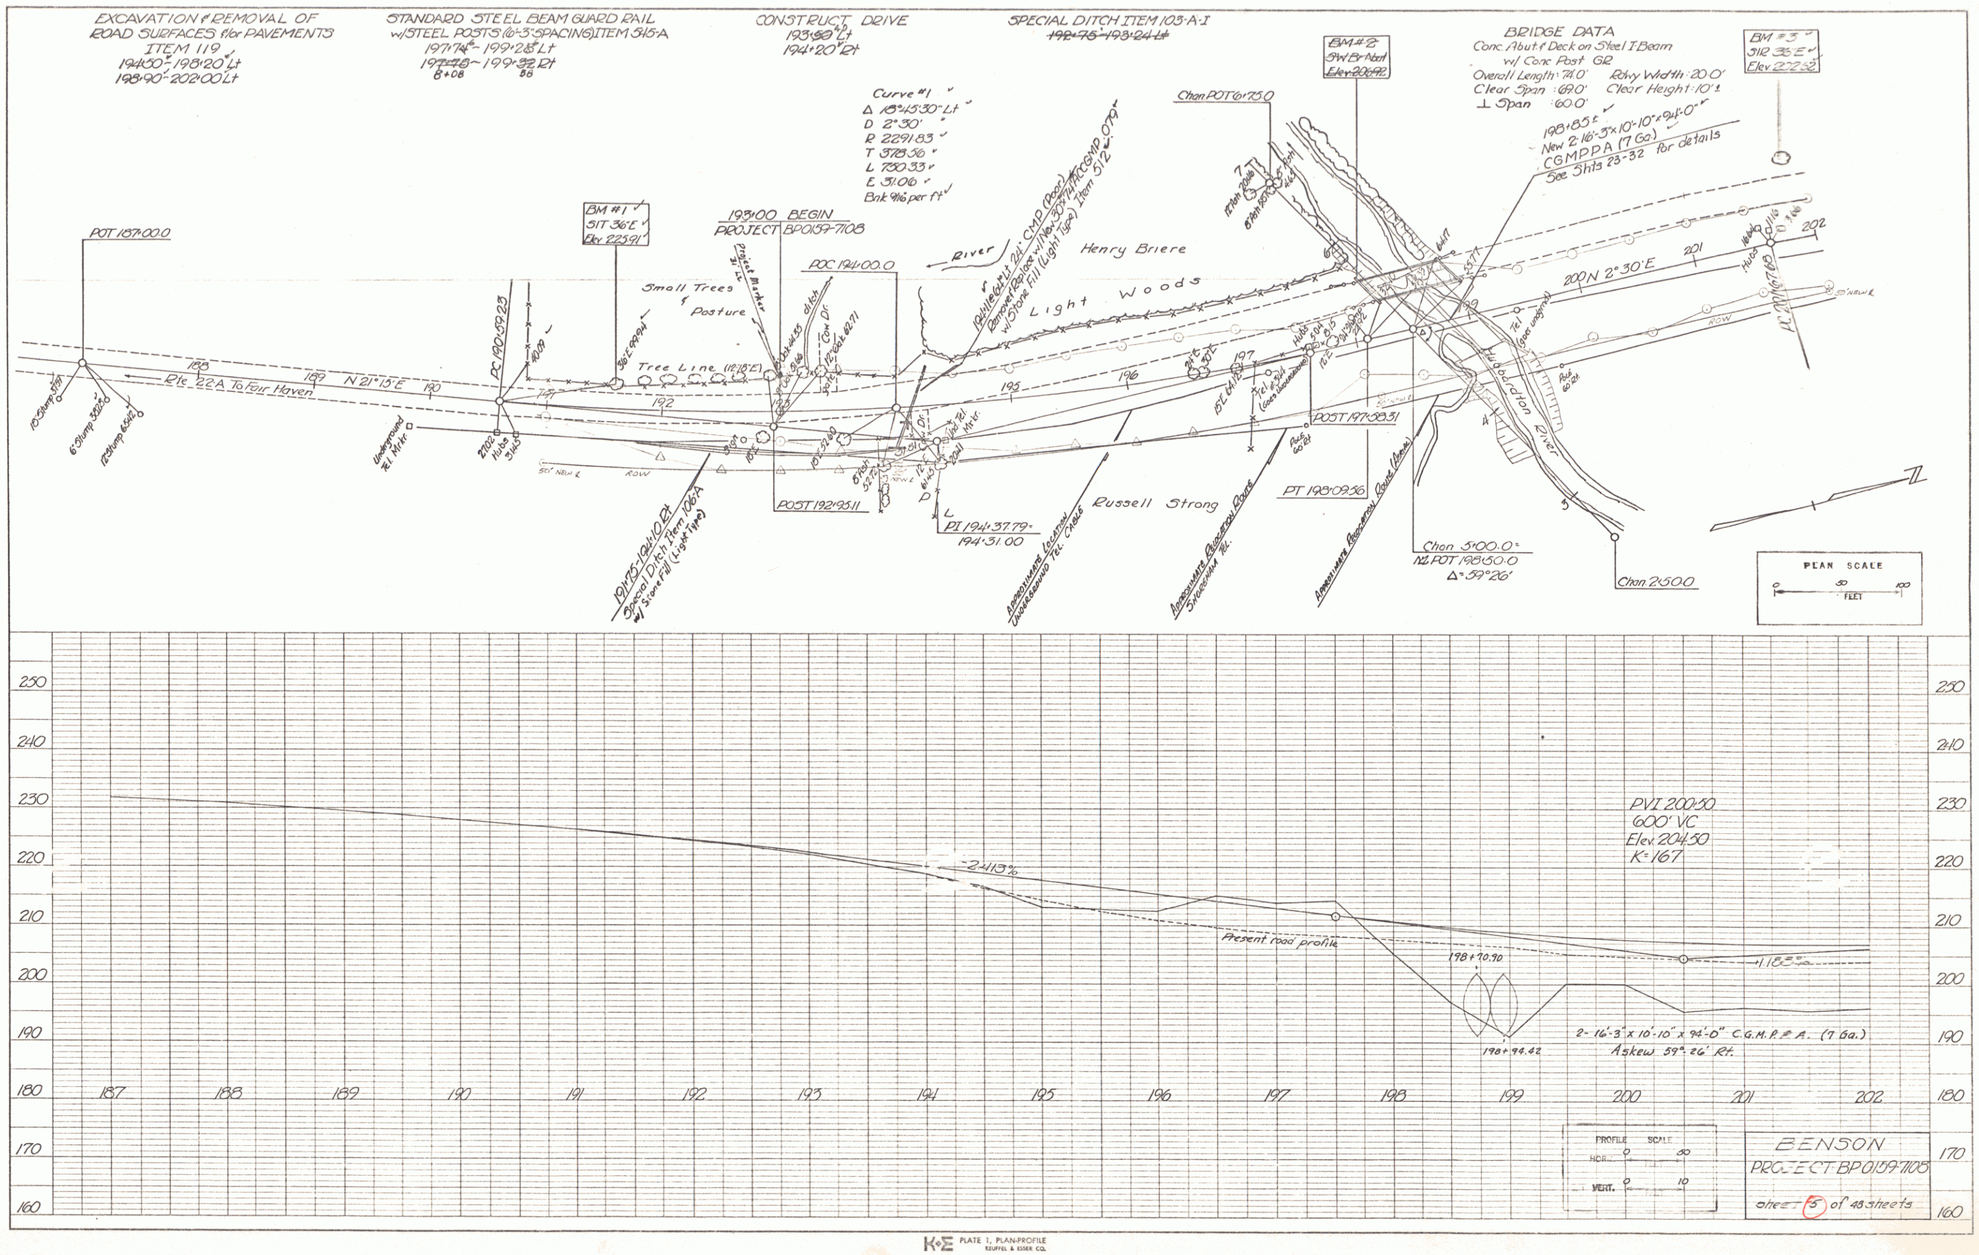

PLAN — SURVEYED: Smith; PLOTTED: Sherman; ALIGNMENT CHECKED: RT. OF WAY CHECKED: NOTE BOOK: NO.

PROFILE — SURVEYED: PLOTTED: ALIGNMENT CHECKED: GRADES NOTED: STRUCTURE NOTATIONS CHKD: NOTE BOOK: NO.

K+E PLATE 1, PLAN-PROFILE KEUFFEL & ESSER CO.

46 7012 IMPERIAL™ TRACING CLOTH