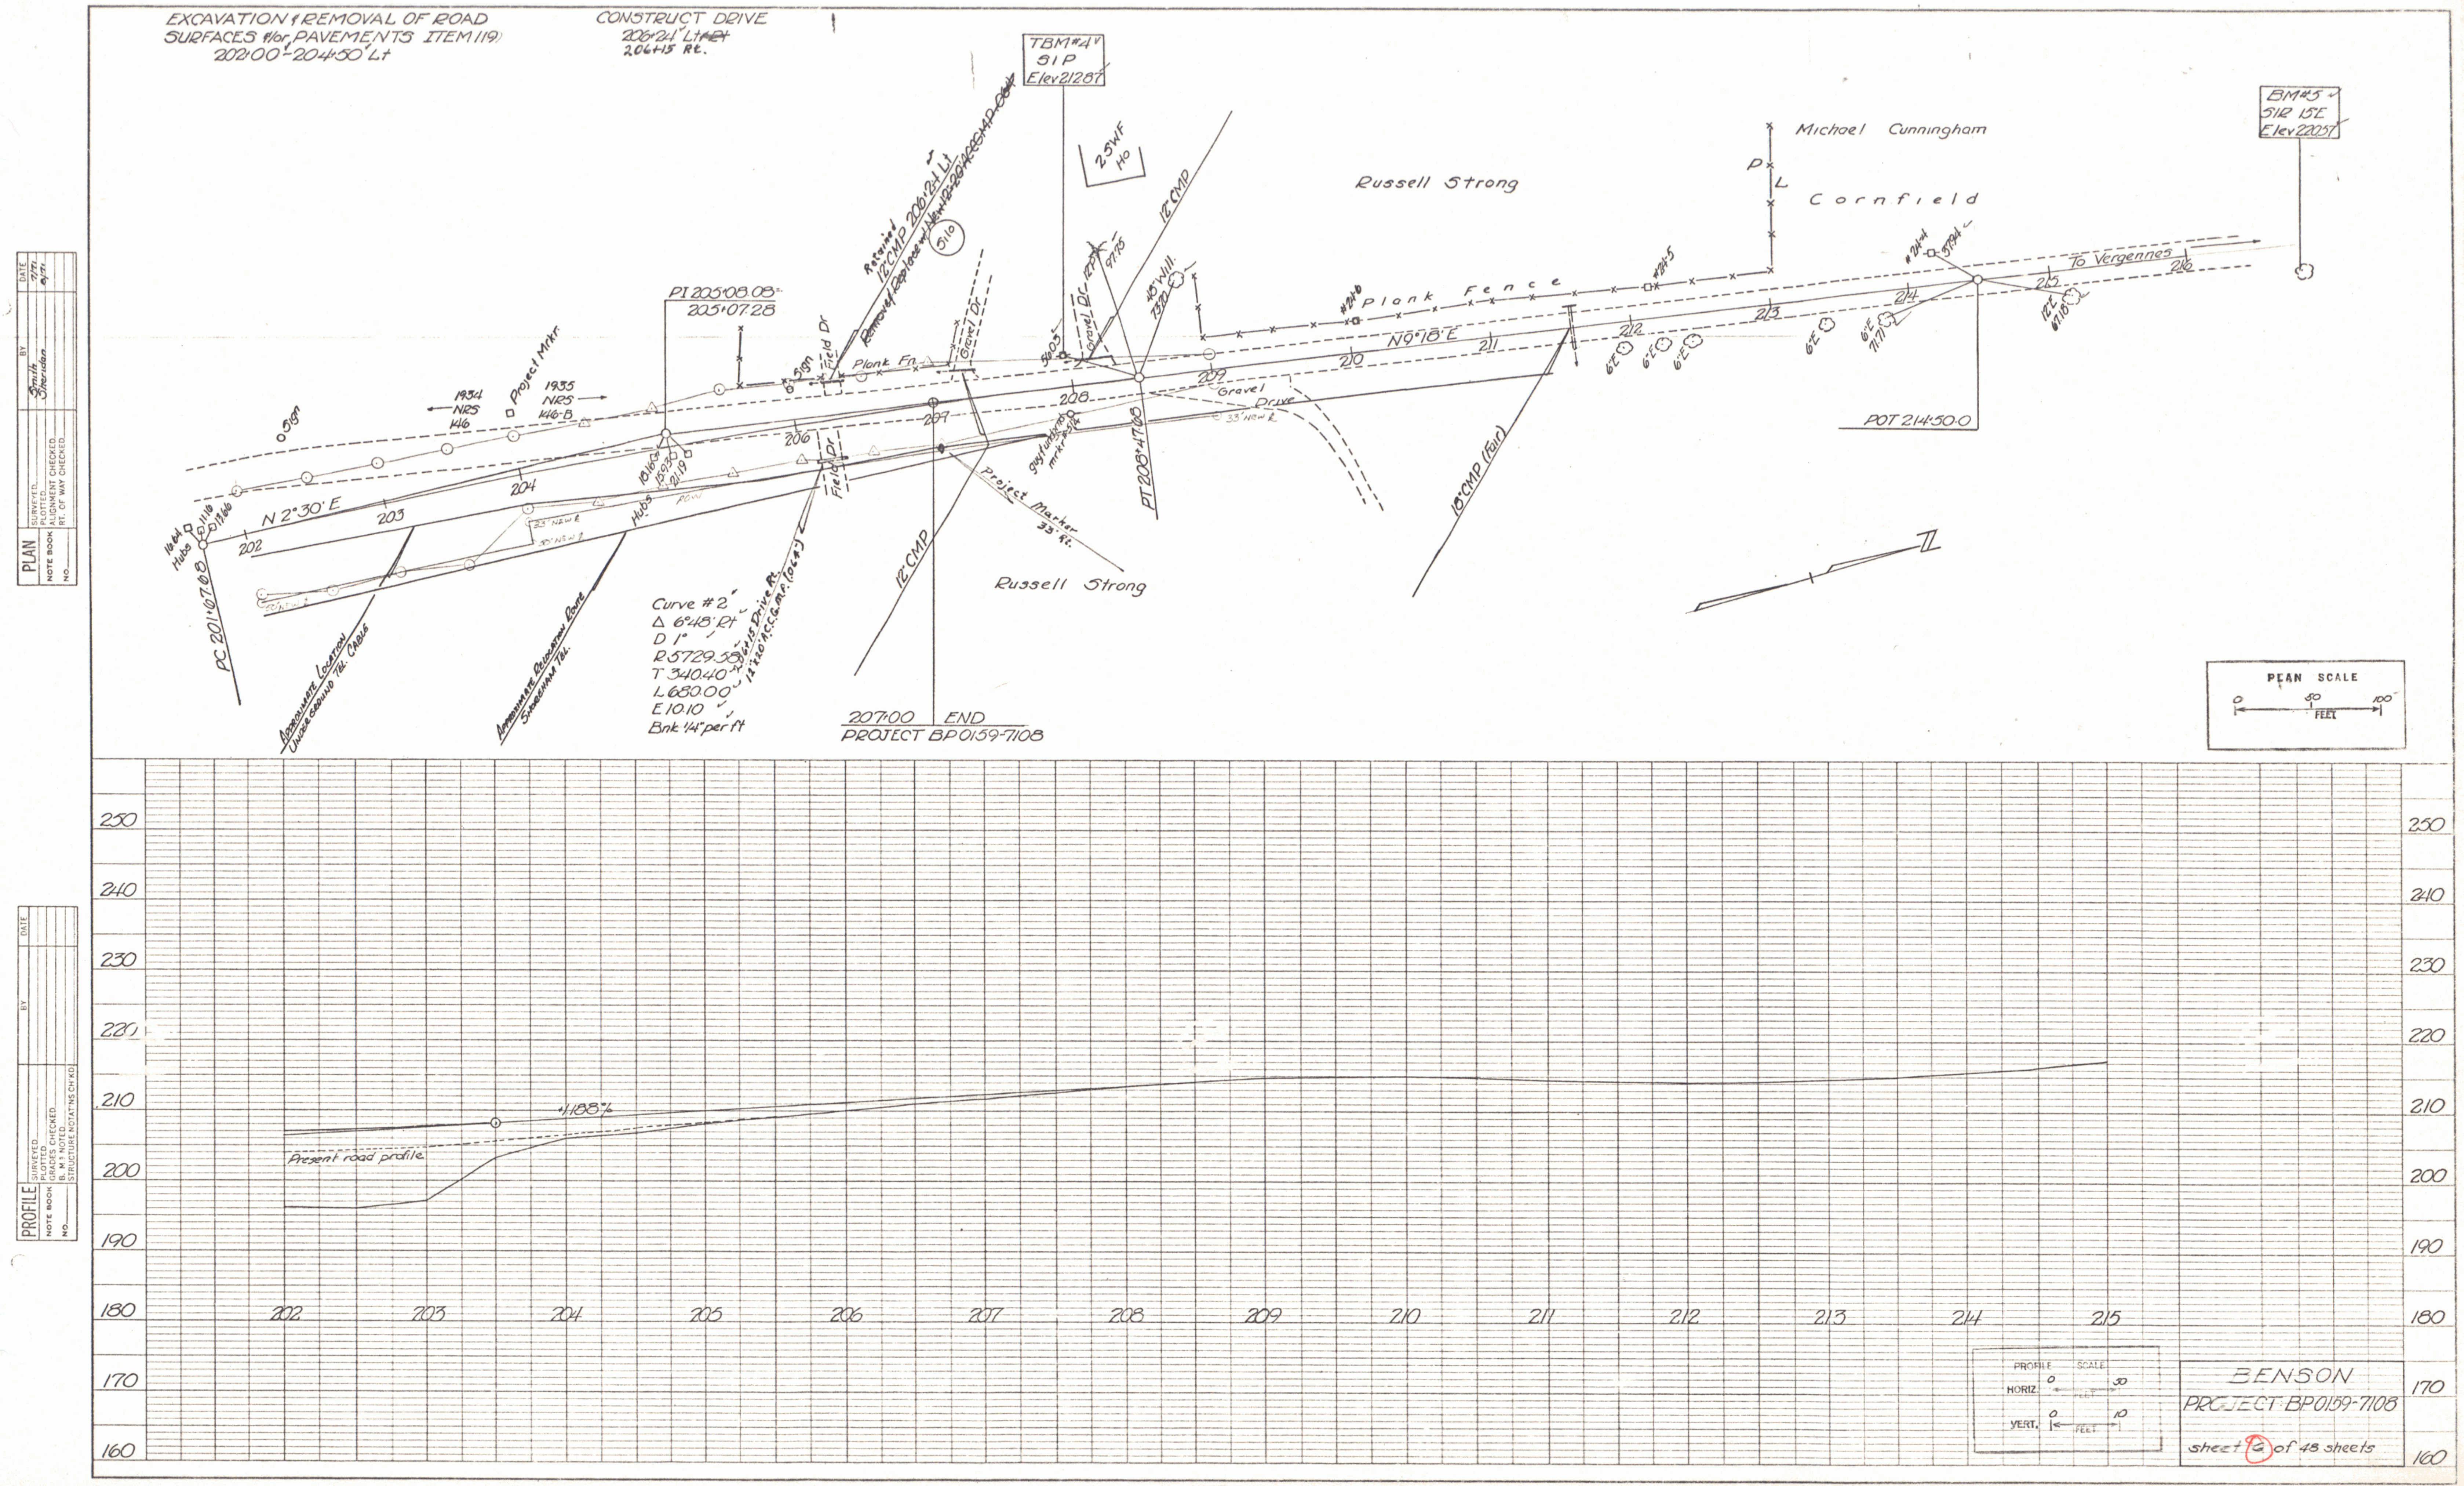
EXCAVATION & REMOVAL OF ROAD SURFACES &/or PAVEMENTS ITEM (119) 202+00 - 204+50 Lt
CONSTRUCT DRIVE ~~206+21 Lt Rt~~ 206+15 Rt.
TBM #4 SIP Elev 212.87
BM #5 SIR 15"E Elev 220.57
Michael Cunningham
Cornfield
Russell Strong
Plank Fence
N 9°18' E
N 2°30' E
To Vergennes
PI 205+08.08 205+07.28
PC 201+67.68
PT 208+47.68
POT 214+50.0
Retained 12" CMP 206+21 Lt
Remove & Replace w/ New 12" x 20' ACCMP 0.64
5.10
25 WF Ho
12" CMP
18" CMP (Fair)
48" Will. 73.70
Field Dr
Gravel Dr
Gravel Drive
Plank Fn.
Sign
Project Mrkr.
1934 NRS 146
1935 NRS 146-B
Hubs 16.64 11.16 13.66
Hubs 18.16 15.93 21.19
33' New ℄
30' New ℄
ROW
guy & undgnd mrkr #514
Project Marker 33' Rt.
206+15 Drive Rt. 12" x 20' A.C.C.M.P. (0.64)
Approximate Location Underground Tel. Cable
Approximate Relocation Route Shoreham Tel.
Curve #2
Δ 6°48' Rt
D 1°
R 5729.58
T 340.40
L 680.00
E 10.10
Bnk 1/4" per ft
207+00 END PROJECT BP0159-7108
#24-4 37.94
#24-5
#24-6
6"E
6"E 71.71
12"E 67.18
202
203
204
205
206
207
208
209
210
211
212
213
214
215
216
PLAN SCALE 0 50 100 FEET
+1.88%
Present road profile
250
240
230
220
210
200
190
180
170
160
PROFILE SCALE HORIZ. 0 50 FEET VERT. 0 10 FEET
PLAN NOTE BOOK NO. SURVEYED PLOTTED ALIGNMENT CHECKED RT. OF WAY CHECKED
BY Smith Sheridan
DATE 7/71 8/71
PROFILE NOTE BOOK NO. SURVEYED PLOTTED GRADES CHECKED B. M.S NOTED STRUCTURE NOTAT'NS CH'KD
BY
DATE

BENSON
PROJECT BP0159-7108
sheet 2 of 48 sheets

K+E PLATE 1, PLAN-PROFILE
KEUFFEL & ESSER CO.
48 7012 IMPERIAL™ TRACING CLOTH 28406