		N.R.S.			
5		146-8 (1939)	1935	5	26

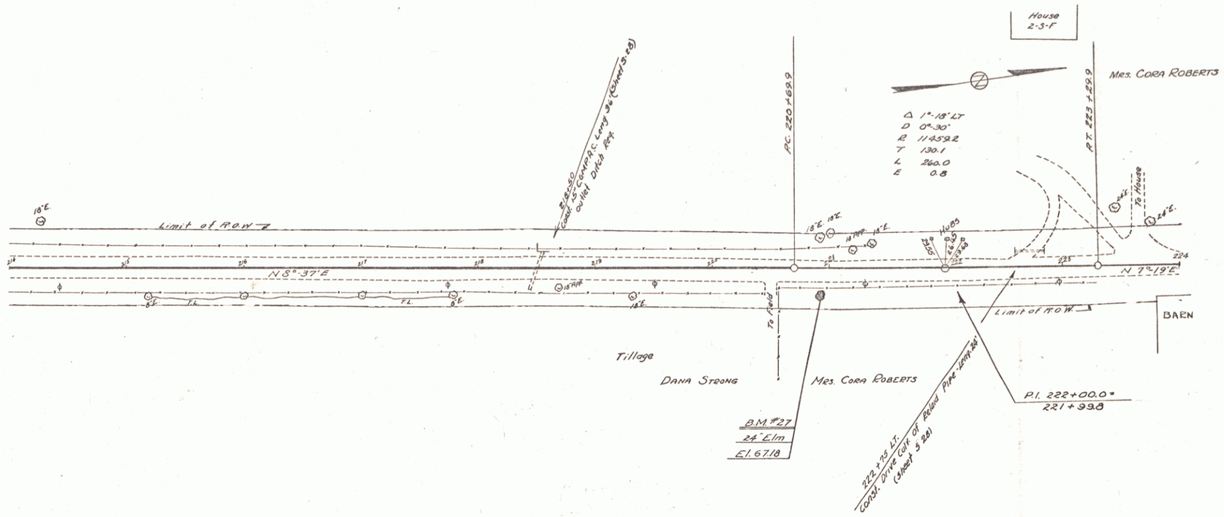

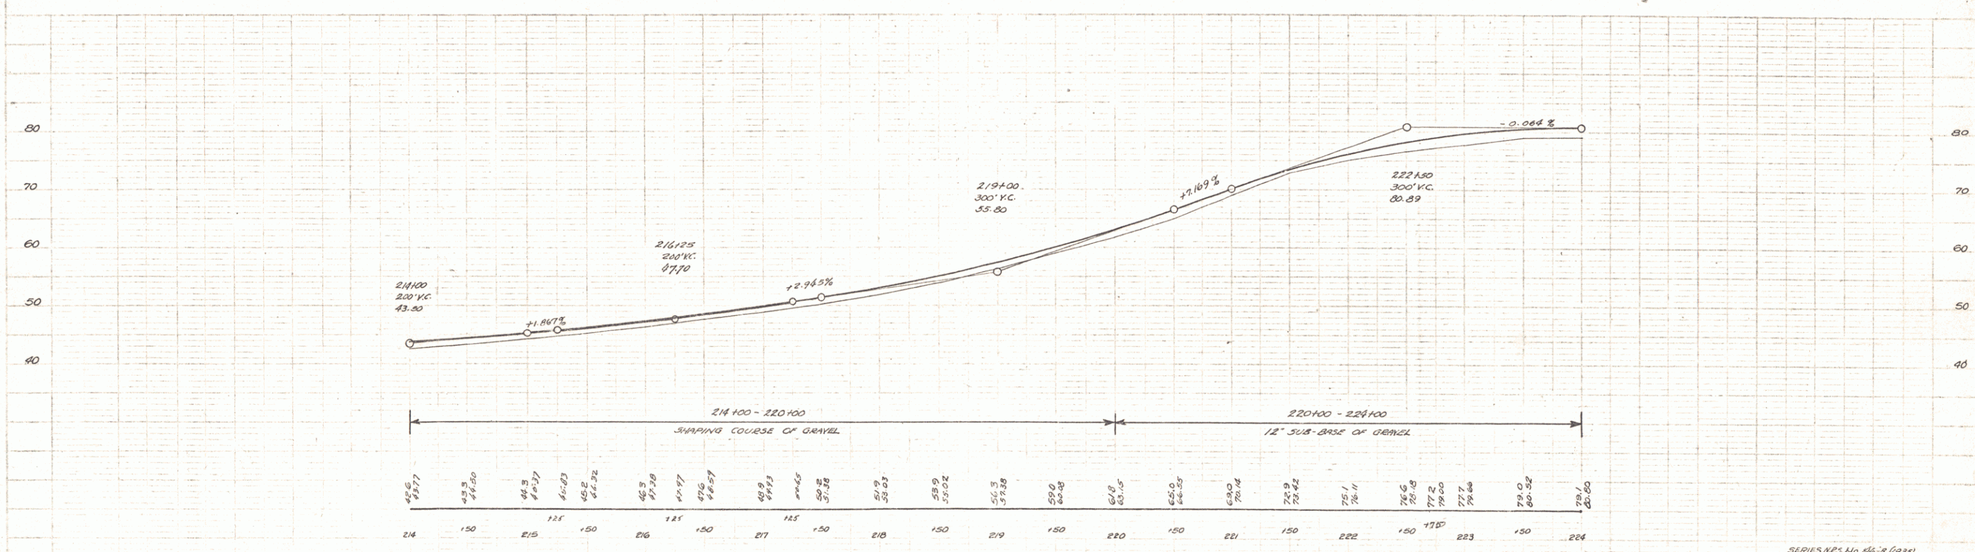

B.M. #27 SPIKE IN ROOT OF 24" ELM 19 FT. RT. STA. 220+91 ELEV. 67.18

SERIES N.R.S. No. 146-8 (1939)
Sheet 5 of 26

3