DIST. NO.	STATE	PROJ. NO.	YEAR	NO.	SHEET NO.
6	VT.	NRS 168 (1935)	1935	6	28

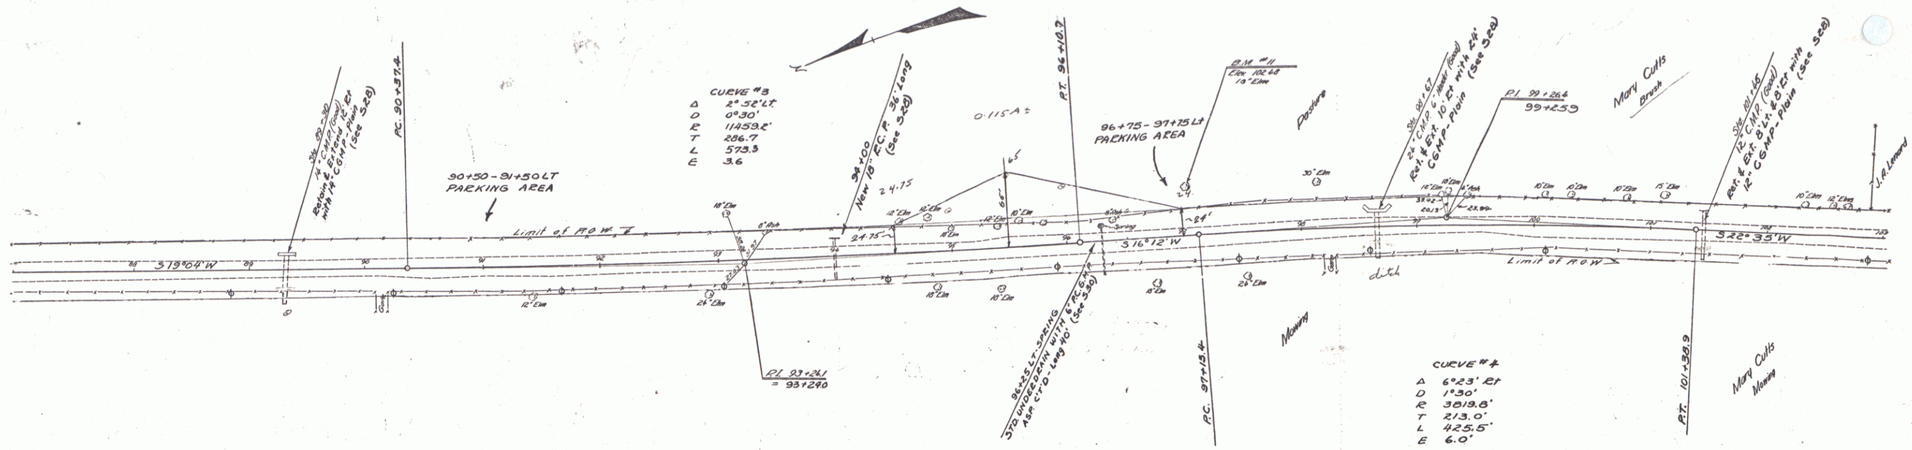

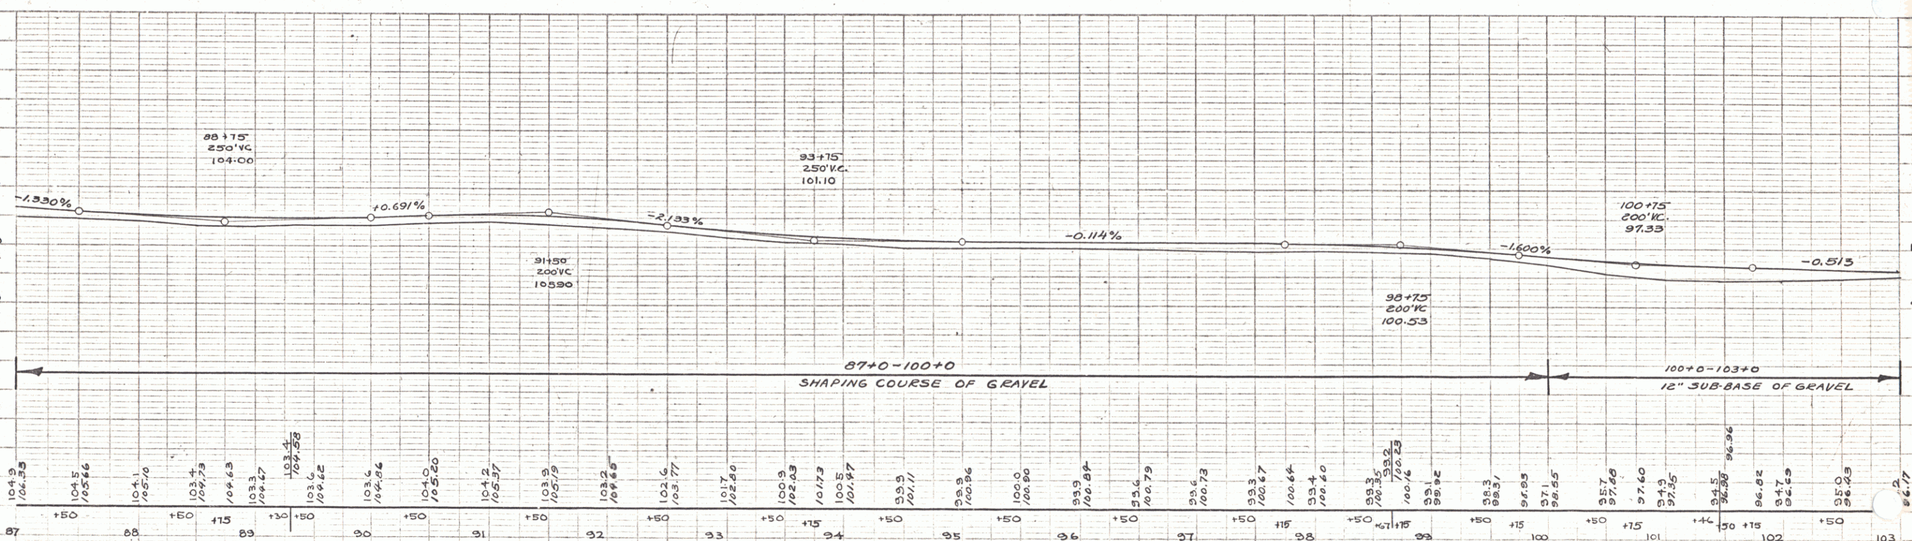

B.M. #11 SPIKE IN ROOT OF 18" ELM 39' LT. STA. 97+03 El. 102.48

SERIES NRS NO 168 (1935)
SHEET 6 OF 28

PLAN
PROJECT
NOTE BOOK
NO.
DRAWN
PLOTTED
ALIGNMENT CHECKED
PROFILE CHECKED

PROFILE
COMPUTED FARRINGTON 8/31/34
PLOTTED D. MACCINI
NOTE BOOK
NO.

PLATE 1 — PLAN-PROFILE © P.R.& A.E. STANDARD
KEUFFEL & ESSER CO., NEW YORK

4