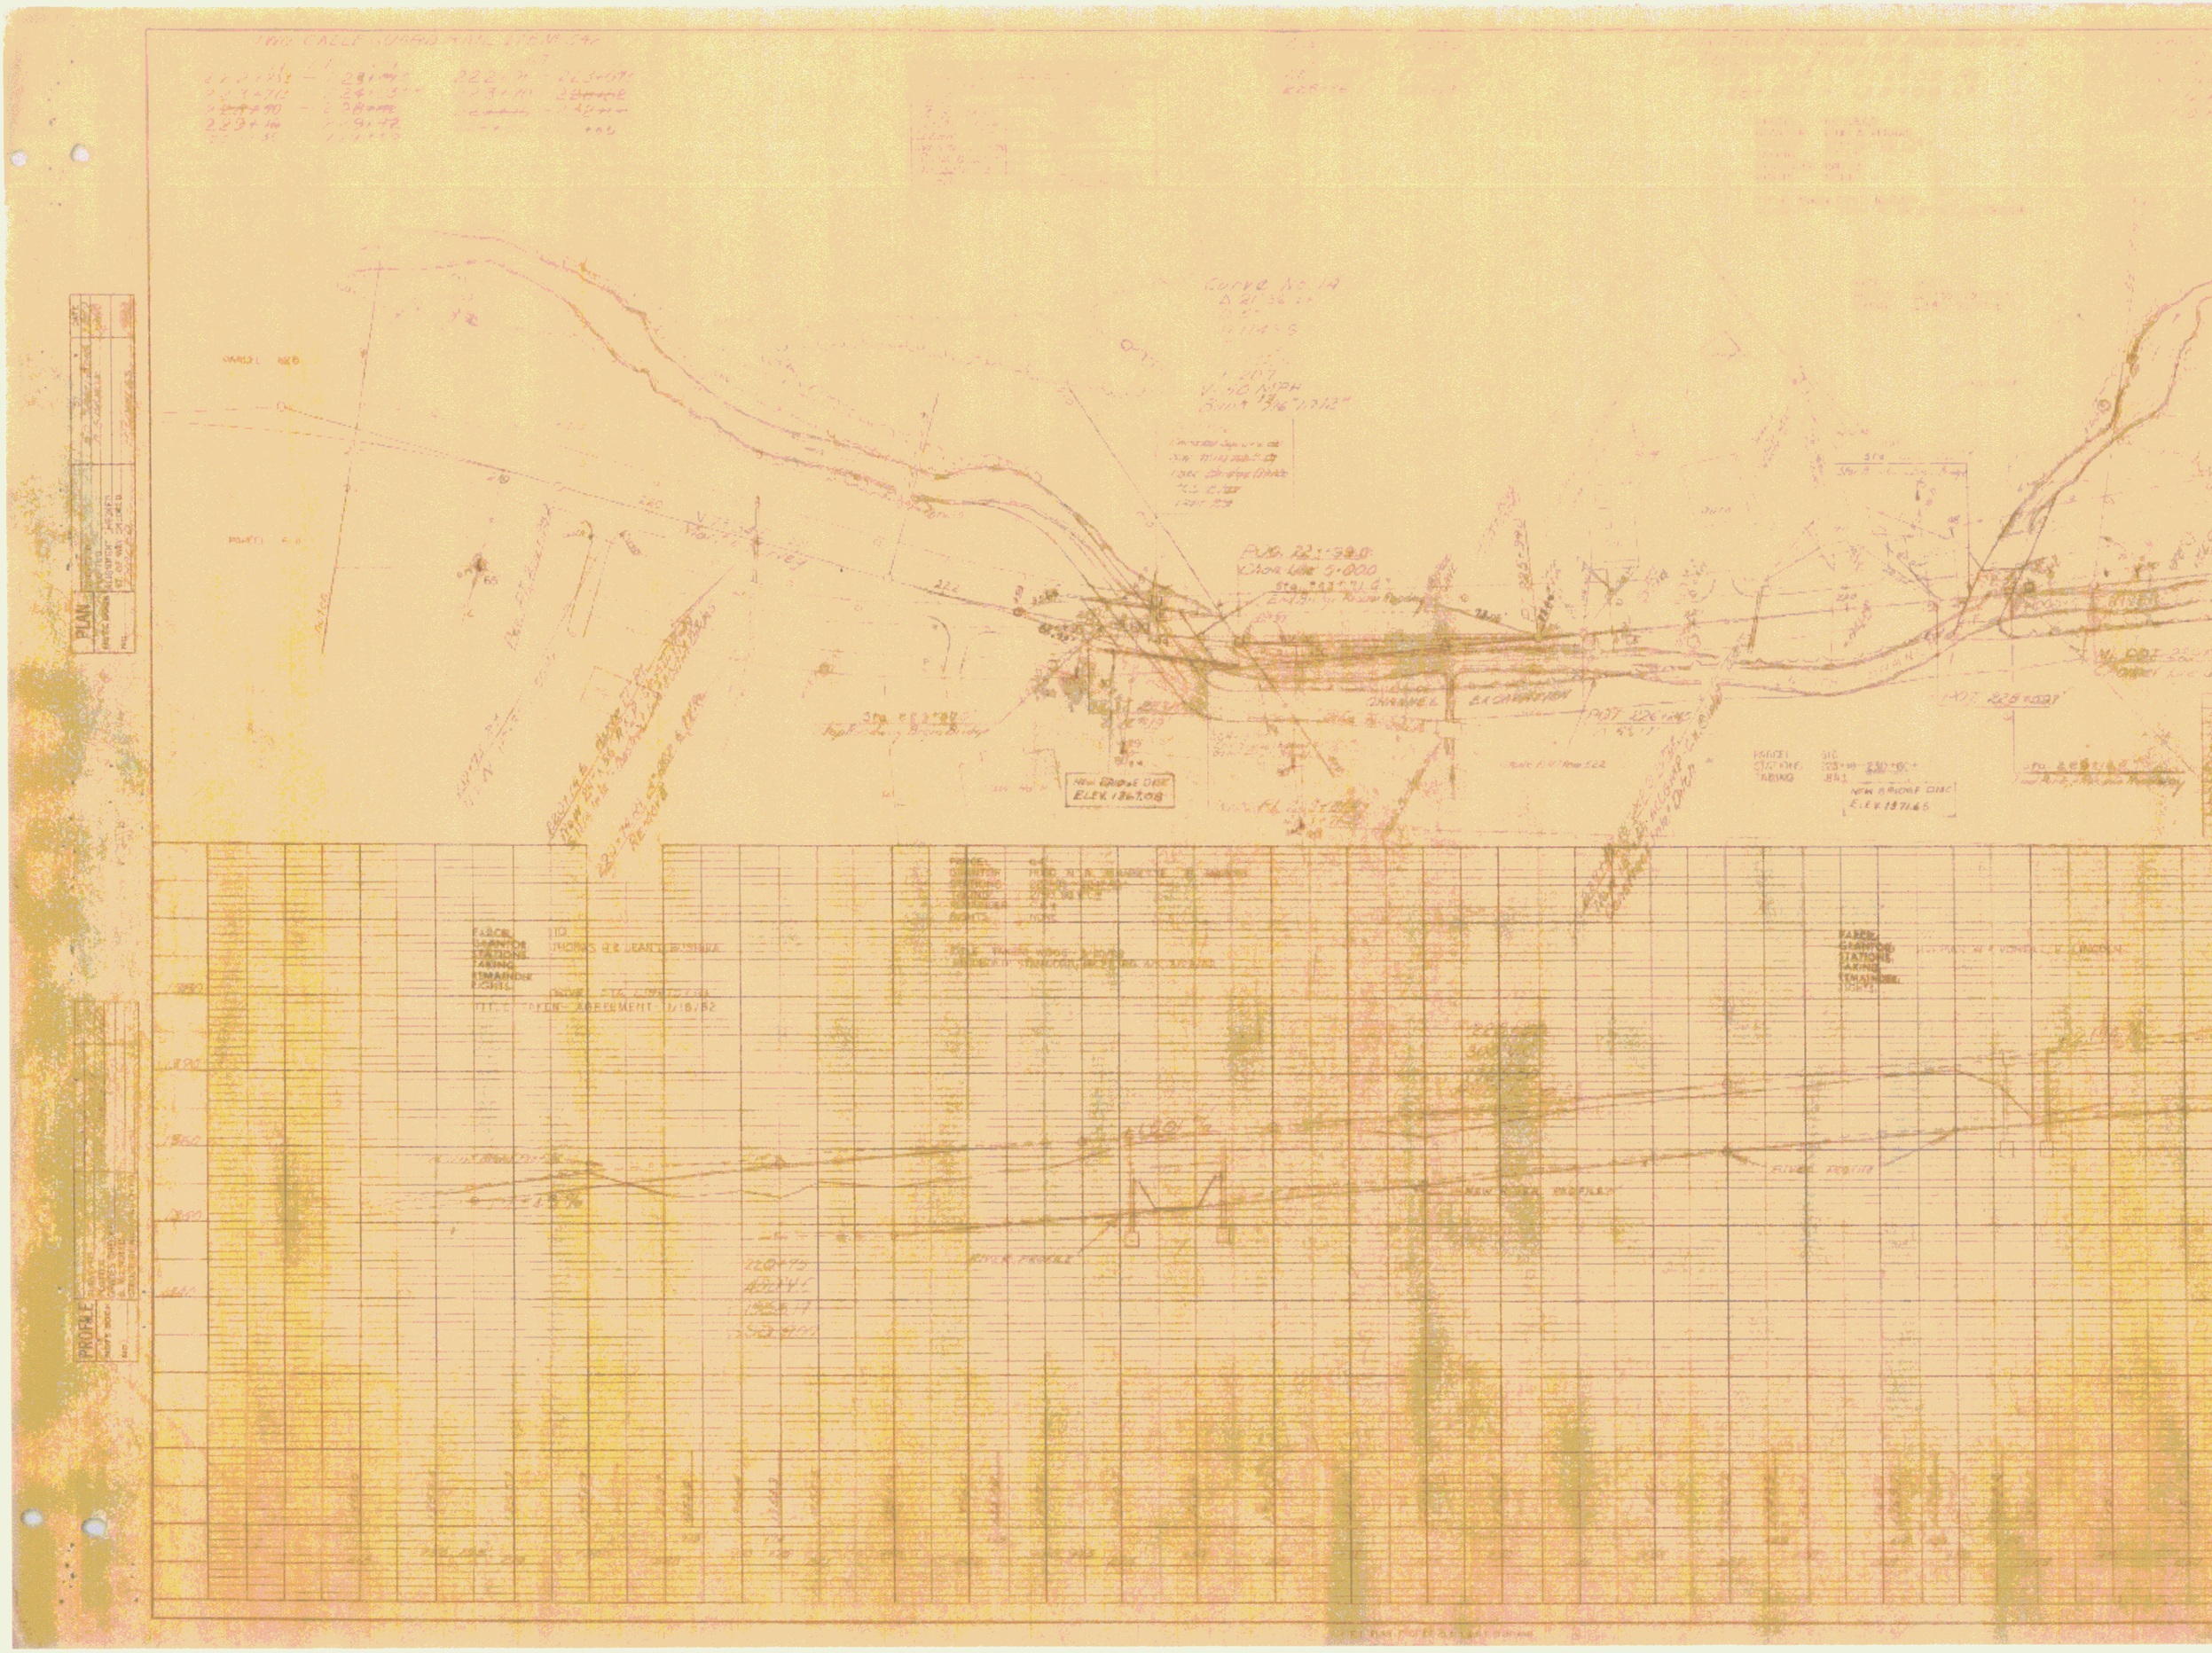
Curve No. 14
Pt. Sta. 122+39.0
Chord Line 5+800
EXCAVATION
NEW BRIDGE DISC
ELEV. 136.7.08
NEW BRIDGE DISC
ELEV. 137.65
PLAN
PROFILE
EXISTING PROFILE
NEW RIVER PROFILE
RIVER PROFILE