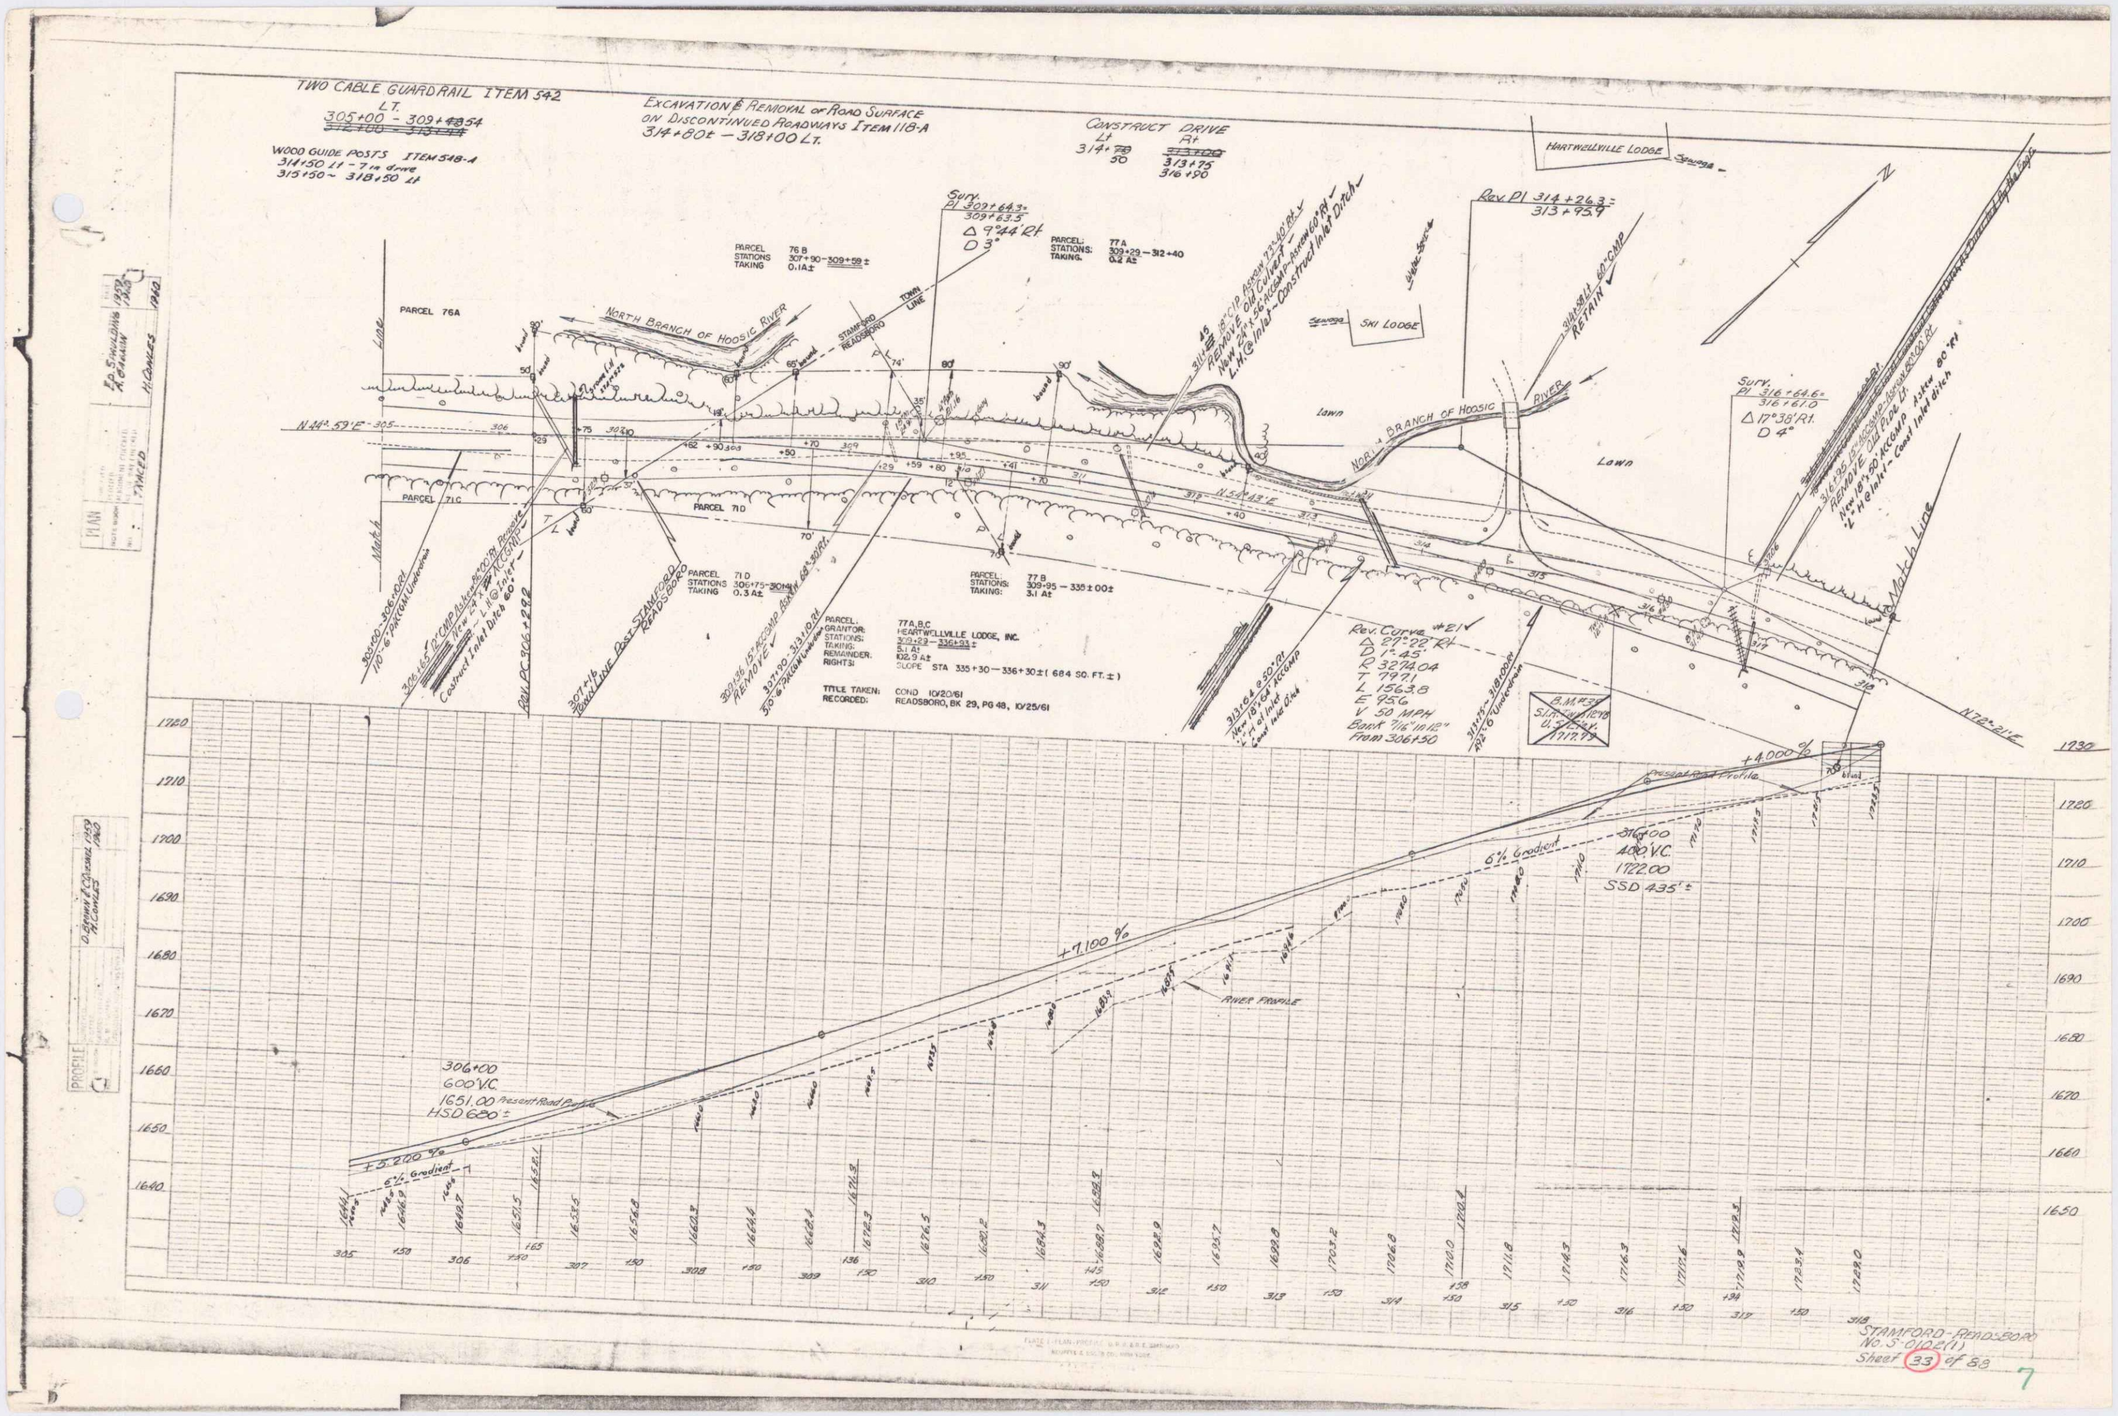
TWO CABLE GUARDRAIL ITEM 542
LT.
305+00 - 309+48.54
WOOD GUIDE POSTS ITEM 548-A
314+50 Lt - 7 in drive
315+50 - 318+50 Lt
EXCAVATION & REMOVAL OF ROAD SURFACE ON DISCONTINUED ROADWAYS ITEM 118-A
314+80± - 318+00 Lt.
CONSTRUCT DRIVE
Lt
314+50
313+75
316+50
Rt
HARTWELLVILLE LODGE
Surv. PI 309+63.3
309+63.5
Δ 9°44' Rt
D 3°
PARCEL 76 B
STATIONS 307+90 - 309+58±
TAKING 0.1A±
PARCEL: 77 A
STATIONS: 309+29 - 312+40
TAKING. 0.2 A±
PARCEL 76A
NORTH BRANCH OF HOOSIC RIVER
TOWN LINE
STAMFORD READSBORO
SKI LODGE
Lawn
Rev. PI 314+26.3
313+95.9
RETAIN
Surv. PI 316+64.6
316+61.0
Δ 17°36' Rt.
D 4°
N 44°-59'E
PARCEL 71C
PARCEL 71D
PARCEL 71 D
STATIONS 306+75 - 309+00
TAKING 0.3 A±
PARCEL: 77 B
STATIONS: 309+95 - 335±00±
TAKING: 3.1 A±
PARCEL: 77A,B,C
GRANTOR: HEARTWELLVILLE LODGE, INC.
STATIONS: 309+29 - 336+95±
TAKING: 5.1 A±
REMAINDER: 102.9 A±
RIGHTS: SLOPE STA 335+30 - 336+30± (684 SQ. FT. ±)
TITLE TAKEN: COND 10/20/61
RECORDED: READSBORO, BK 29, PG 48, 10/25/61
Rev. Curve #E1
Δ 87°22' Rt
D 1°45'
R 3274.04
T 797.1
L 1563.8
E 95.6
V 50 MPH
Bank 7 1/2" in 12"
From 306+50
B.M. #39
Match Line
N 72°-21'E
+4.000%
Present Road Profile
6% Gradient
316+00
400' VC
1722.00
SSD 435'±
+7.100%
RIVER PROFILE
306+00
600' VC
1651.00 Present Road Profile
HSD 620±
+5.200%
6% Gradient
1720
1710
1700
1690
1680
1670
1660
1650
1640
STAMFORD-READSBORO
No. S-0102(1)
Sheet 33 of 58
7