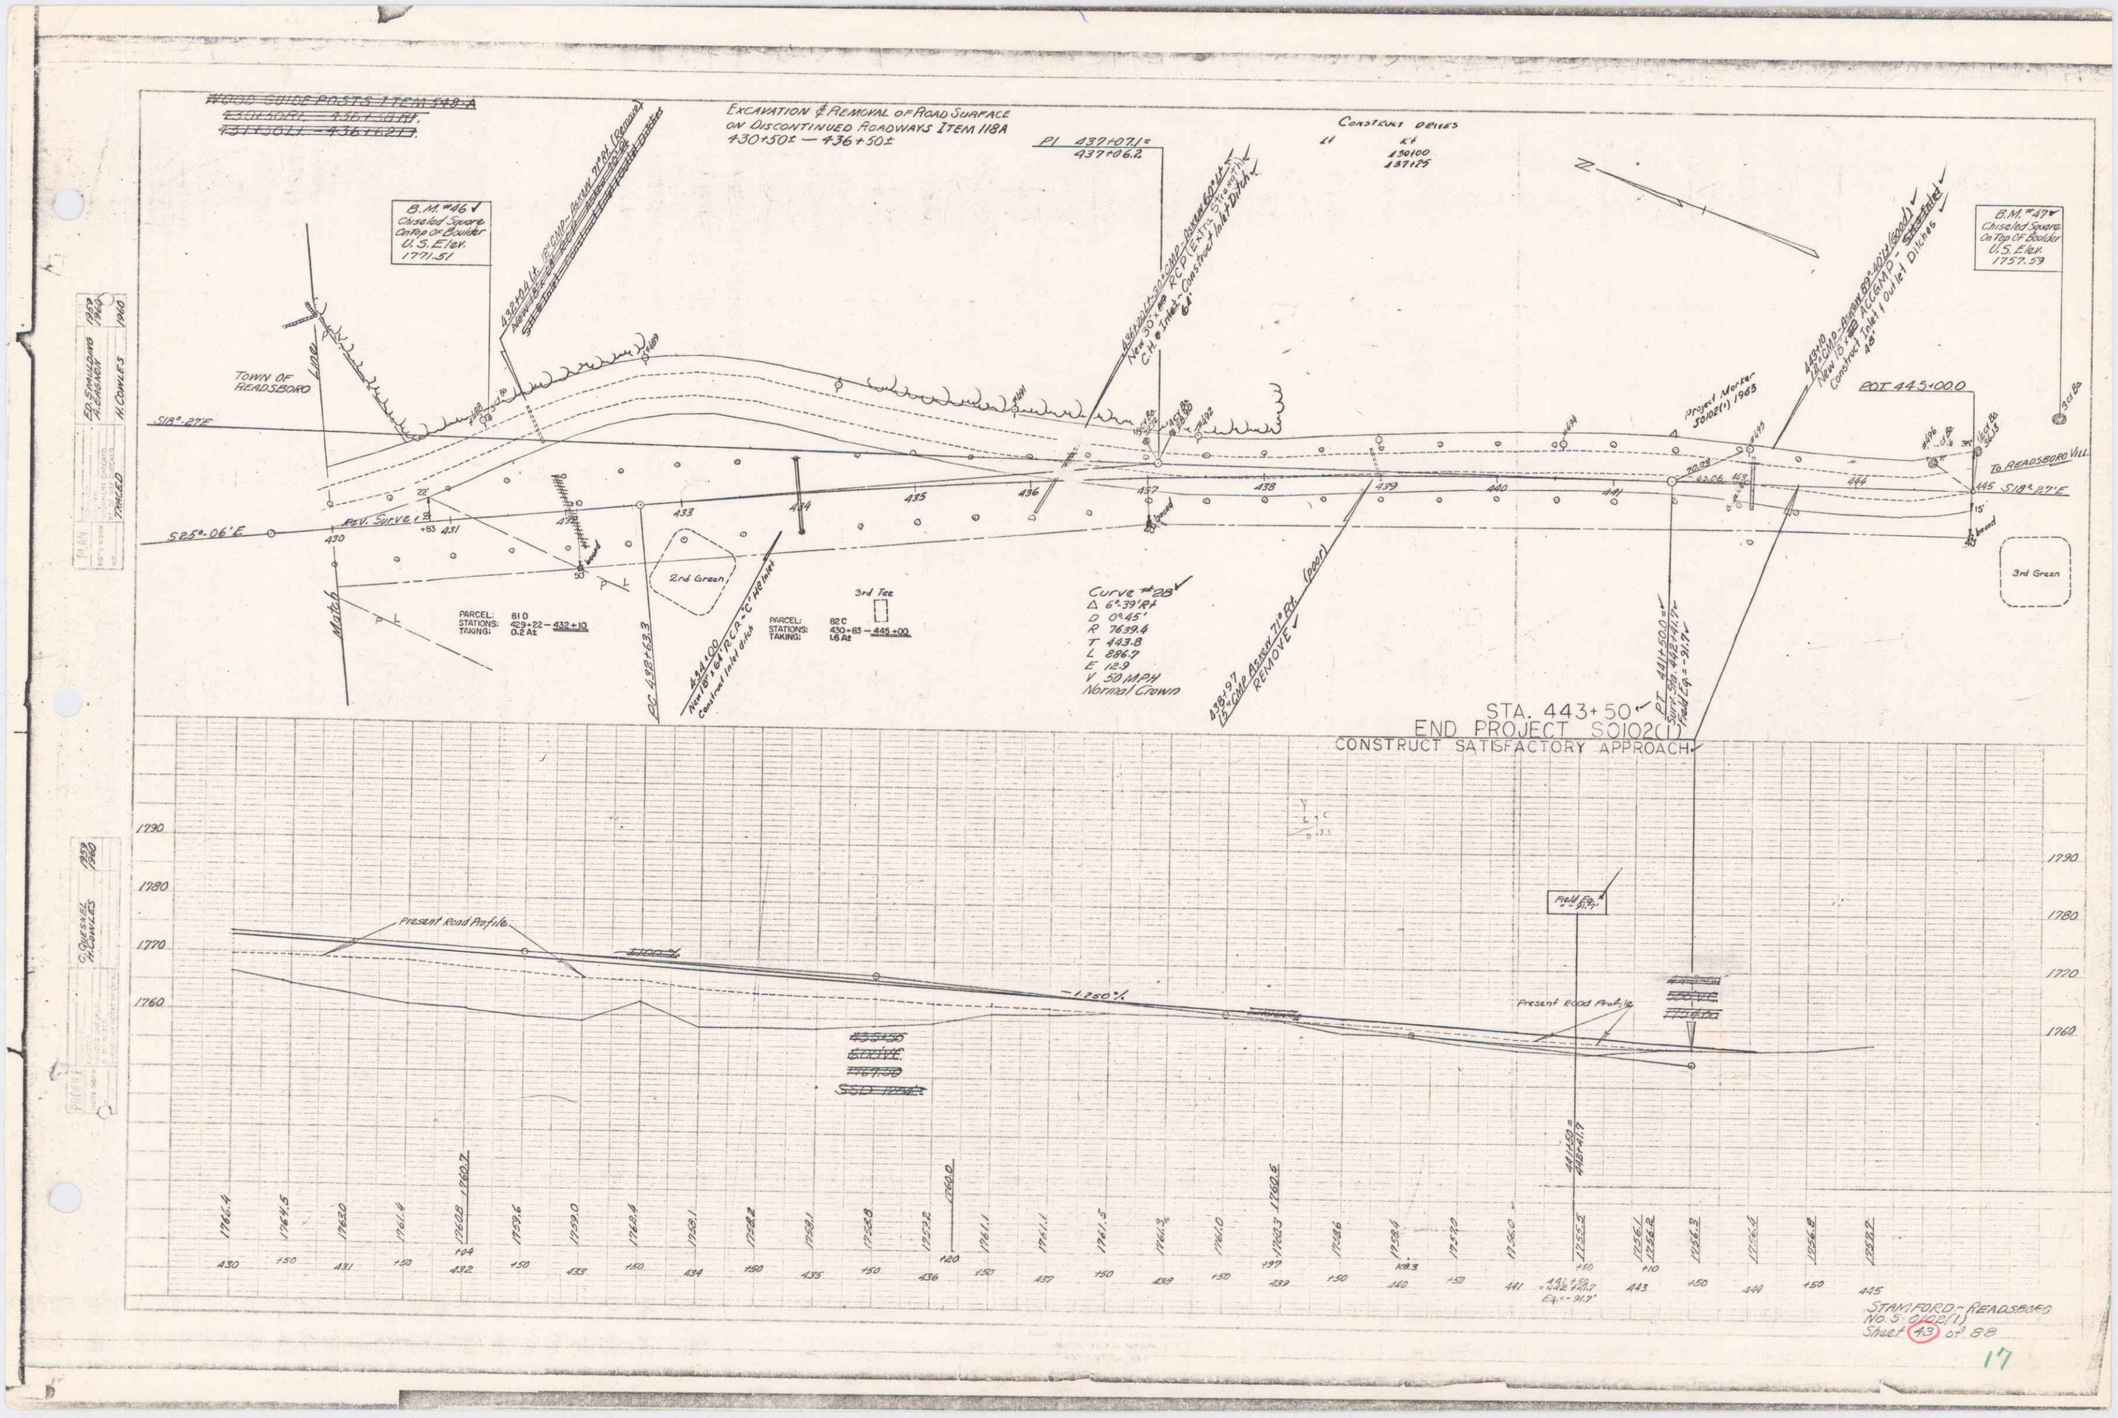
EXCAVATION & REMOVAL OF ROAD SURFACE ON DISCONTINUED ROADWAYS ITEM 118A
430+50± — 436+50±
CONSTRUCT DRIVES
B.M. #46
Chiseled Square On Top Of Boulder
U.S. Elev.
1771.51
B.M. #47
Chiseled Square On Top Of Boulder
U.S. Elev.
1757.59
TOWN OF READSBORO
S18° 27'E
S25° 06'E
REV. SURVEY
2nd Green
3rd Tee
3rd Green
PARCEL: 81 D
STATIONS: 429+22 — 432+10
TAKING: 0.2 Ac
PARCEL: 82 C
STATIONS: 430+63 — 445+00
1.6 Ac
Curve #28
Δ 6°39' Rt
D 0°45'
R 7639.4
T 443.8
L 886.7
E 12.9
V 50 MPH
Normal Crown
STA. 443+50
END PROJECT S0102(1)
CONSTRUCT SATISFACTORY APPROACH
Present Road Profile
-1.280%
To READSBORO VILL.
STANFORD - READSBORO
No. S 0102(1)
Sheet 43 of 88
17