DRILLING & BLASTING
SOLID ROCK SUBGRADE
203+00 - 206+75 · 207+00
213+75 - 219+00
214+40

TWO CABLE GUARD RAIL
Lt
207+00 - 215+00
Rt
207+25 - 208+00 -
208+52 - 213+50 -

CONSTRUCT APPROACH
Rt
209+00

CONSTRUCT DRIVE
Rt
214+00 - 215+50

WOOD GUIDE POSTS 8' c/c
Rt
214+50 (35' Rt) - 215+70 (62' Rt)

DEMOLITION & DISPOSAL OF BUILDING
Lt
#9 214+00

UNCLASSIFIED CHANNEL EXCAVATION
Lt.
207+75 - 213+00
20 212+50

STONE FILL FOR SLOPE PROTECTION (LIGHT TYPE)
Lt
207+75 - 213+00
30

EXCAVATION & REMOVAL OF ROAD SURFACES AND/OR PAVEMENTS
Lt
203+00 - 207+65 -
213+00 - 219+00

CONSTRUCT SPECIAL DITCH
(to be paid for under the Item of 103-A-1)
Rt
210+00 - 211+00

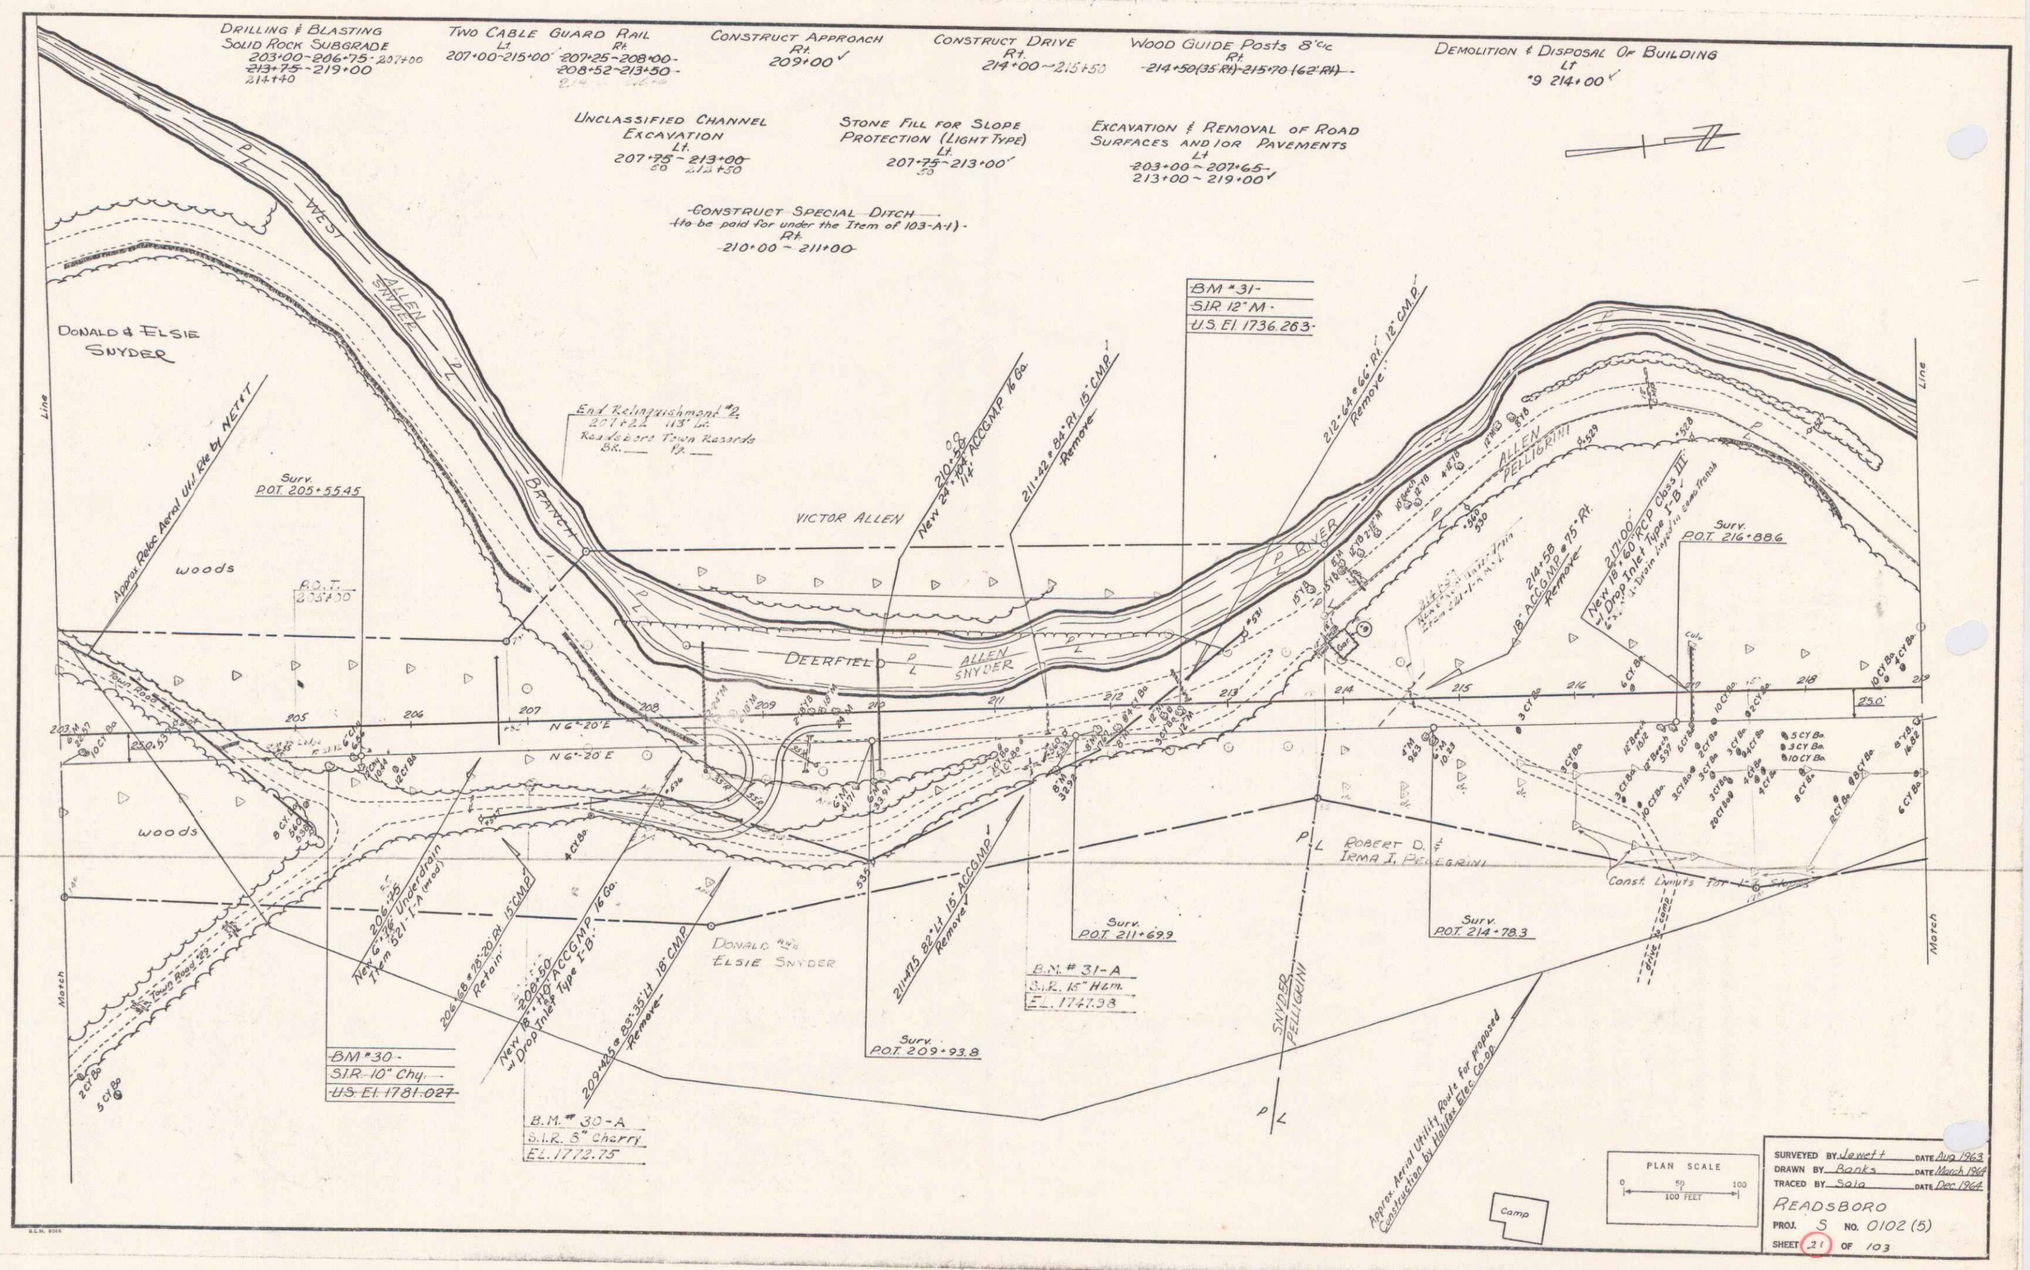

SURVEYED BY Jewett DATE Aug 1963
DRAWN BY Banks DATE March 1964
TRACED BY Sala DATE Dec 1964
READSBORO
PROJ. S NO. 0102 (5)
SHEET 21 OF 103

6