

DRILLING & BLASTING OF
SOLID ROCK SUBGRADE
219+00-219+35

CONSTRUCT DRIVE
Rt.
220+25
221+50
222+70
222+70

UNCLASSIFIED CHANNEL
EXCAVATION
Lt. 50
221+25-231+00

STONE FILL FOR SLOPE
PROTECTION (LIGHT TYPE)
Lt. 50
221+25-231+00

TWO CABLE GUARD RAIL
Lt. 50
219+25-231+96
234+78-235+00


TREATED TIMBER CURB
Lt. 50
219+25-221+25

PAVED SHOULDER
(ITEM 361-B)
Lt. 50
219+25-230+00.8

EXCAVATION & REMOVAL OF ROAD
SURFACES AND/OR PAYEMENTS
Lt. 50
219+00-221+00

REMOVAL & DISPOSAL OF
PRESENT GUARD RAIL
Lt. 50
219+86-220+21
219+94-220+30

Rev Curve Data
Δ 39°-00' Lt.
D 4°-30'
R 1273.2'
T 450.9'
L 866.7'
E 77.47'
Bank 5/8" in 12"

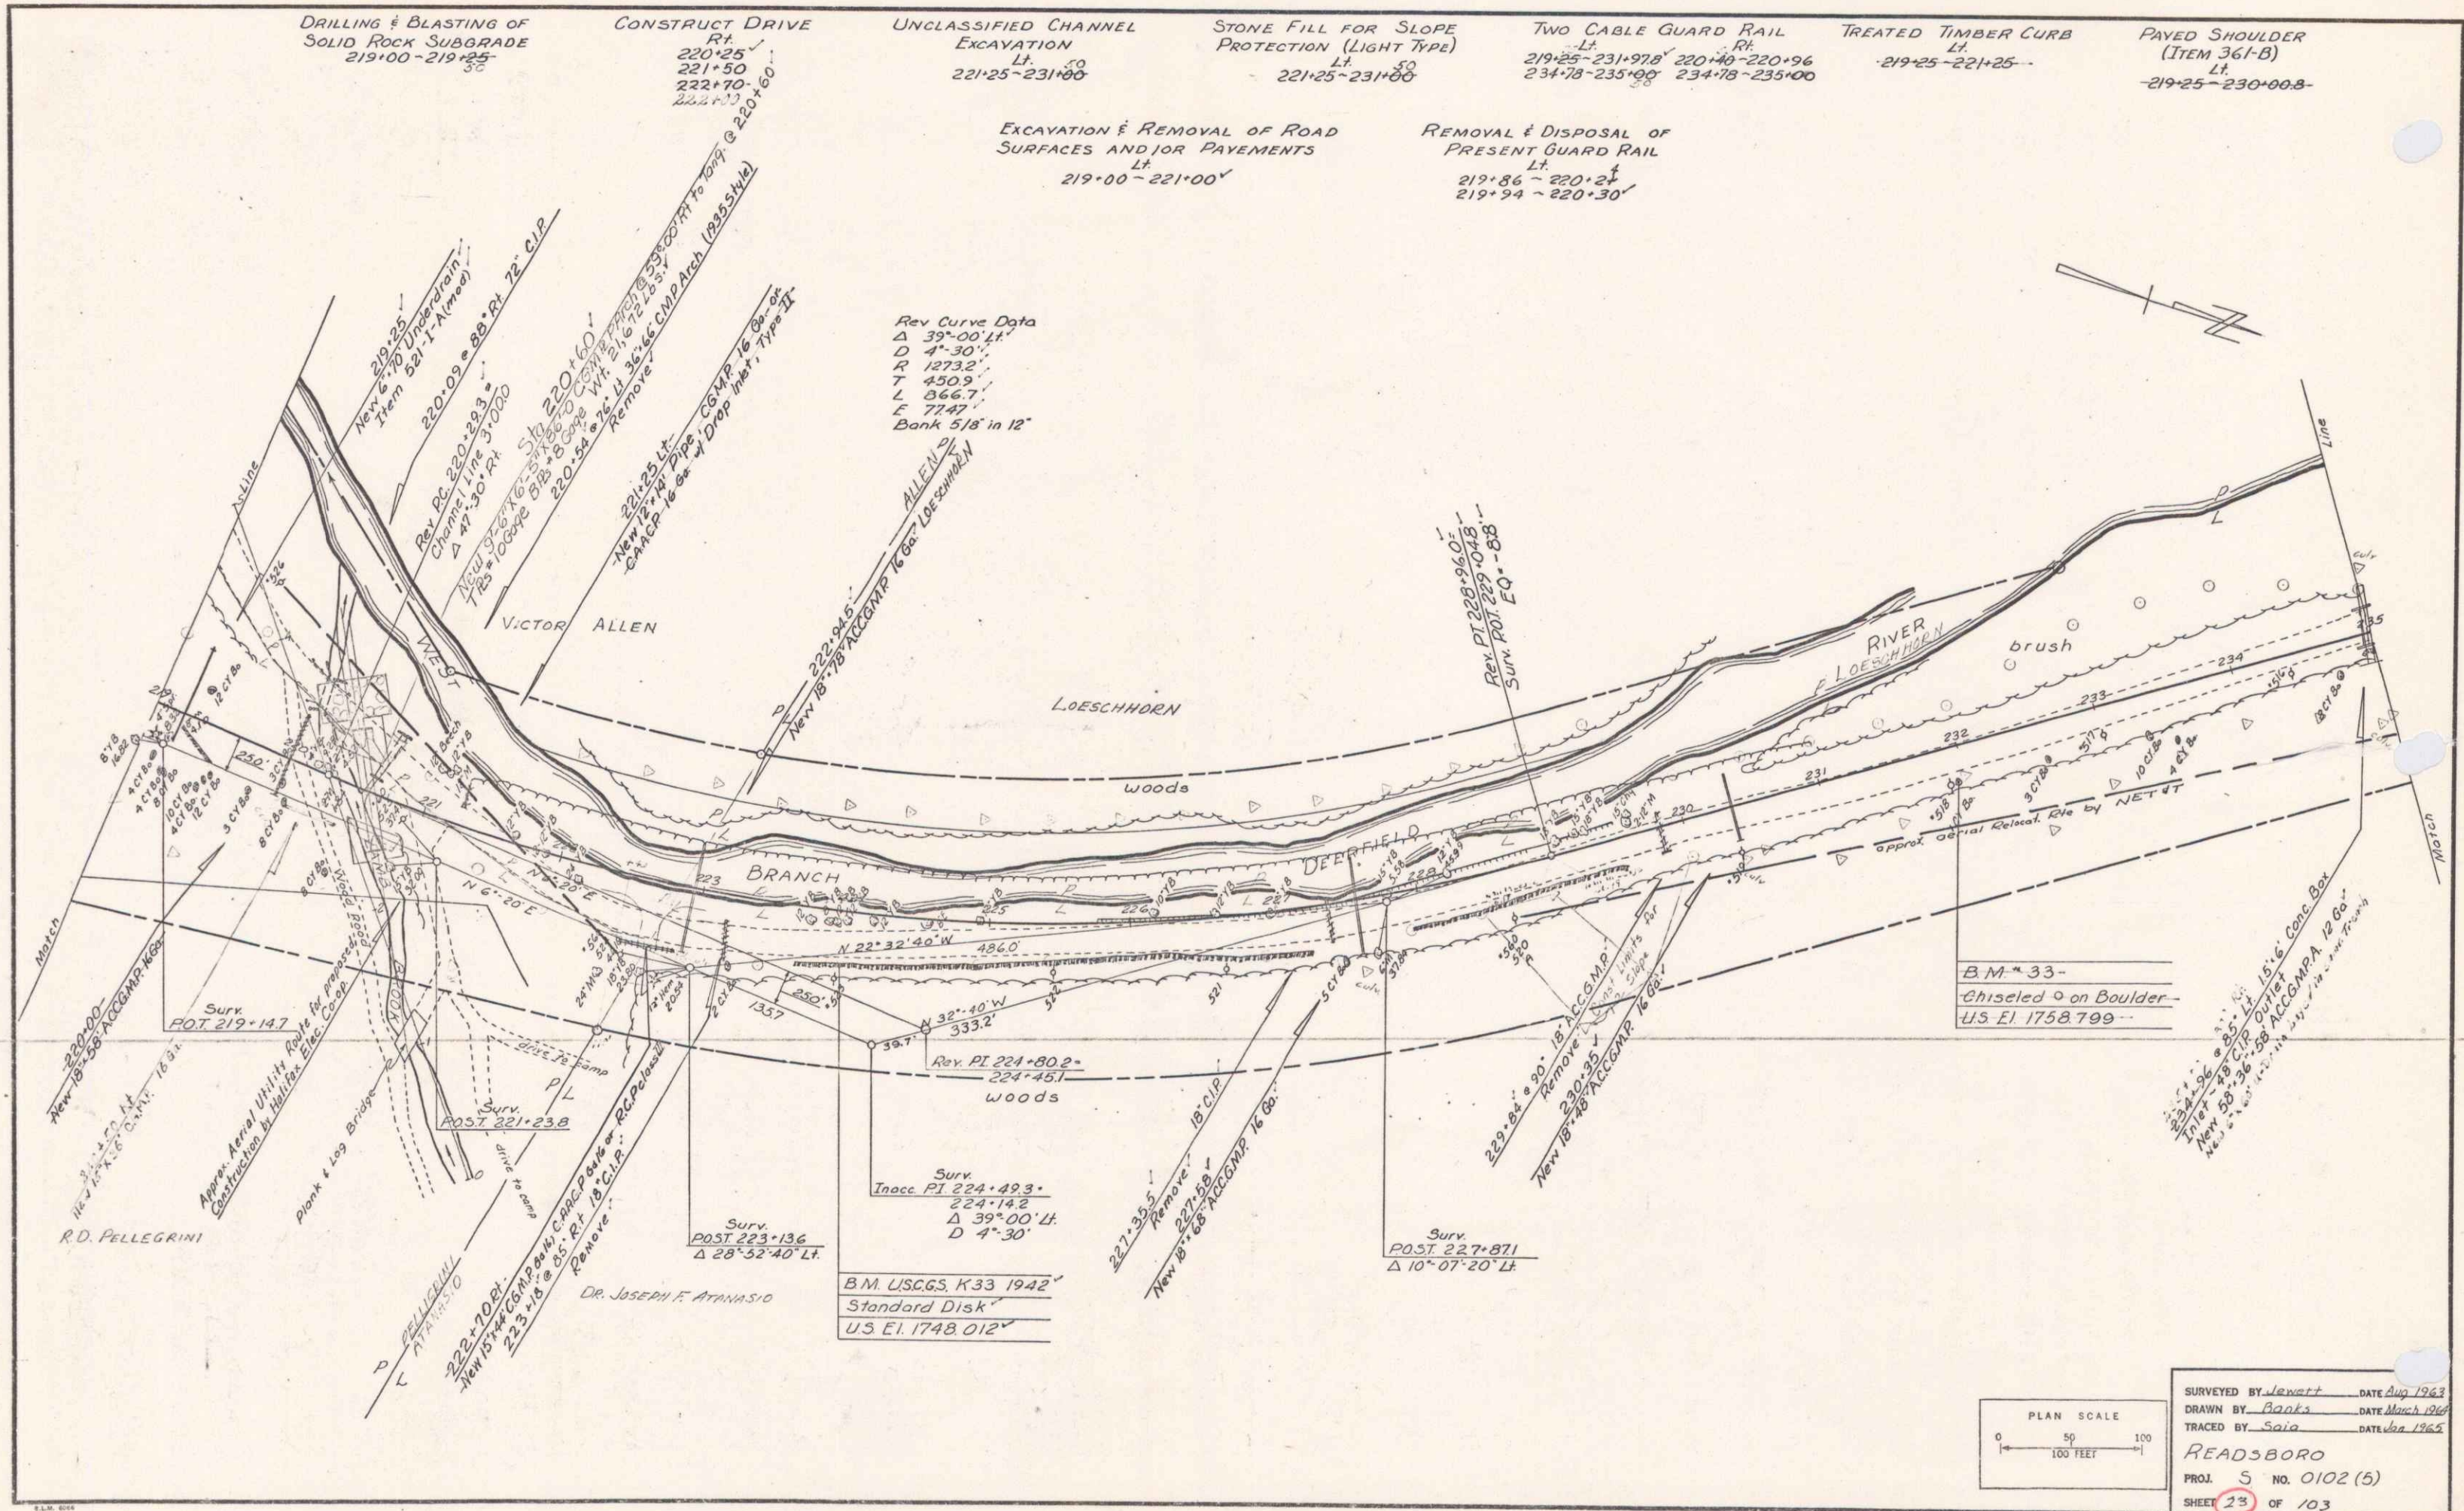

B.M. 33-
Chiseled 9 on Boulder-
US El. 1758.799

PLAN SCALE
0 50 100
100 FEET

SURVEYED BY Jenett DATE Aug 1963
DRAWN BY Banks DATE March 1964
TRACED BY Saia DATE Jan 1965
READSBORO
PROJ. 5 NO. 0102 (5)
SHEET 23 OF 103