Construct Dike
Lt.
104+00± ~ 107+00± (10 ft. Rad. 15 ft.)
107+00

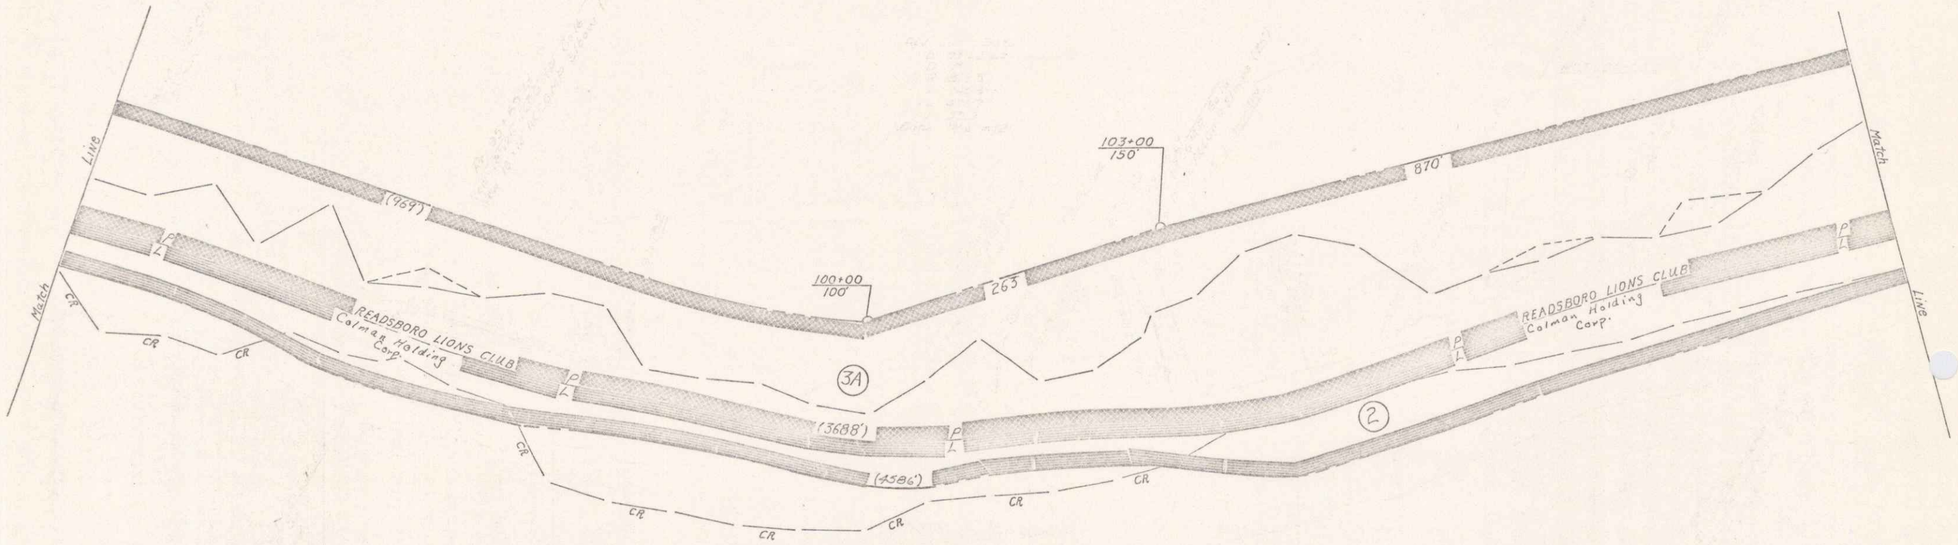

VERMONT DEPARTMENT OF HIGHWAYS
RIGHT-OF-WAY PLANS
PROJECT READSBORO
NO. S0102(6)
SHEET 8 OF 67