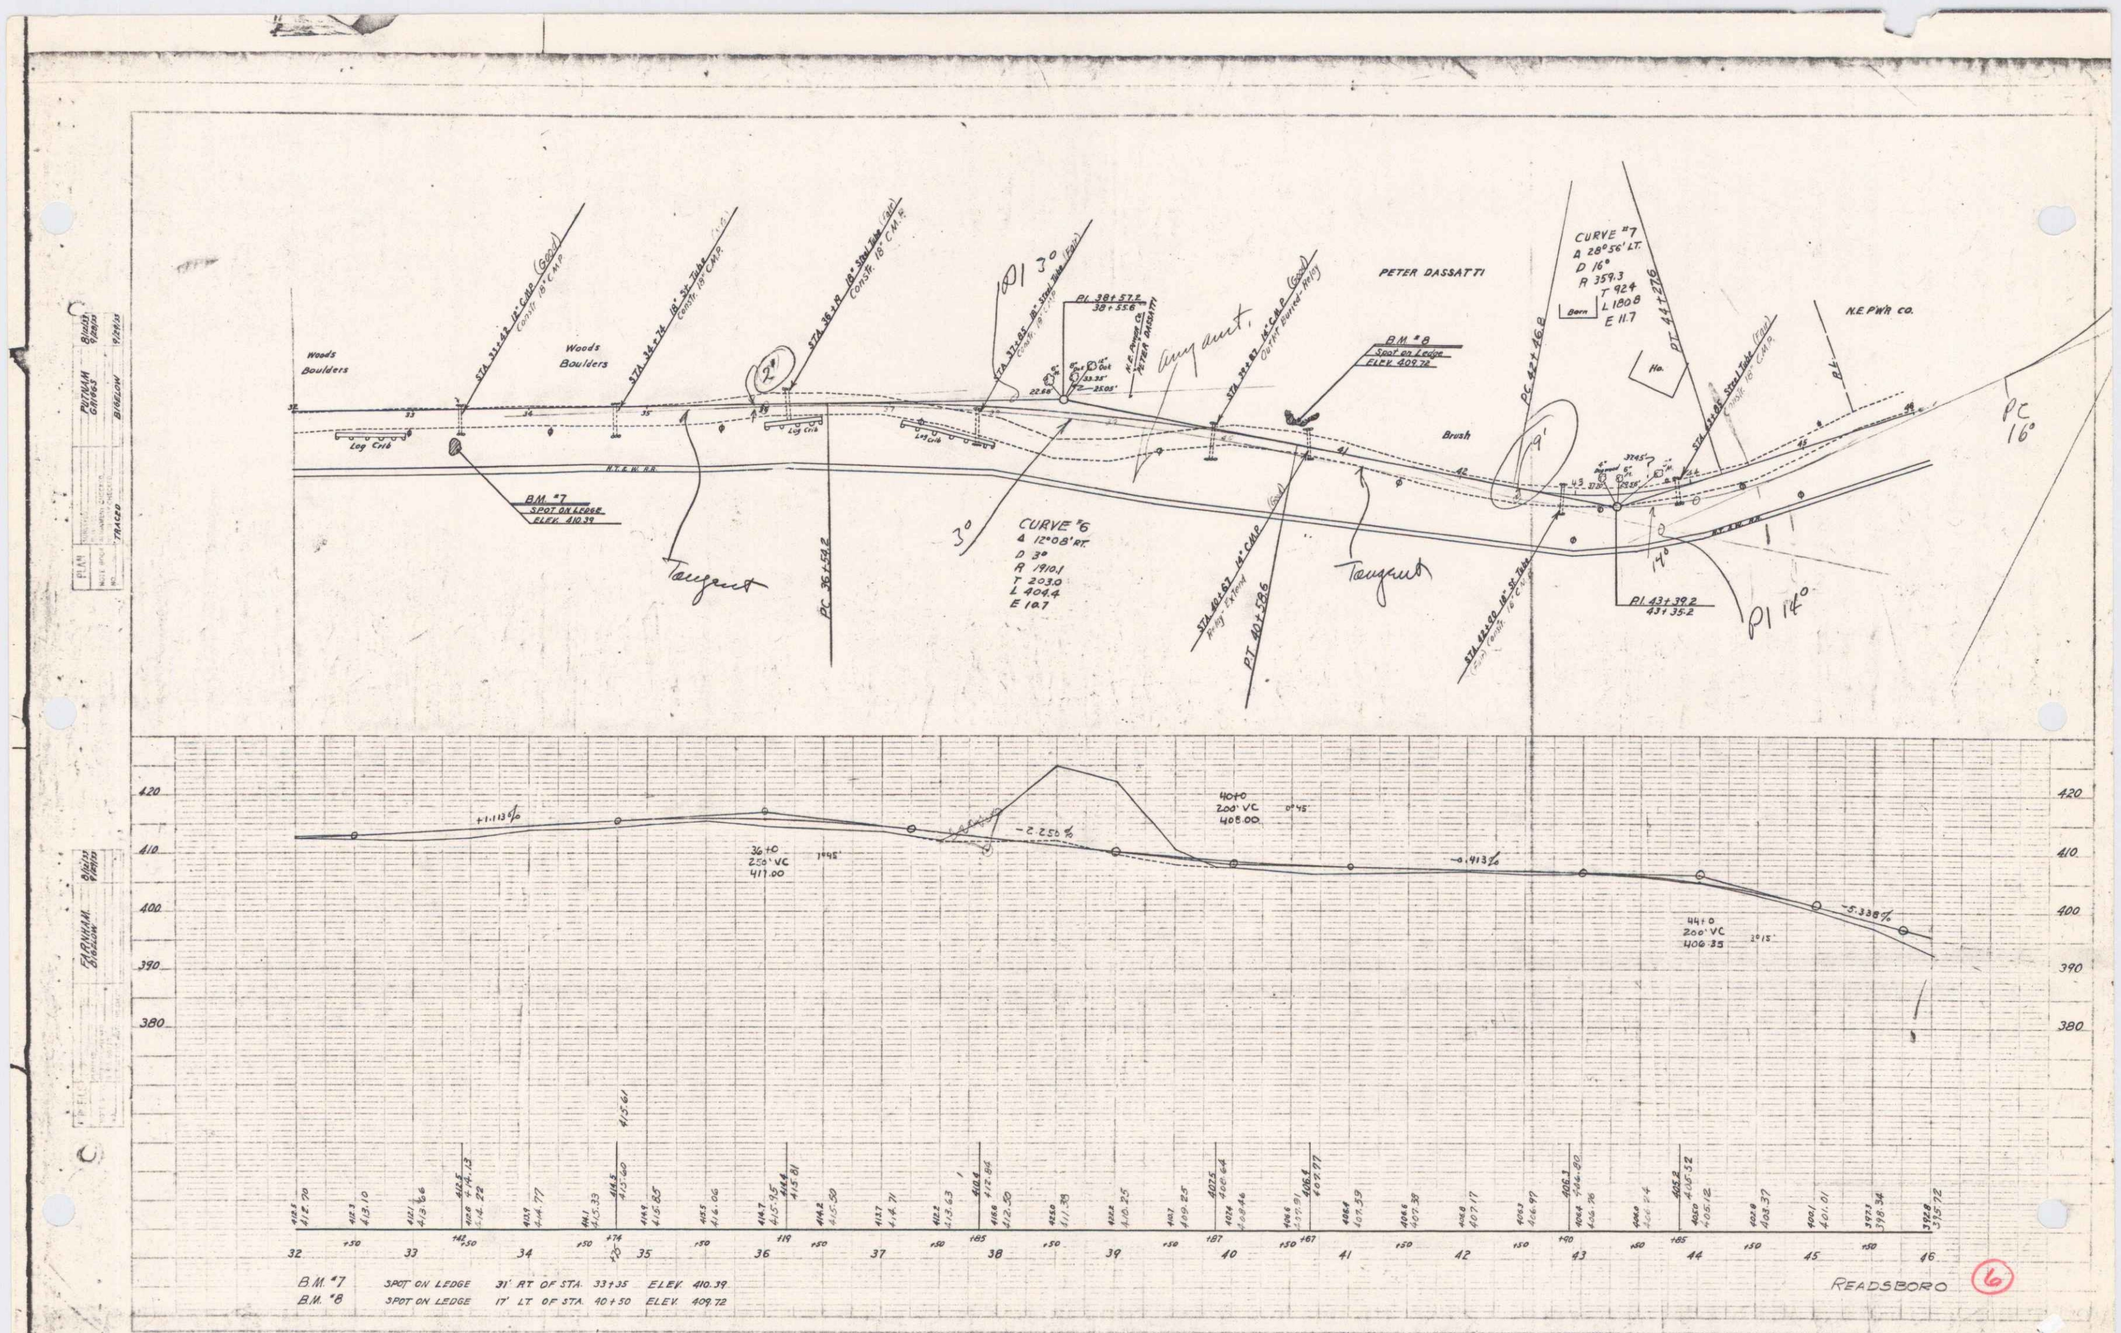
PETER DASSATTI
N.E. PW'R CO.
Woods
Boulders
Log Crib
Brush
Ho.
N.Y.N.H.&H. R.R.
BM #7
SPOT ON LEDGE
ELEV. 410.39
BM #8
Spot on Ledge
ELEV. 409.72
CURVE #6
Δ 12°08' RT.
D 3°
R 1910.1
T 203.0
L 404.4
E 19.7
CURVE #7
Δ 28°56' LT.
D 16°
R 359.3
T 92.4
L 180.8
E 11.7
PC 36+58.2
PT 40+58.6
PC 42+46.8
PT 44+27.6
PI 38+57.2
38+55.6
PI 43+39.2
43+35.2
Tangent
Tangent
Tangent
PC 16°
PI 14°
PI 3°
3°
19°
14°
+1.113%
-0.252%
-0.413%
-5.338%
36+0
250' VC
417.00
40+0
200' VC
405.00
44+0
200' VC
406.35
420
410
400
390
380
32
33
34
35
36
37
38
39
40
41
42
43
44
45
46
BM #7 SPOT ON LEDGE 31' RT OF STA. 33+35 ELEV. 410.39
BM #8 SPOT ON LEDGE 17' LT OF STA. 40+50 ELEV. 409.72
READSBORO
6
Readsboro 4