


FED. ROAD DIST. NO.	STATE	DOCKET	YEAR	SHEET NO.	TOTAL SHEETS
	VT.	1040-R	1934	5	27

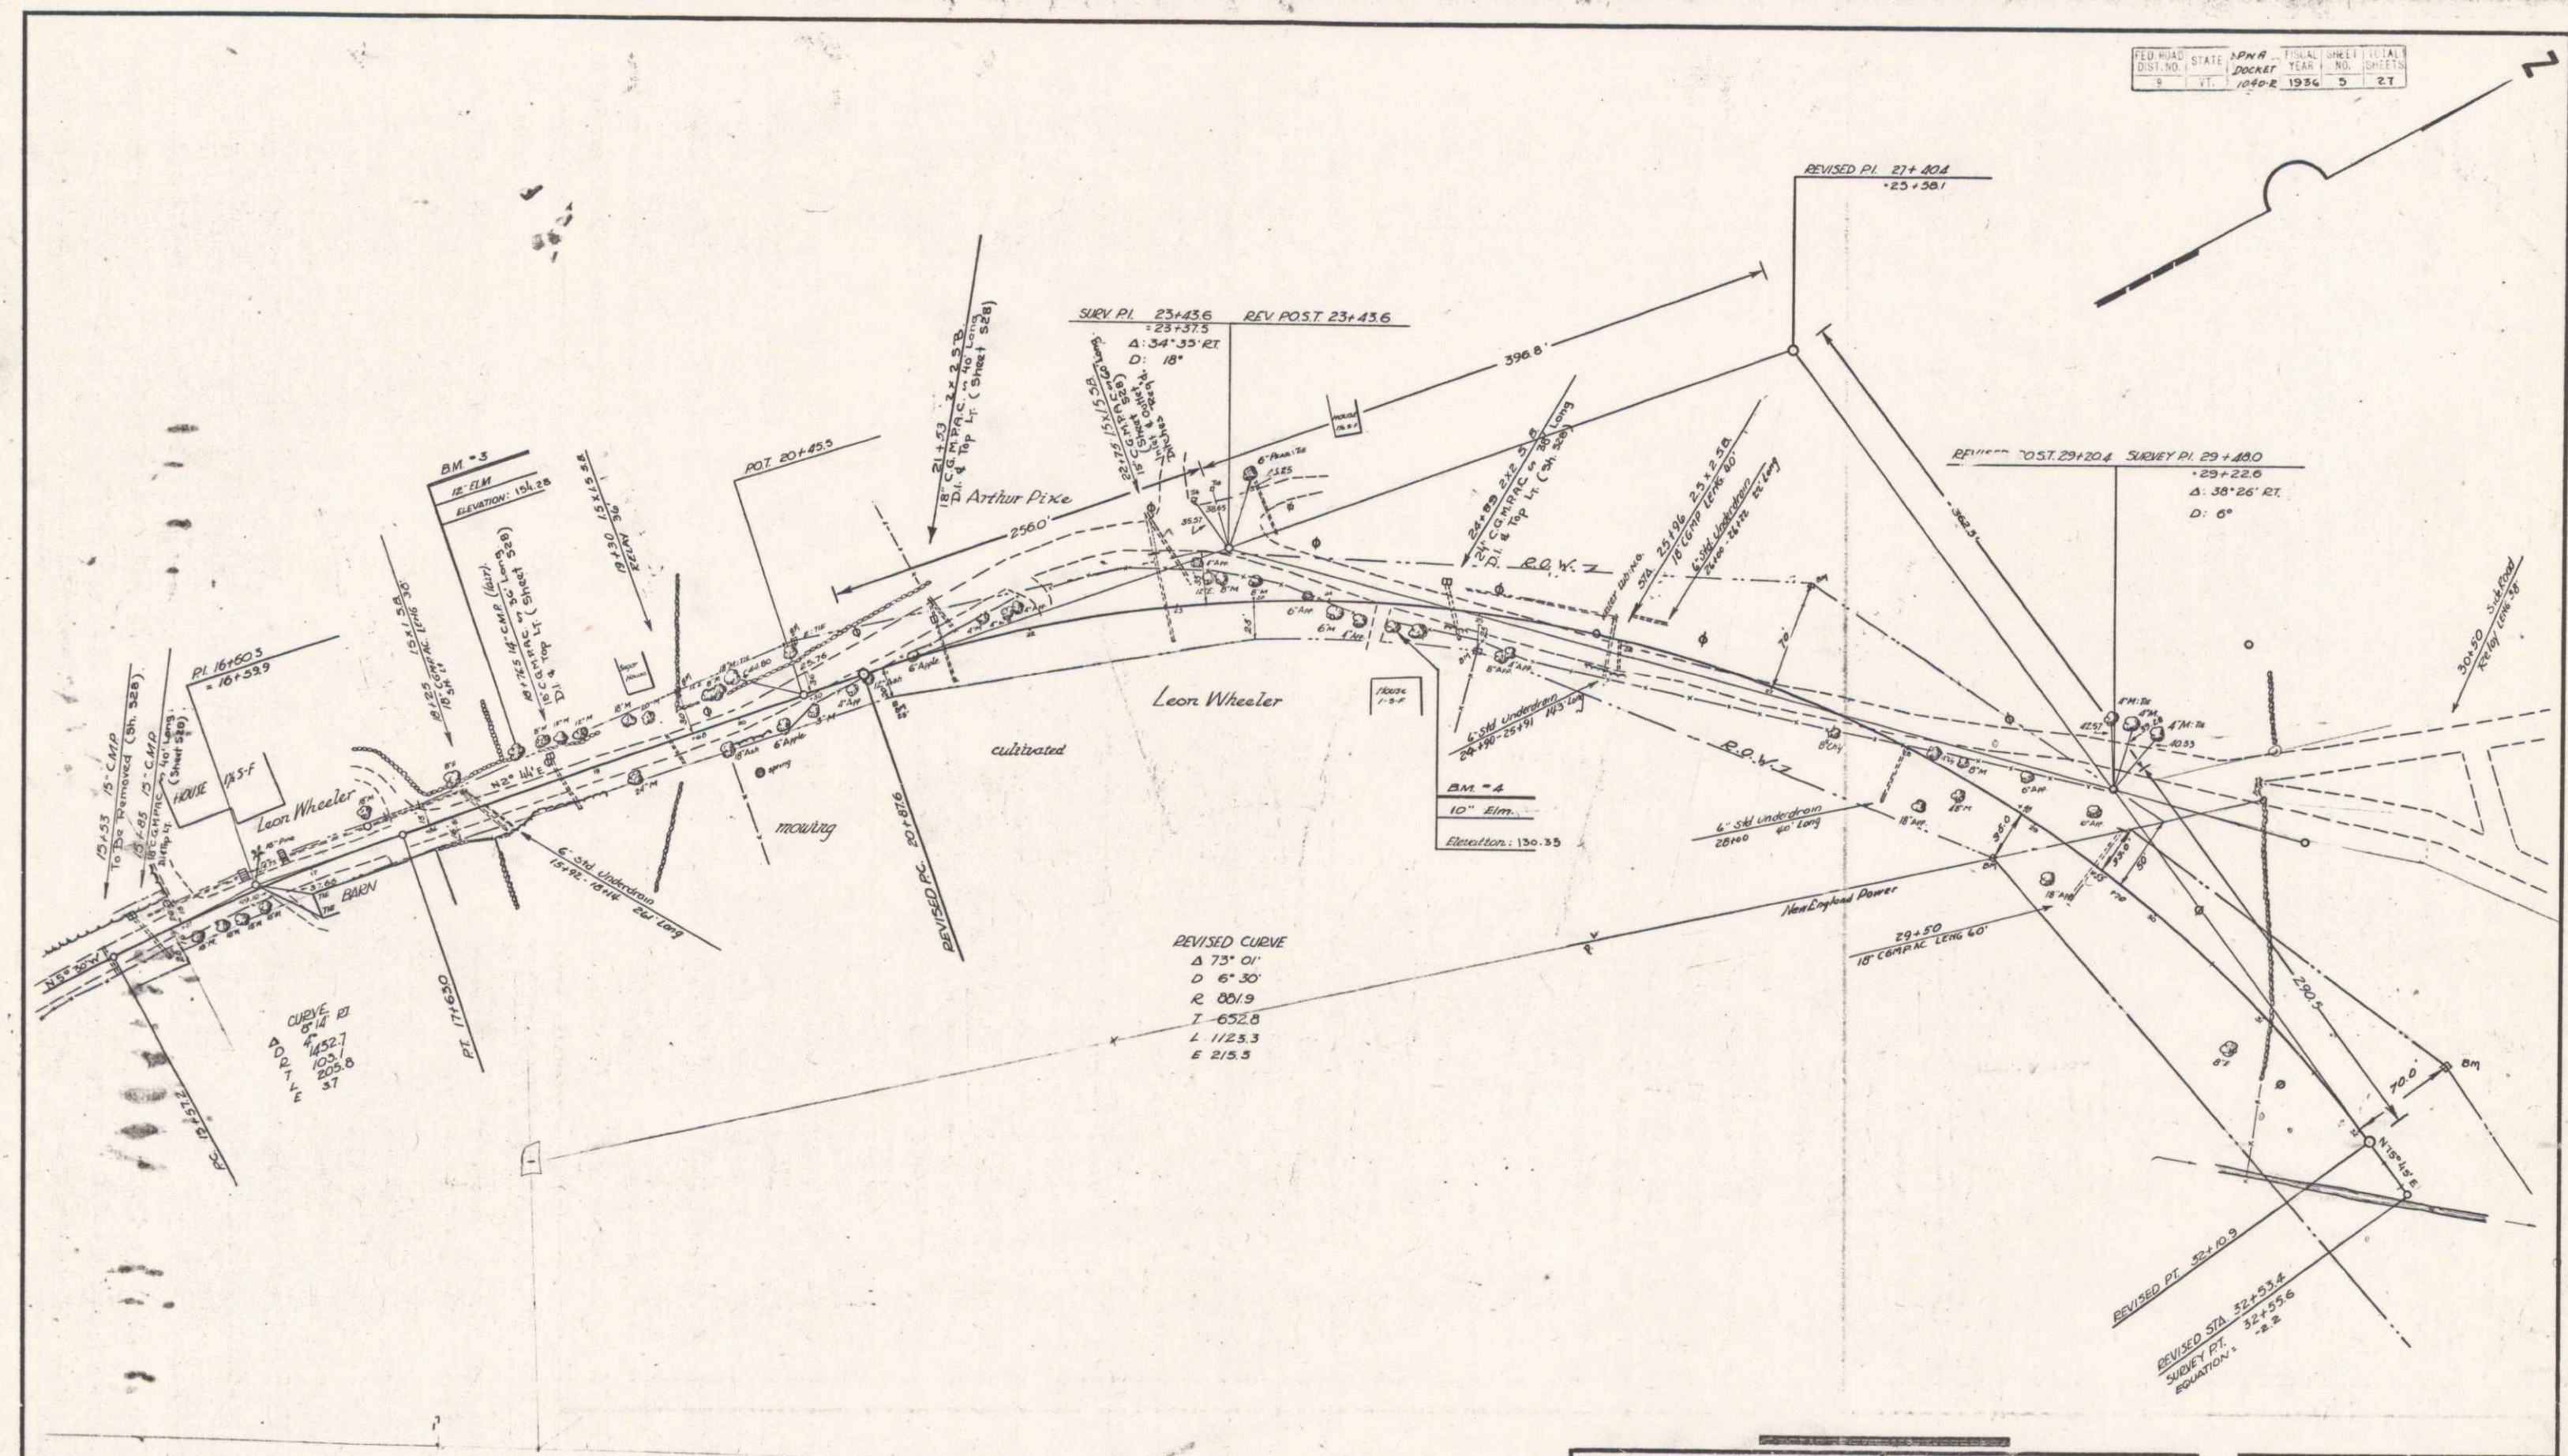

Surveyed by H. W. BROWN
 Designed by G. B. CROLEY
 Drawn by G. B. CROLEY
 Traced by G. B. CROLEY
 Checked by G. B. CROLEY
 Series P.M. No. 1040-R Filed
 Docket No. 1040-R Sheet 5 of 27 Sheets