PARCEL 417 A
INSTRUMENT W.D.O.E.
DATE 11-12-49

GRANTOR EFFIE, RAYMONDE, CHARLES E. FOWLER & ELIZABETH C. CASTINE
GRANTEE ST. OF VT.
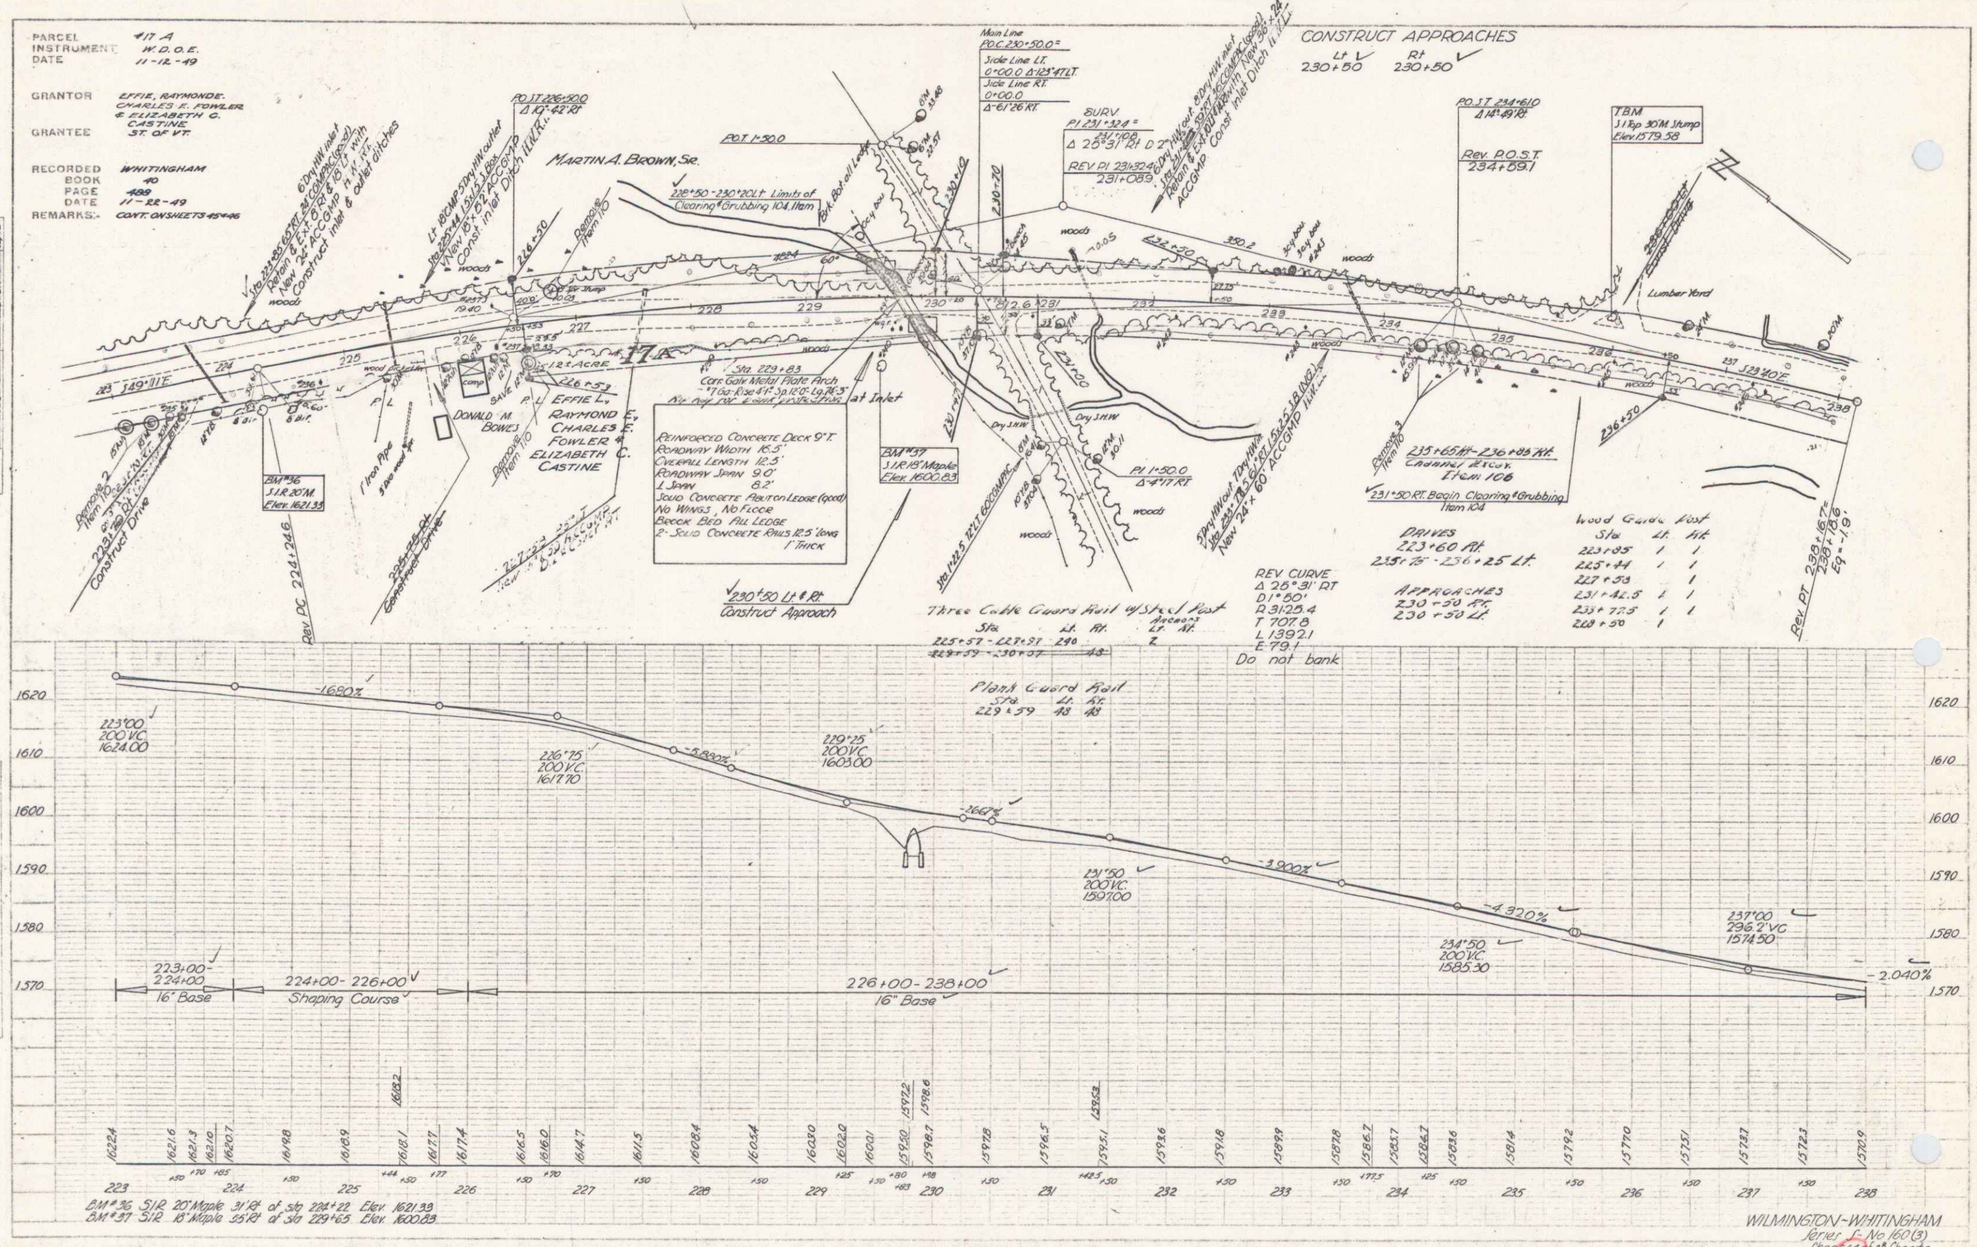
RECORDED WHITINGHAM
BOOK 40
PAGE 488
DATE 11-22-49
REMARKS:- CONT. ON SHEETS 45 & 46