POOR ORIGINAL COPY

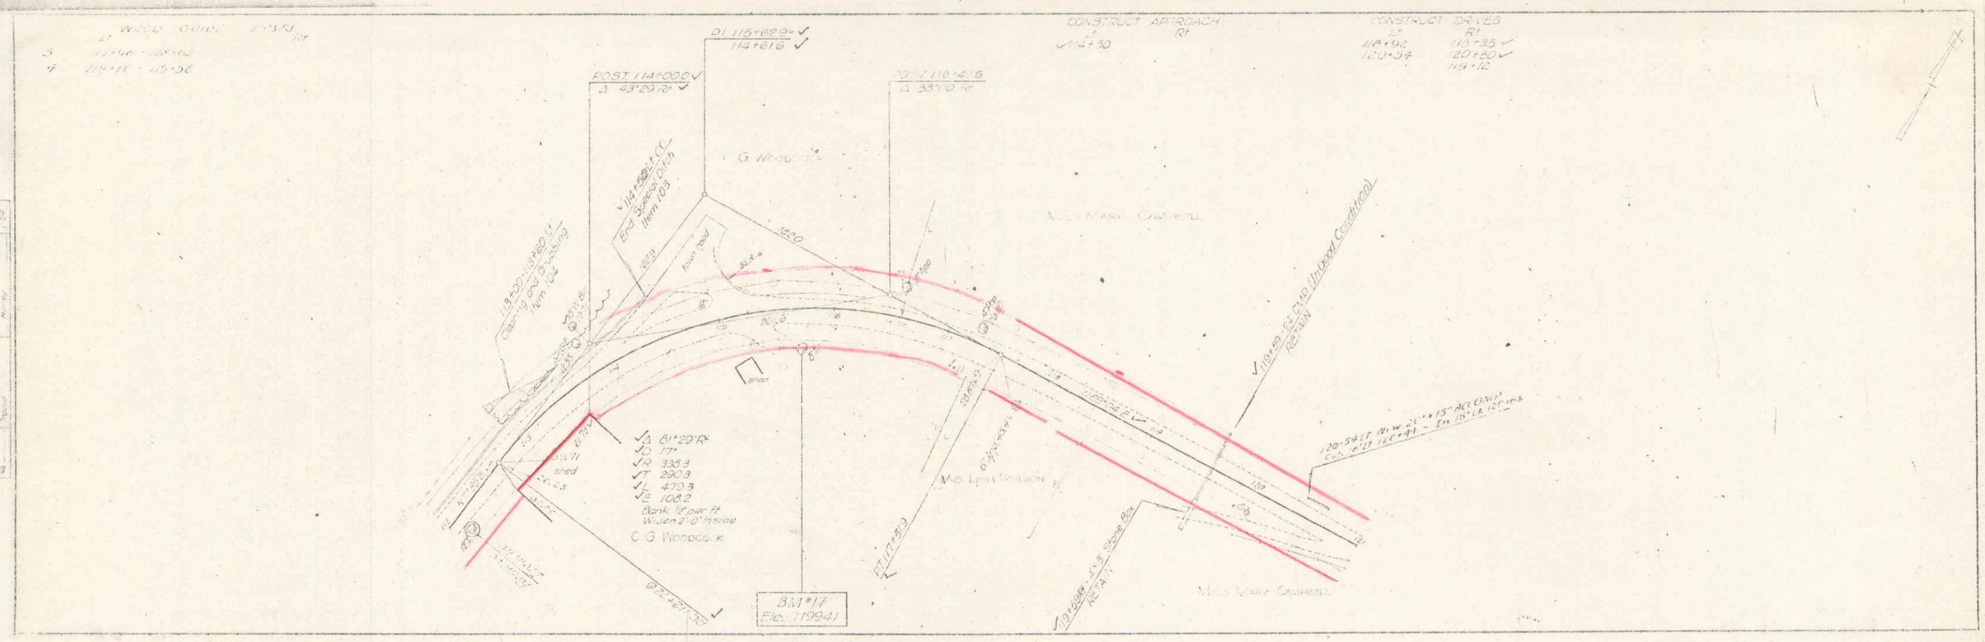

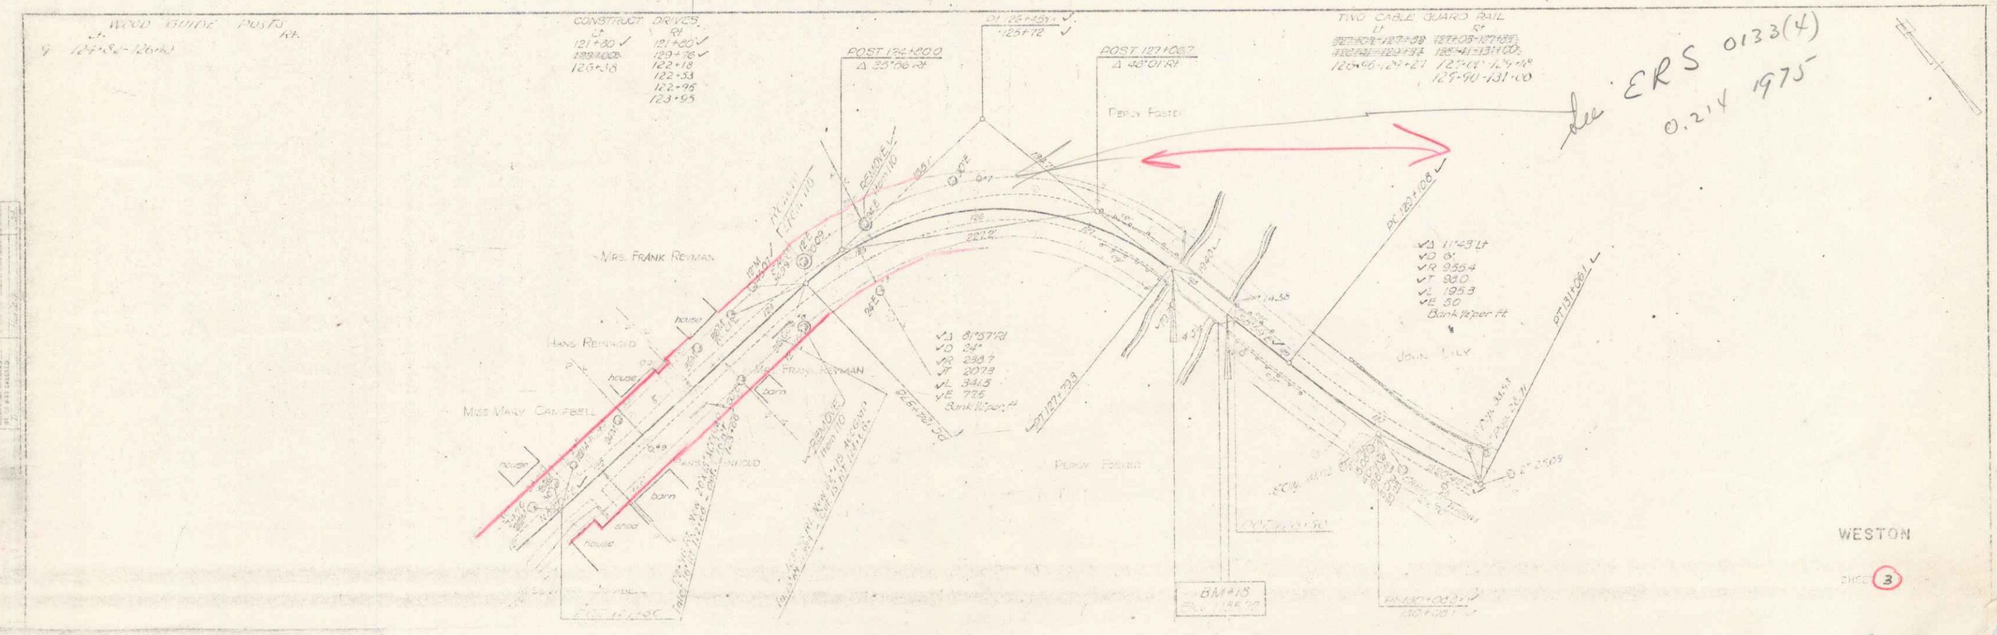

WESTON

SHEET 3

3