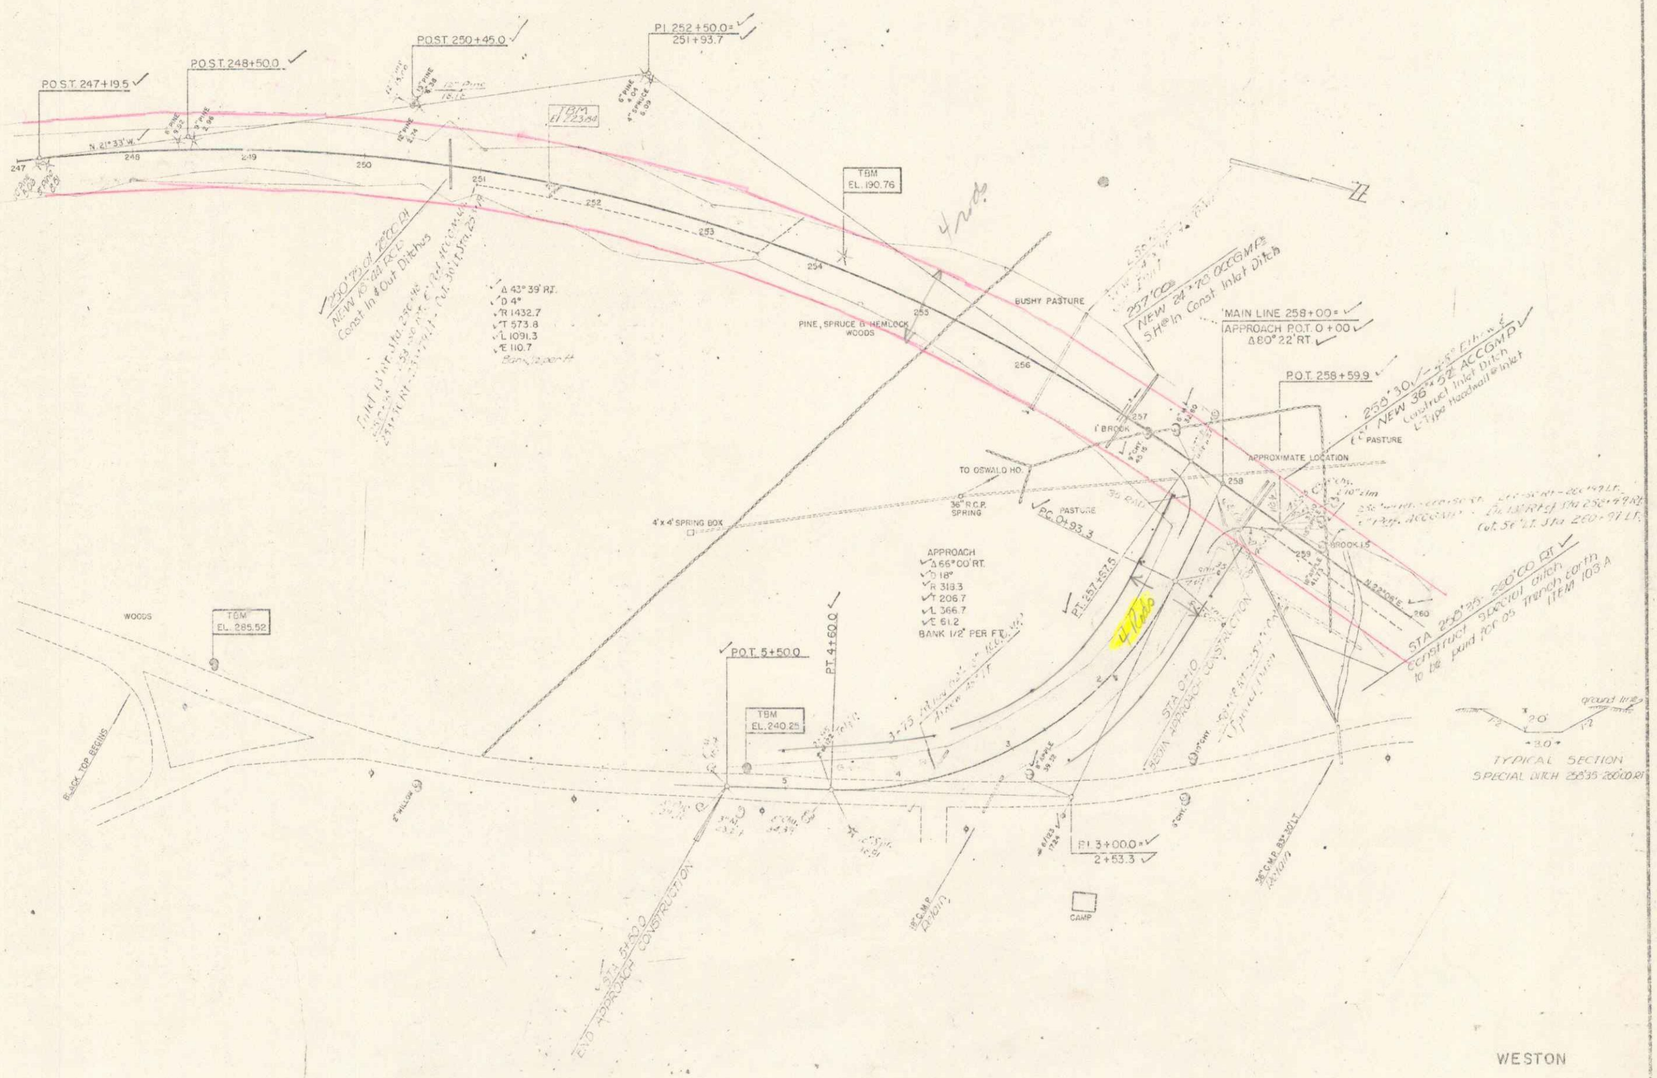
CONSTRUCT APPROACH
258+60 RT.
P.O.S.T. 247+19.5
P.O.S.T. 248+50.0
P.O.S.T. 250+45.0
P.I. 252+50.0=
251+93.7
TBM
EL. 190.76
N. 21° 33' W.
247
248
249
250
251
252
253
254
255
256
257
258
259
260
Δ 42° 39' RT.
D 4°
R 1432.7
T 573.8
L 1091.3
E 110.7
BUSHY PASTURE
PINE, SPRUCE & HEMLOCK WOODS
MAIN LINE 258+00=
APPROACH P.O.T. 0+00
Δ 60° 22' RT.
P.O.T. 258+59.9
BROOK
PASTURE
APPROXIMATE LOCATION
TO OSWALD HO.
36" R.C.P. SPRING
4'x4' SPRING BOX
P.C. 0+93.3
P.I. 257+57.5
APPROACH
Δ 66° 00' RT.
D 18°
R 318.3
T 206.7
L 366.7
E 61.2
BANK 1½' PER FT.
WOODS
TBM
EL. 285.52
BLACK TOP BEGINS
P.O.T. 5+50.0
P.T. 4+50.0
TBM
EL. 240.25
P.I. 3+00.0=
2+53.3
CAMP
TYPICAL SECTION
SPECIAL DITCH 28'35'-26'00 RT.
WESTON
SHEET 9 OF 18

9