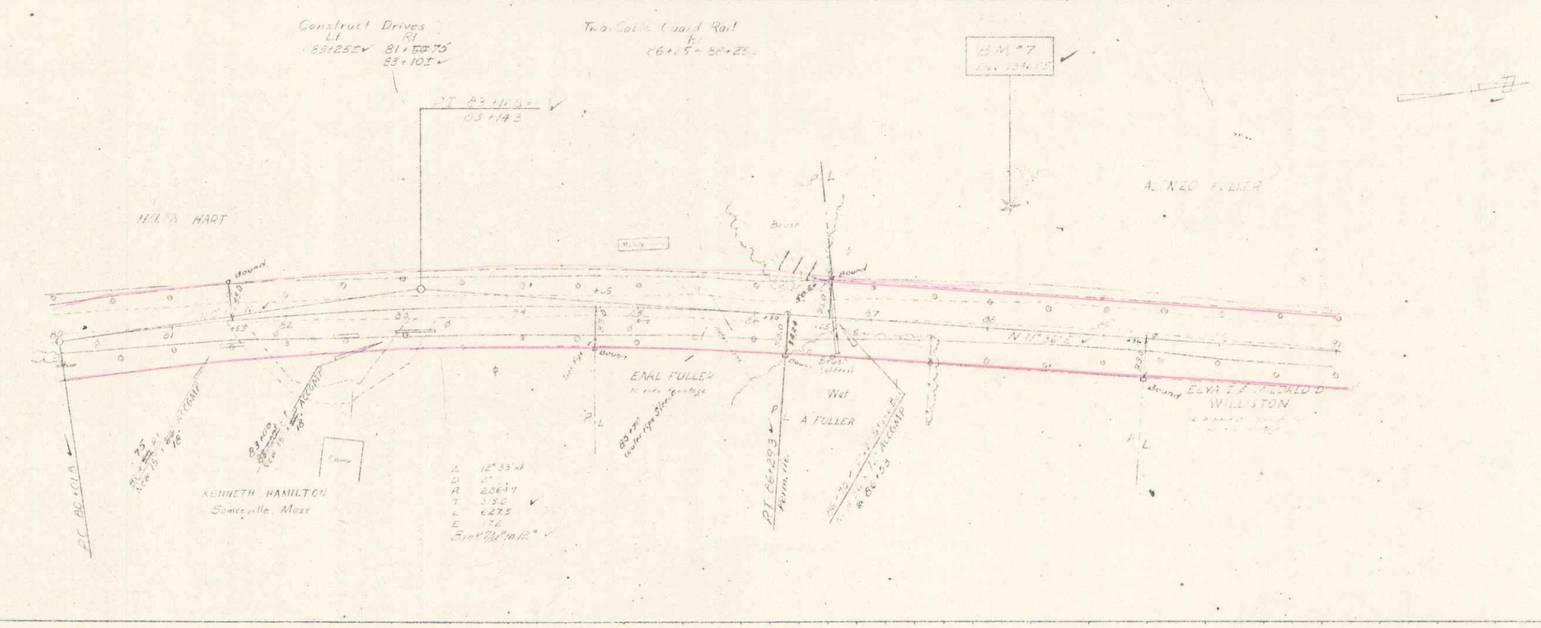

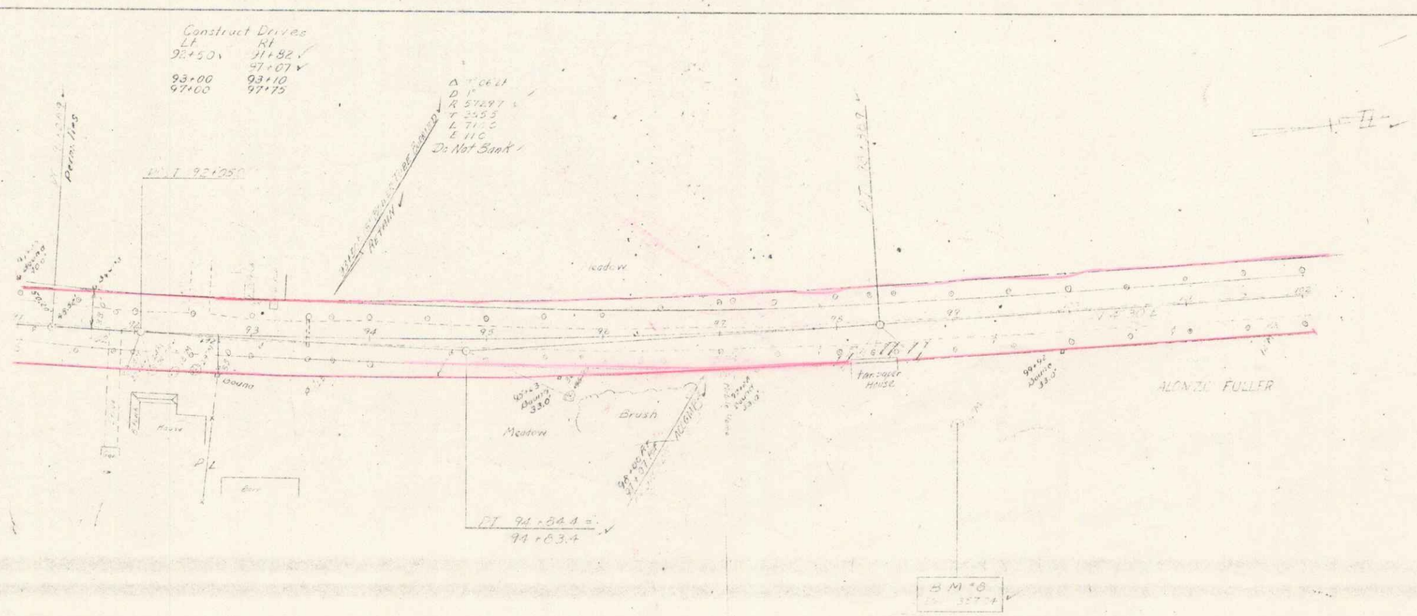

WESTON

SHEET 14 OF 15

14