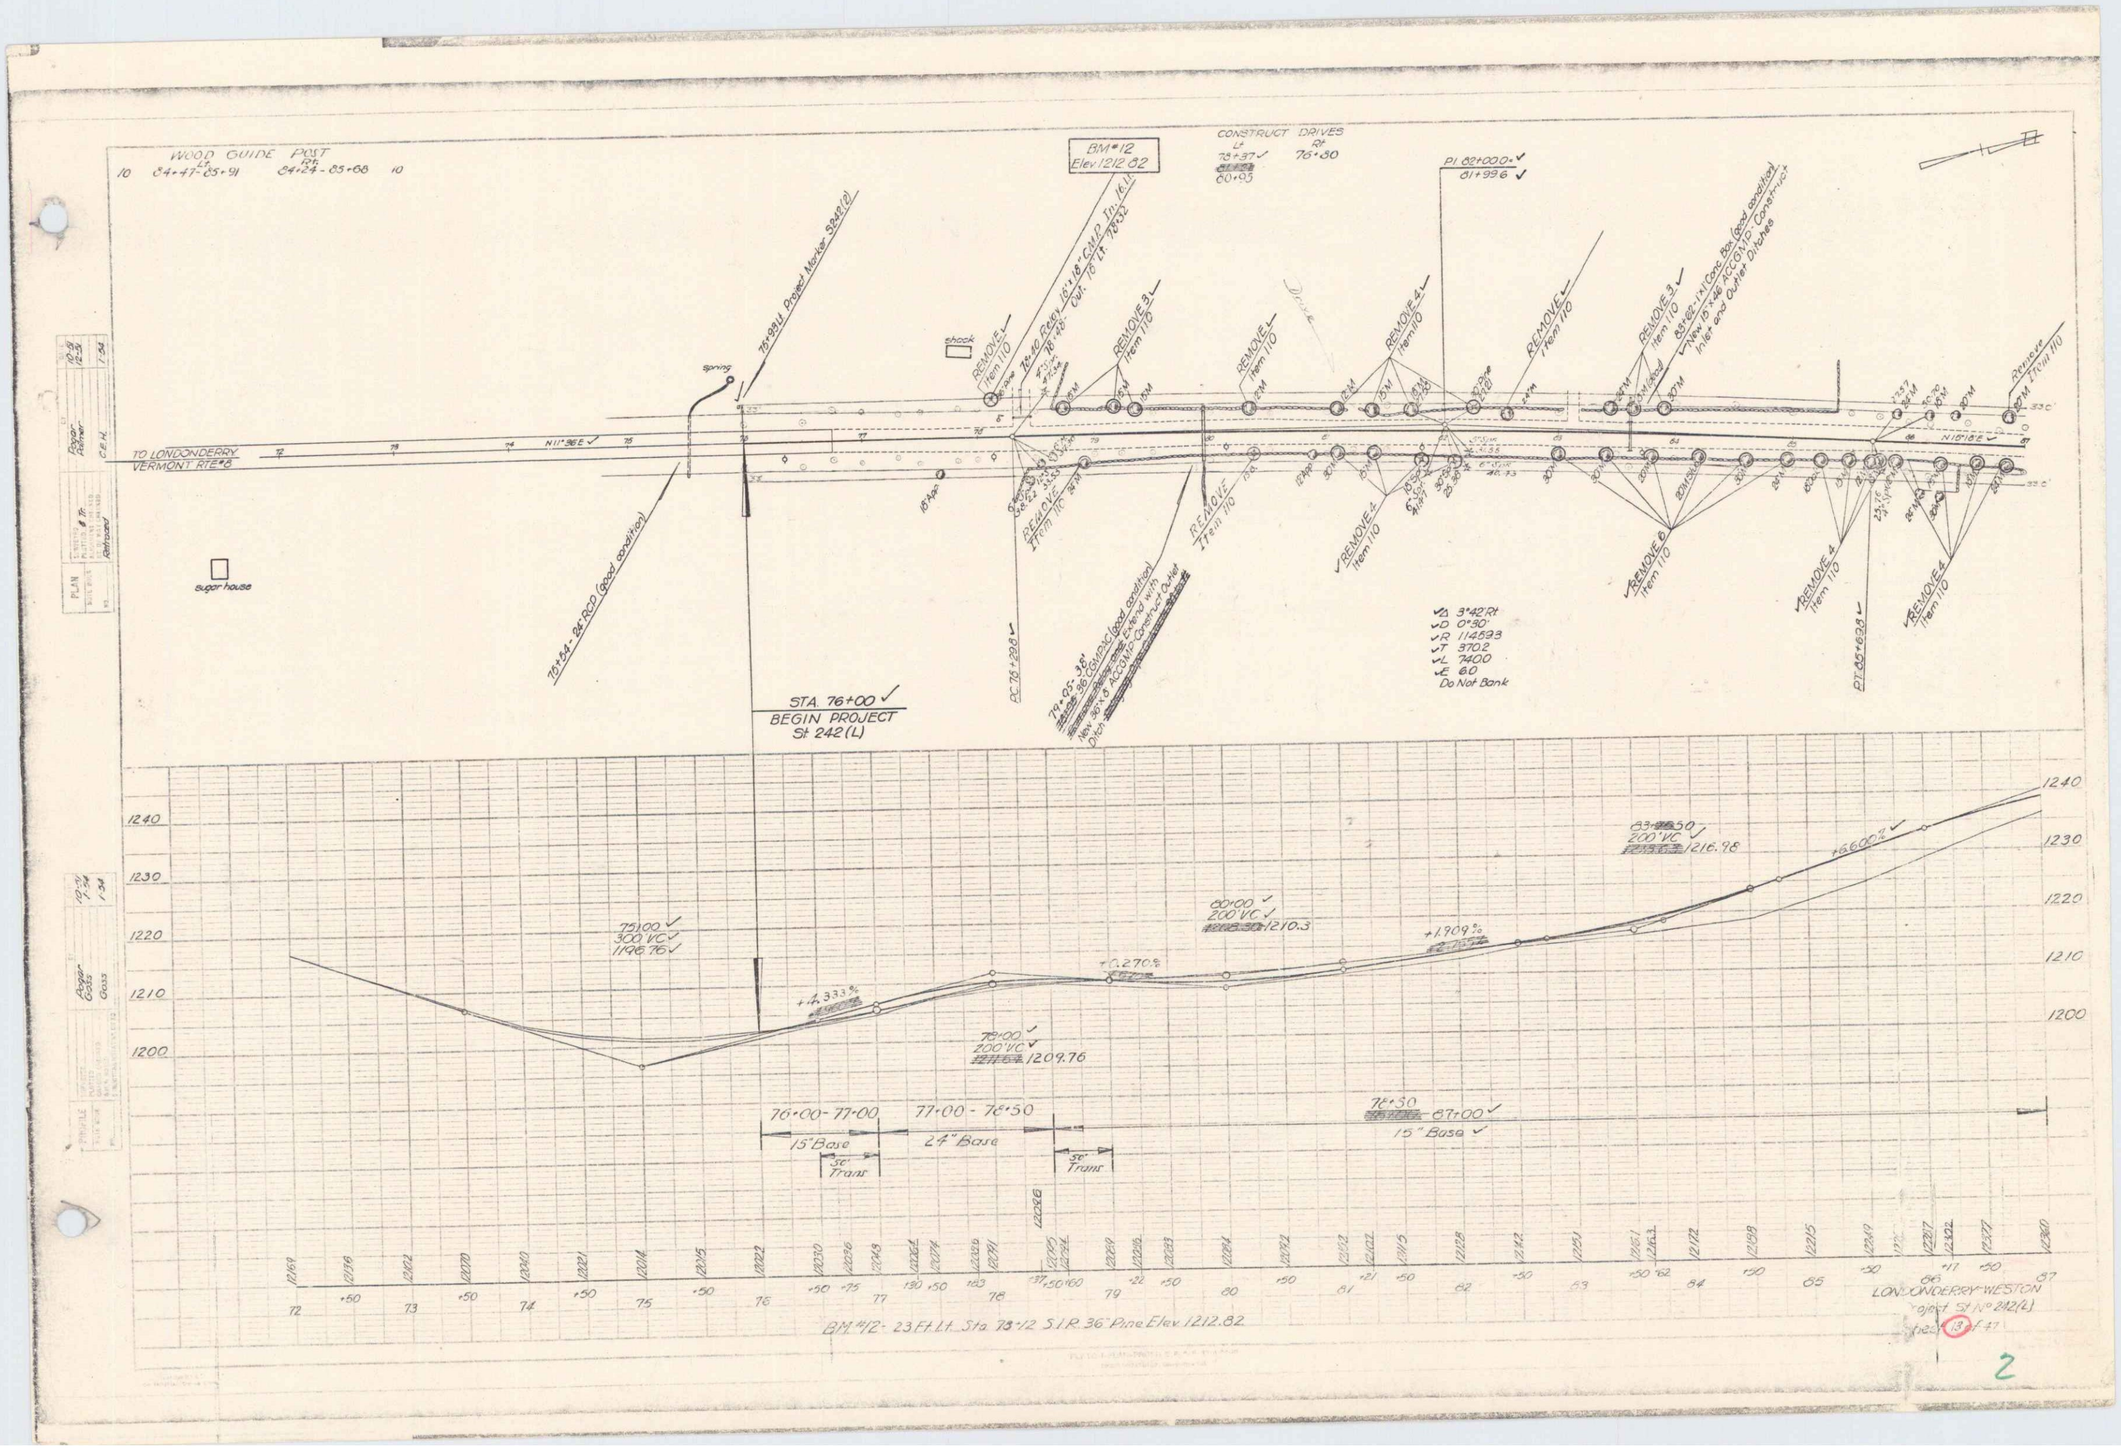
WOOD GUIDE POST
Lt. 84+47-85+91
Rt. 84+24-85+68
BM#12
Elev. 1212.82
CONSTRUCT DRIVES
Lt. 78+37
Rt. 76+80
80+95
PI 82+00.0
81+99.6
TO LONDONDERRY
VERMONT RTE#8
N11°36'E
N15°18'E
sugar house
spring
shack
75+54 - 24" RCP (good condition)
75+93 Lt. Project Marker S242(2)
78+40 Relay 16"x18" CMP In. 16 Lt.
78+48 - Out. 16 Lt. 78+32
79+05 - 38" 36" CGMPAC (good condition)
New 36"x8 ACCGMP - Construct Outlet Ditch
REMOVE Item 110
REMOVE 3 Item 110
REMOVE 4 Item 110
REMOVE 6 Item 110
Remove Item 110
PC 78+29.8
PT 85+69.8
Δ 3°42' Rt
D 0°30'
R 1145.93
T 370.2
L 740.0
E 6.0
Do Not Bank
STA. 76+00
BEGIN PROJECT
St 242(L)
75+00
300' VC
1196.76
+4.333%
78+00
200' VC
1209.76
+0.270%
80+00
200' VC
1210.3
+1.909%
83+50
200' VC
1216.98
+6.600%
76+00 - 77+00
15" Base
50' Trans
77+00 - 78+50
24" Base
50' Trans
78+50 - 87+00
15" Base
BM#12 - 23 Ft. Lt. Sta 78+12 S.I.R. 36" Pine Elev. 1212.82
LONDONDERRY-WESTON
Project St No 242(L)
Sheet 13 of 47
2