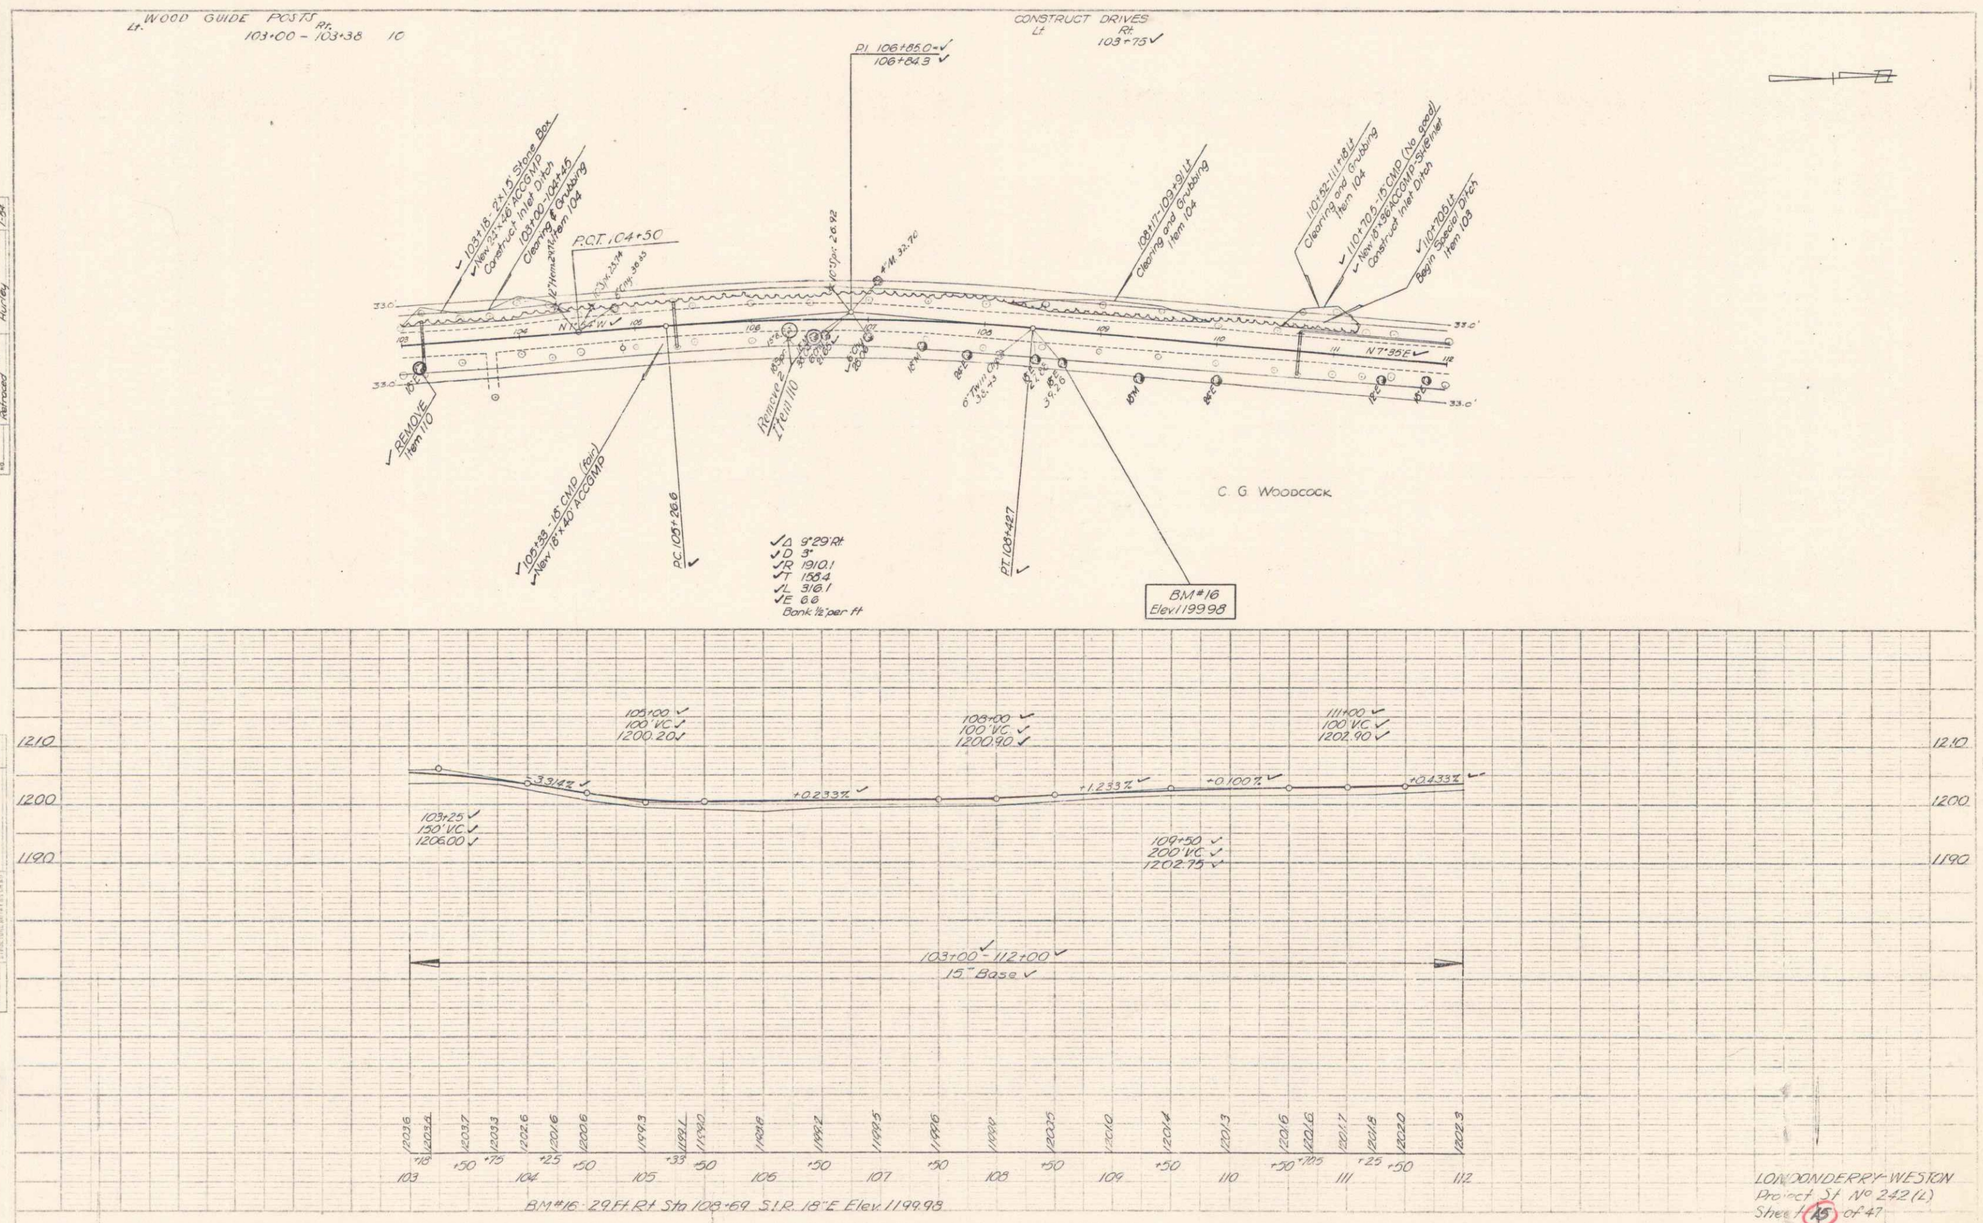
WOOD GUIDE POSTS
Lt. Rt.
103+00 - 103+38 10
CONSTRUCT DRIVES
Lt Rt
103+75
P.I. 106+85.0
106+84.3
P.C.T. 104+50
103+18 - 24" x 18' Stone Box
New 33" x 46' ACCOMP
Construct Inlet Ditch
103+00 - 104+45
Clearing & Grubbing
Item 104
103+11 - 103+31 Lt
Clearing and Grubbing
Item 104
110+82 - 111+81 Lt
Clearing and Grubbing
Item 104
110+70.5 - 15" CMP (No scale)
New 18" x 38' ACCOMP Siphon
Construct Inlet Ditch
110+70 Lt
Begin Special Ditch
Item 108
REMOVE
Item 110
Remove 2
Item 110
105+33 - 18" CMP (Rip)
New 18" x 40' ACCOMP
P.C. 105+26.6
P.T. 107+42.7
Δ 9°29' Rt
D 3°
R 1910.1
T 158.4
L 316.1
E 6.6
Bank ½ per ft
BM #16
Elev. 1199.98
C. G. Woodcock
N 7°35' E
N 7°35' W
33.0'
105+00
100' VC
1200.20
103+00
100' VC
1200.90
111+00
100' VC
1202.90
-3.34%
+0.233%
+1.233%
+0.100%
+0.433%
103+25
150' VC
1206.00
109+50
200' VC
1202.75
1210
1200
1190
103+00 - 112+00
15" Base
BM #16 29 Ft. Rt Sta 103+69 S.I.R. 18" E Elev. 1199.98
LONDONDERRY-WESTON
Project S.P. No 242 (L)
Sheet 15 of 47
4