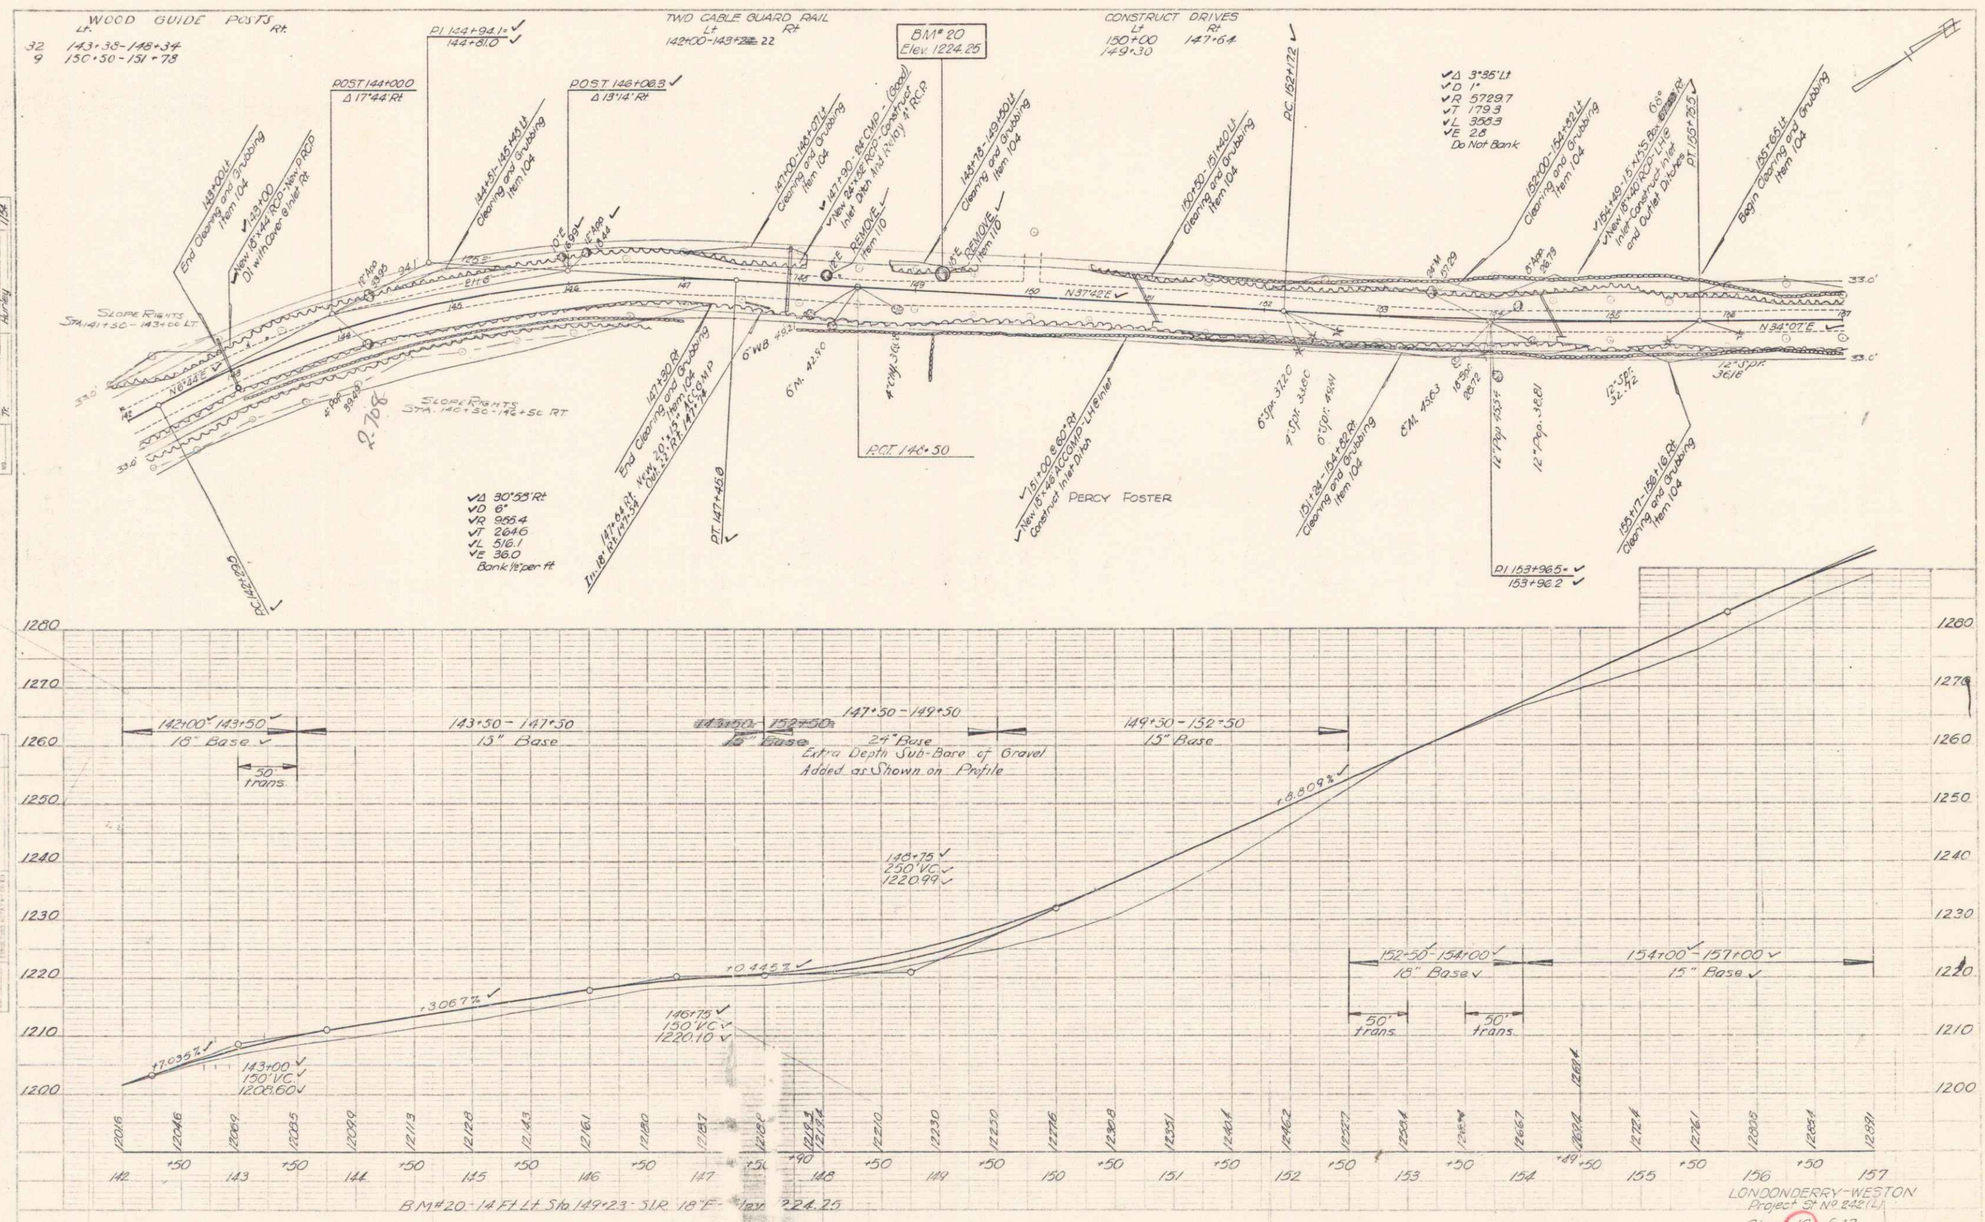
WOOD GUIDE POSTS
Lt. Rt.
32 143+38-148+34
9 150+50-151+78
POST 144+00.0
Δ 17°44' Rt.
PI 144+94.1
144+81.0
POST 146+08.3
Δ 19°14' Rt.
TWO CABLE GUARD RAIL
Lt Rt
142+00-143+22
BM# 20
Elev. 1224.25
CONSTRUCT DRIVES
Lt Rt
150+00 147+64
149+30
Δ 3°35' Lt
D 1°
R 5729.7
T 179.3
L 358.3
E 2.8
Do Not Bank
SLOPE RIGHTS
STA. 141+50 - 143+00 LT.
SLOPE RIGHTS
STA. 146+50 - 148+50 RT.
N 37°42' E
N 34°07' E
PERCY FOSTER
Δ1 30°53' Rt.
D 6°
R 955.4
T 264.6
L 516.1
E 36.0
Bank 1½ per ft
PC 142+22.9
PT 147+48.8
PC 152+17.2
PI 153+96.5
153+96.2
P.O.T. 146+50
Begin Clearing and Grubbing Item 104
End Clearing and Grubbing Item 104
REMOVE Item 110
142+00-143+50
18" Base
50' trans.
143+50 - 147+50
15" Base
147+50 - 149+50
24" Base
Extra Depth Sub-Base of Gravel Added as Shown on Profile
149+50 - 152+50
15" Base
152+50-154+00
18" Base
154+00 - 157+00
15" Base
+7.035%
+3.067%
+0.445%
+8.909%
143+00
150' VC
1208.60
146+75
250' VC
1220.99
146+75
150' VC
1220.10
BM#20 - 14 Ft. Lt. Sta. 149+23 - S.I.R. 18" F - Elev. 1224.25
LONDONDERRY-WESTON
Project St. No. 242(1)
Sheet 19 of 47