

STONE FILL FOR SLOPE PROTECTION  
 LT (LIGHT TYPE) RT  
 70+75-71+25 60+25-65+25  
 71+75-74+00 66+75-67+75  
 70+82-74+50 60+75-66+00

UNCLASSIFIED CHANNEL EXCAVATION  
 LT RT  
 71+75-74+00 60+25-65+25  
 70+82- 66+75-67+75  
 60+75-65+00



TREATED TIMBER CURB  
 RT  
 60+00-63+50

PAVED SHOULDER  
 (Item 315)  
 RT  
 60+00-63+50

TWO CABLE GUARD RAIL  
 LT RT  
 60+00-64+00 60+00-71+00  
 70+50-74+00 60+00-71+03  
 60+00-64+20  
 70+60-74+00

CONSTRUCT DRIVE  
 LT RT  
 67+00 73+30

DRILLING AND BLASTING OF  
 SOLID ROCK SUBGRADE  
 65+00 - 66+50

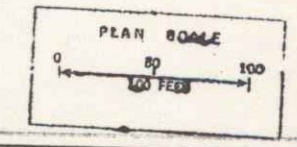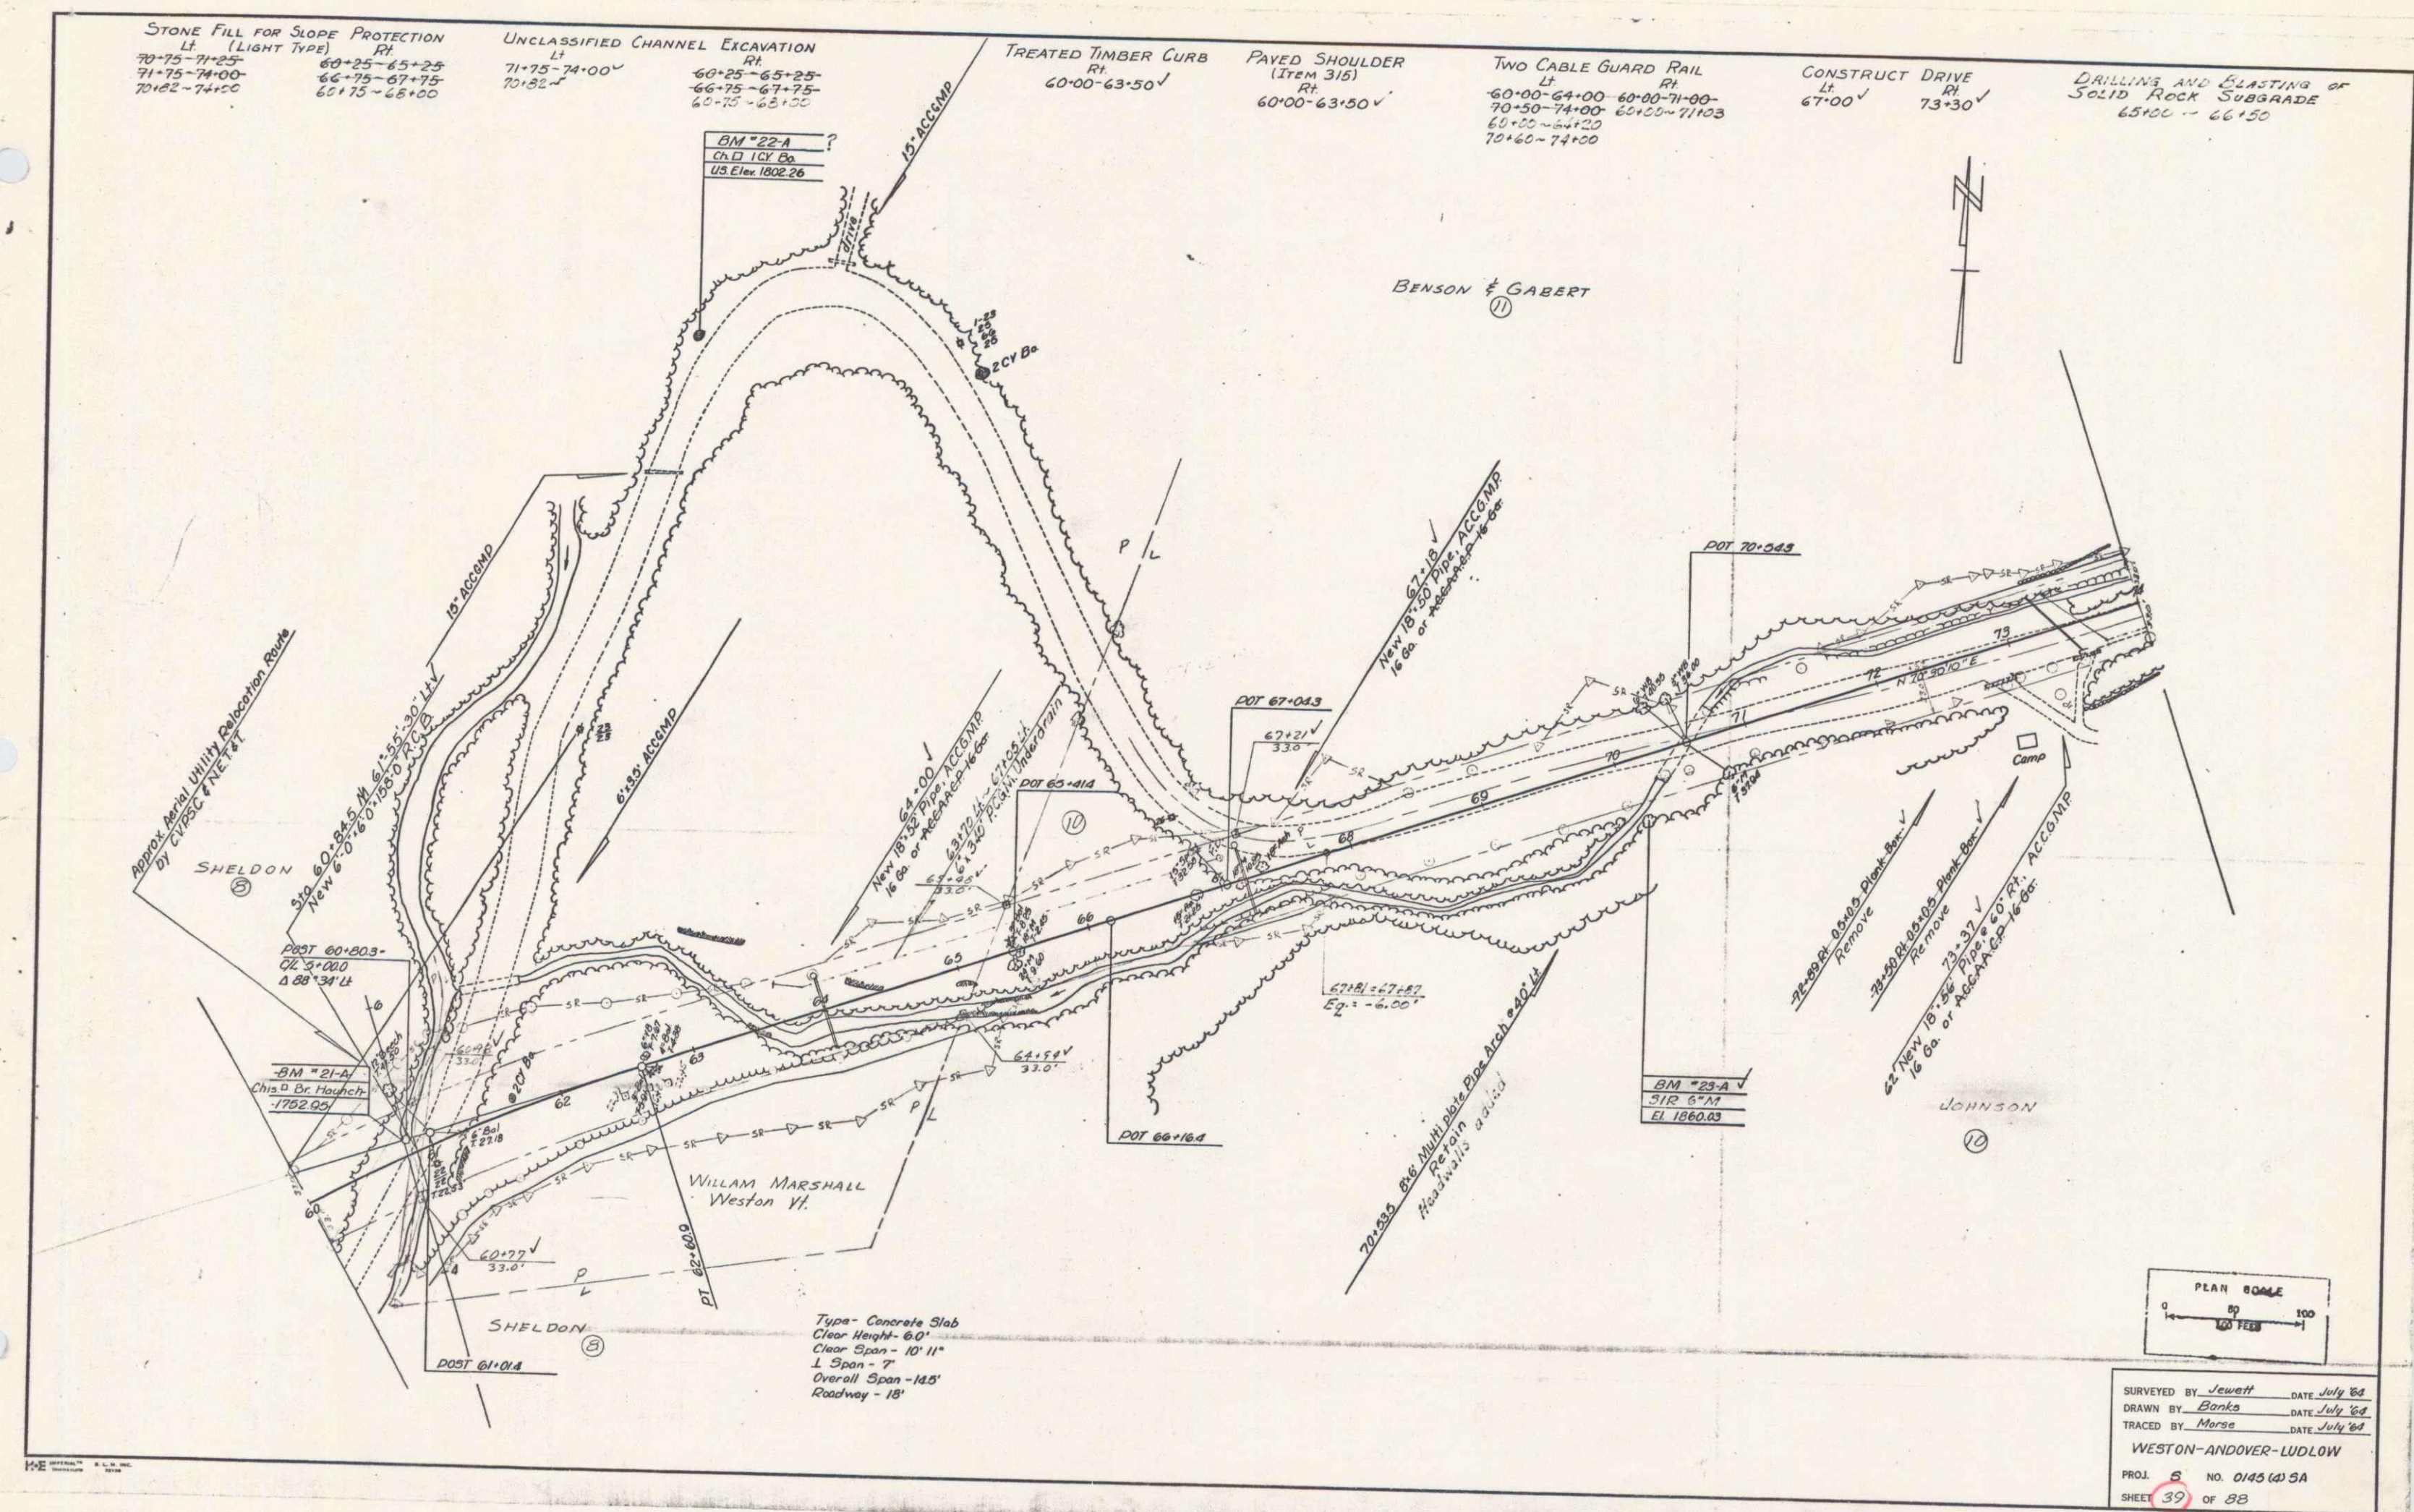

SURVEYED BY: Jewett DATE: July 68  
 DRAWN BY: Banks DATE: July 68  
 TRACED BY: Morse DATE: July 68  
 WESTON-ANDOVER-LUDLOW  
 PROJ. NO. 0145 (4) 5A  
 SHEET 39 OF 88