

CONSTRUCT DRIVE  
Lt. Rt.  
98+50 91+35  
95+90 100+75  
97+50 104+75  
96+35

TWO CABLE GUARD RAIL  
Lt.  
90+00-92+90 35+20  
101+30-102+30


TREATED TIMBER CURB  
Lt.  
91+50-92+90 93+25  
102+00-104+56  
101+72-106+00

PAVED SHOULDER  
(ITEM 315)  
Lt.  
91+50-92+90 93+25  
102+00-104+56  
101+72-106+00

WOOD-GUIDE POSTS-16'-6"  
Lt.  
102+00-104+56

ABROMATES

H.C. JAQUITH & Co.  
Weston Vt.

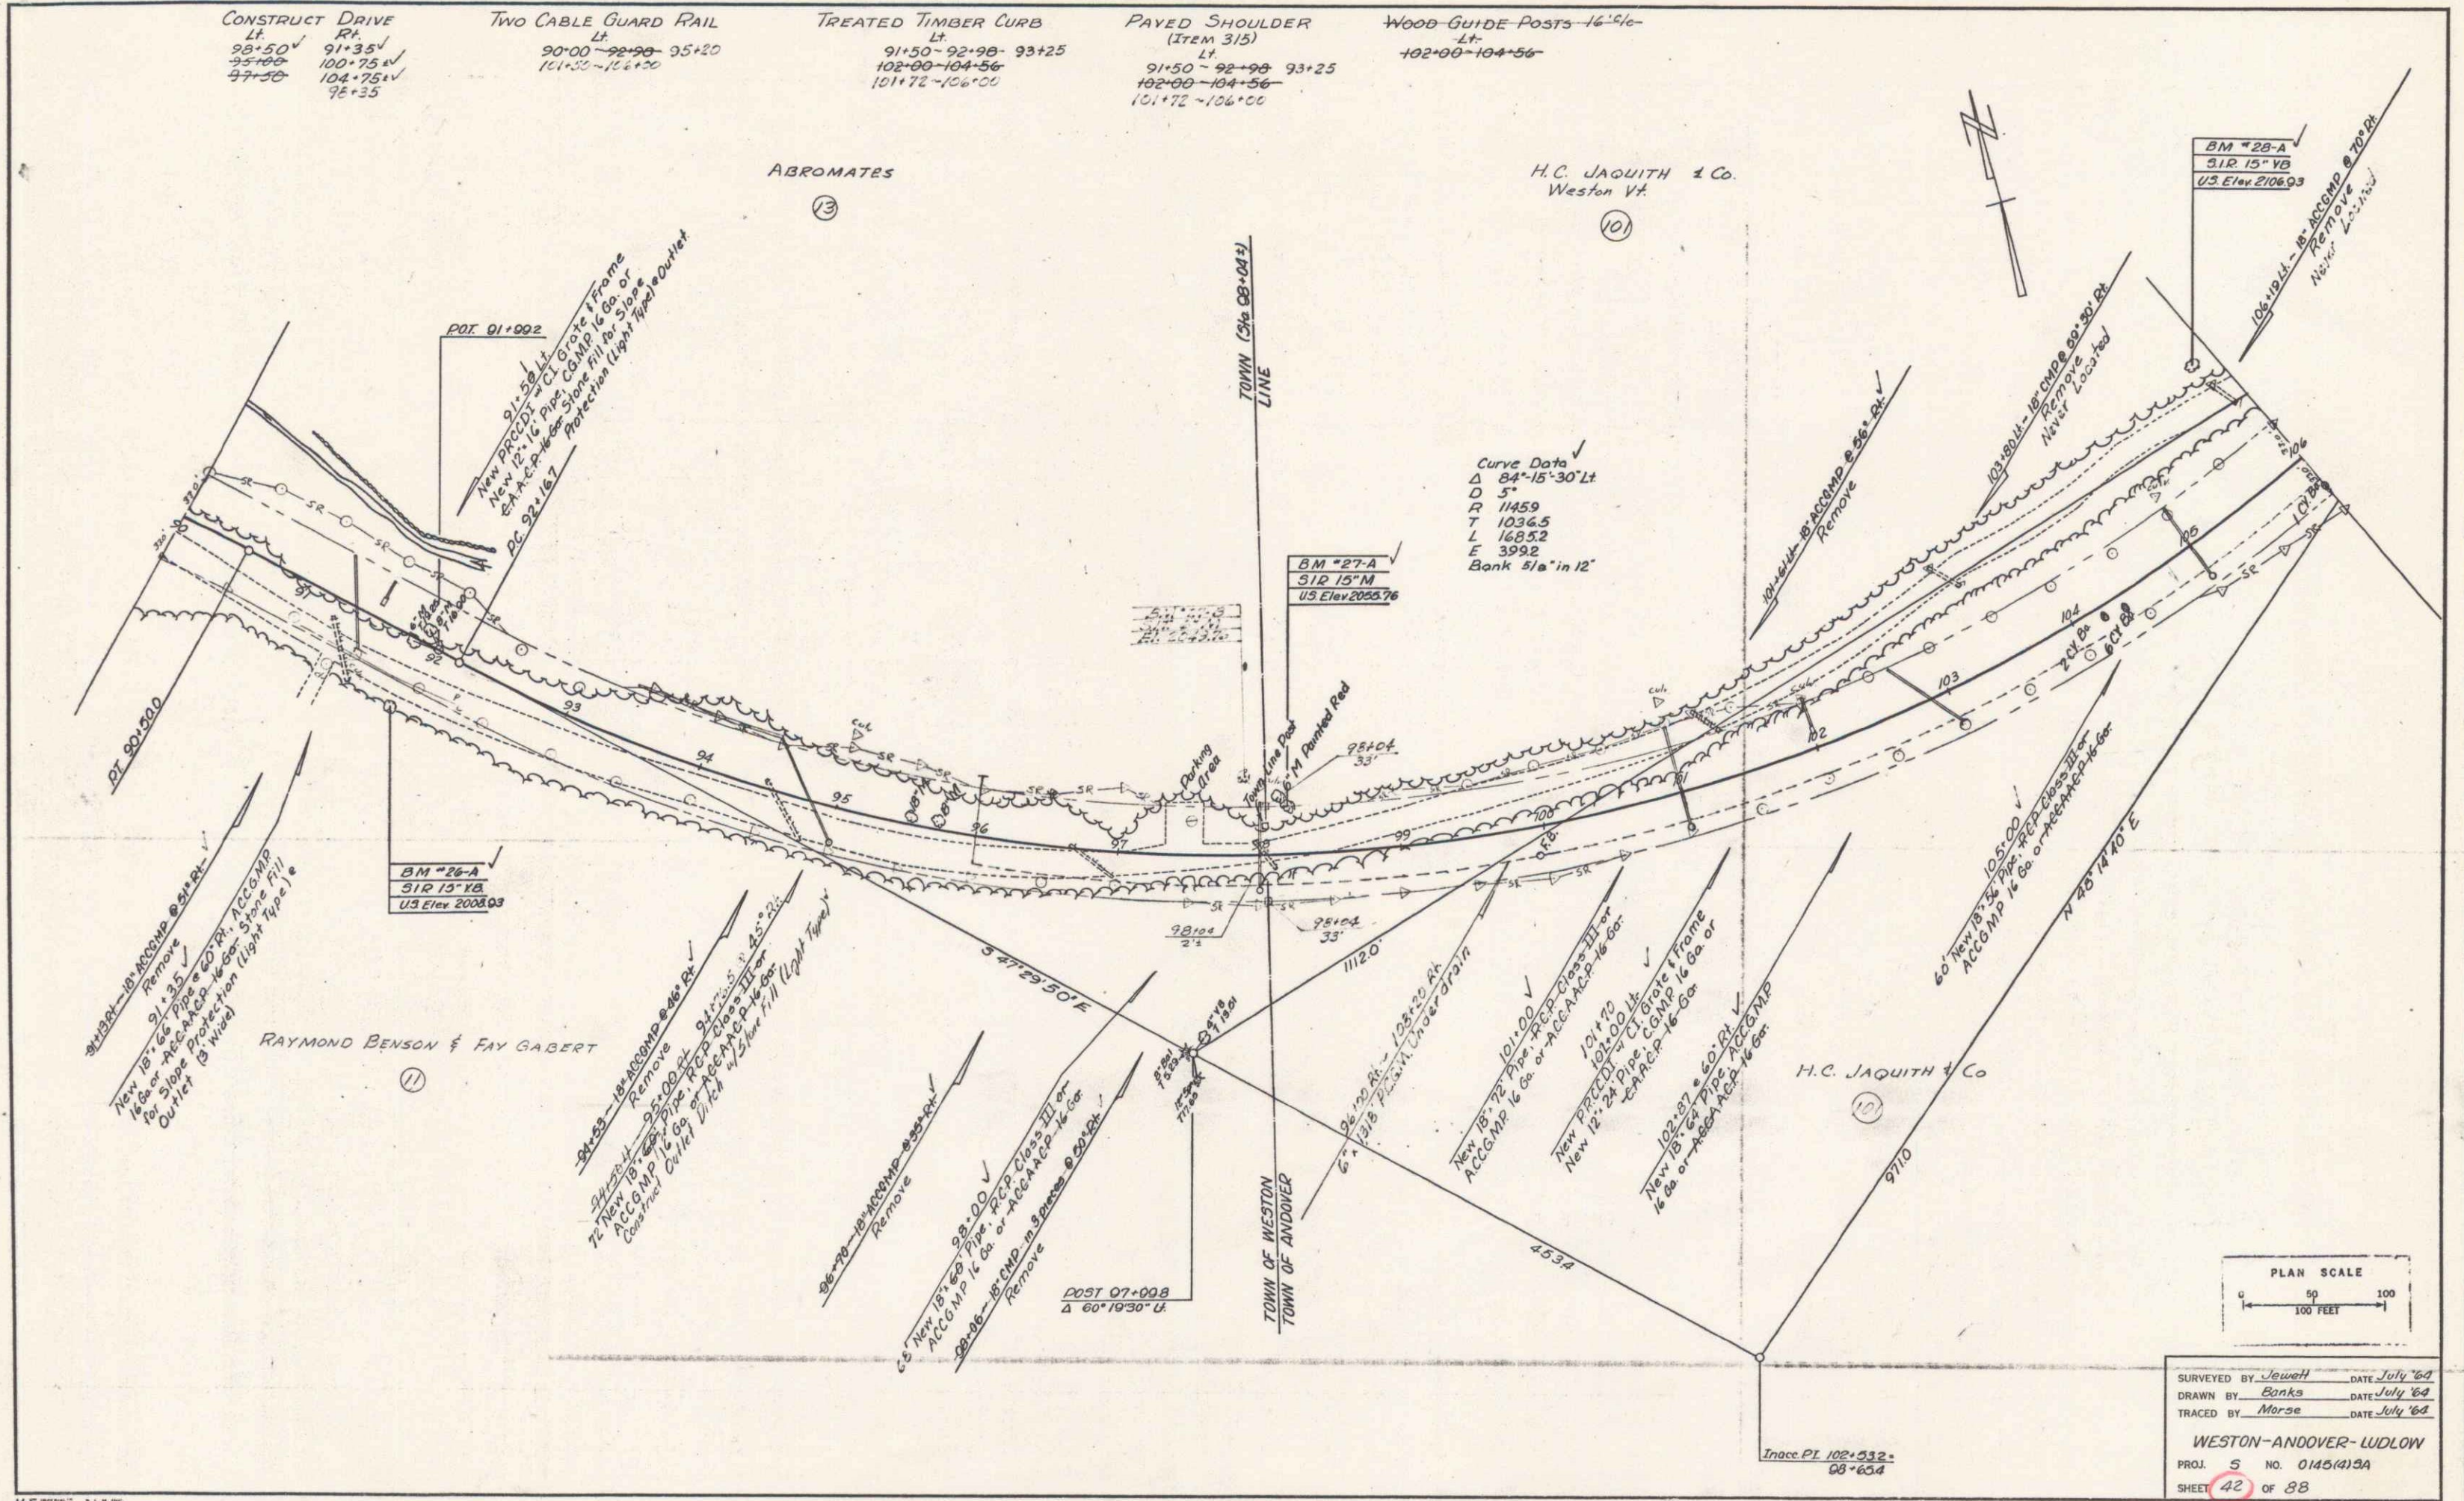

Curve Data  
Δ 84°-15'-30" Lt  
D 5'  
R 1145.9  
T 1036.5  
L 1685.2  
E 399.2  
Bank 5/8" in 12"

PLAN SCALE  
0 50 100  
100 FEET

SURVEYED BY *Jawett* DATE July '64  
DRAWN BY *Banks* DATE July '64  
TRACED BY *Morse* DATE July '64  
WESTON-ANDOVER-LUDLOW  
PROJ. 5 NO. 0145(4)3A  
SHEET 42 OF 88