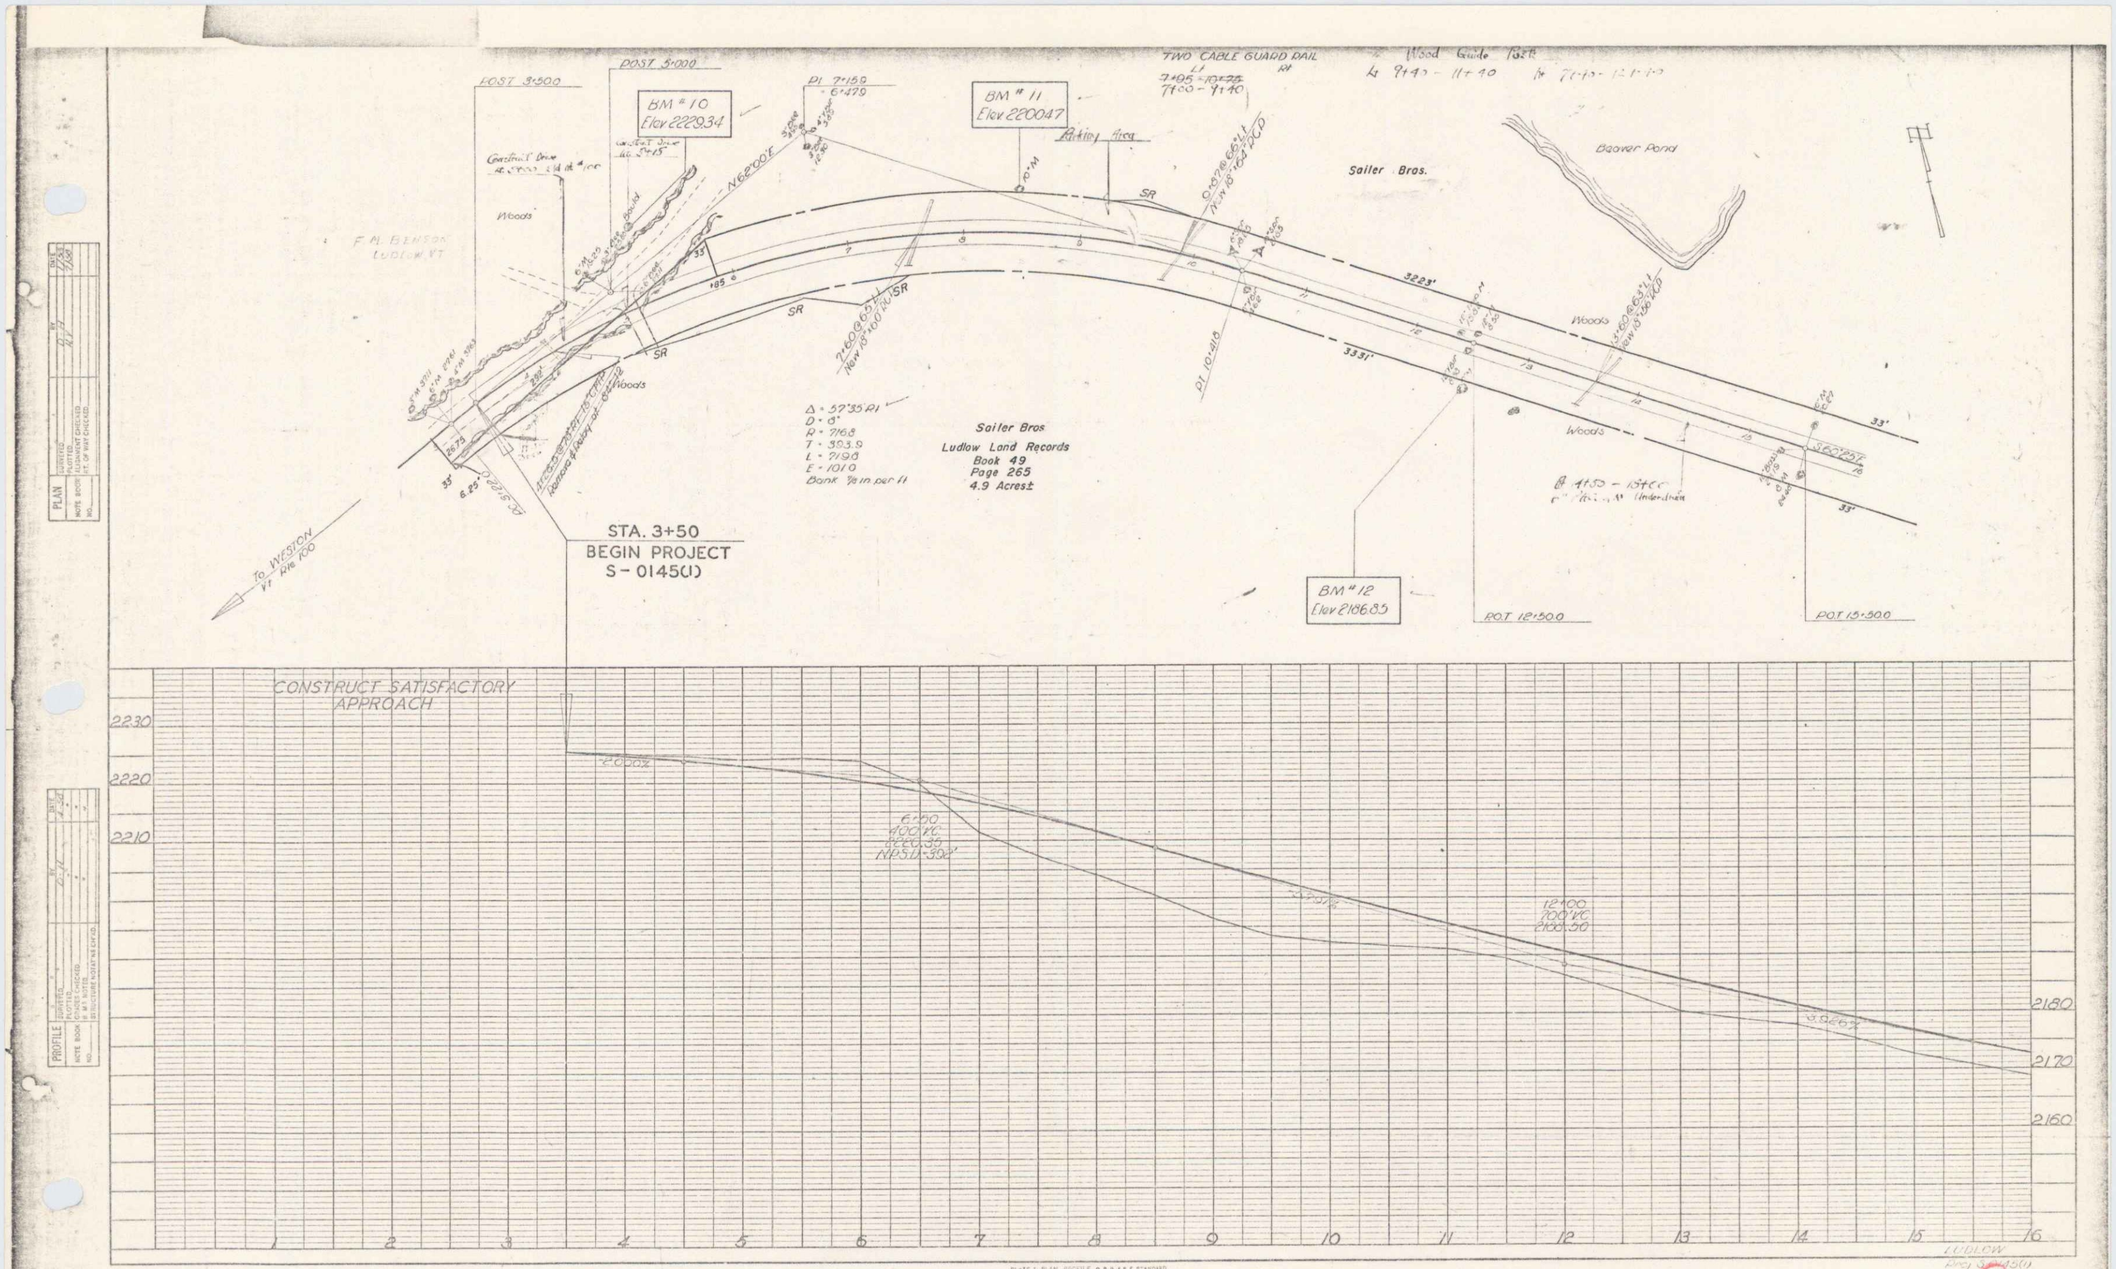
TWO CABLE GUARD RAIL
Wood Guide Post
POST 3+00
POST 5+00
BM # 10
BM # 11
Parking Area
Beaver Pond
Sailer Bros.
F. M. BENSON
LUDLOW VT
Woods
SR
Δ = 57°35' Rt
D = 8°
R = 716.8
T = 393.9
L = 719.8
E = 101.0
Bank ½ in. per ft
Sailer Bros
Ludlow Land Records
Book 49
Page 265
4.9 Acres±
STA. 3+50
BEGIN PROJECT
S-0145(1)
To WESTON
BM # 12
POT 12+50.0
POT 15+50.0
CONSTRUCT SATISFACTORY
APPROACH
2230
2220
2210
2180
2170
2160
2.00%
6+00
400 VC
NB SD-302'
12+00
0.50%
1
2
3
4
5
6
7
8
9
10
11
12
13
14
15
16
PLAN
PROFILE
LUDLOW
PROJECT S-0145(1)

3